

ACTUAL FIELD TOPOGRAPHIC SURVEY MADE BY ME ON THE 26<sup>th</sup> DAY OF NOV. 1989 AND THAT AS OF THAT DATE THE ELEVATION EXISTED AS SHOWN HEREON

JMPK


30 NOV 1989  
 SCALE 1" = 20 FT.  
 REV. 10/21/91 JWP

SEWAGE DISPOSAL PERMIT MUST BE OBTAINED BY A LAKE COUNTY LICENSED INSTALLER BEFORE INSTALLATION IS STARTED.

LOW YIELD WATER FIXTURES REQUIRED ON ALL  
 Toilet  
 Shower Head



REVIEWED AND ACCEPTED  
 LAKE COUNTY GENERAL HEALTH DISTRICT  
 Date 10.24.91  
 No permits issued  
 No change installed  
 JOEL LUDIA, R.S., M.P.H.  
 Health Commissioner  
 BY N. Nicks

- A. To be brought to finished grade
- 1. Septic tank manhole covers
- 2. Splitter box cover
- 3. Distribution box cover
- B. The leach drains or leachouts to be discharged into septic tanks
- C. All waste water to be discharged into septic tanks

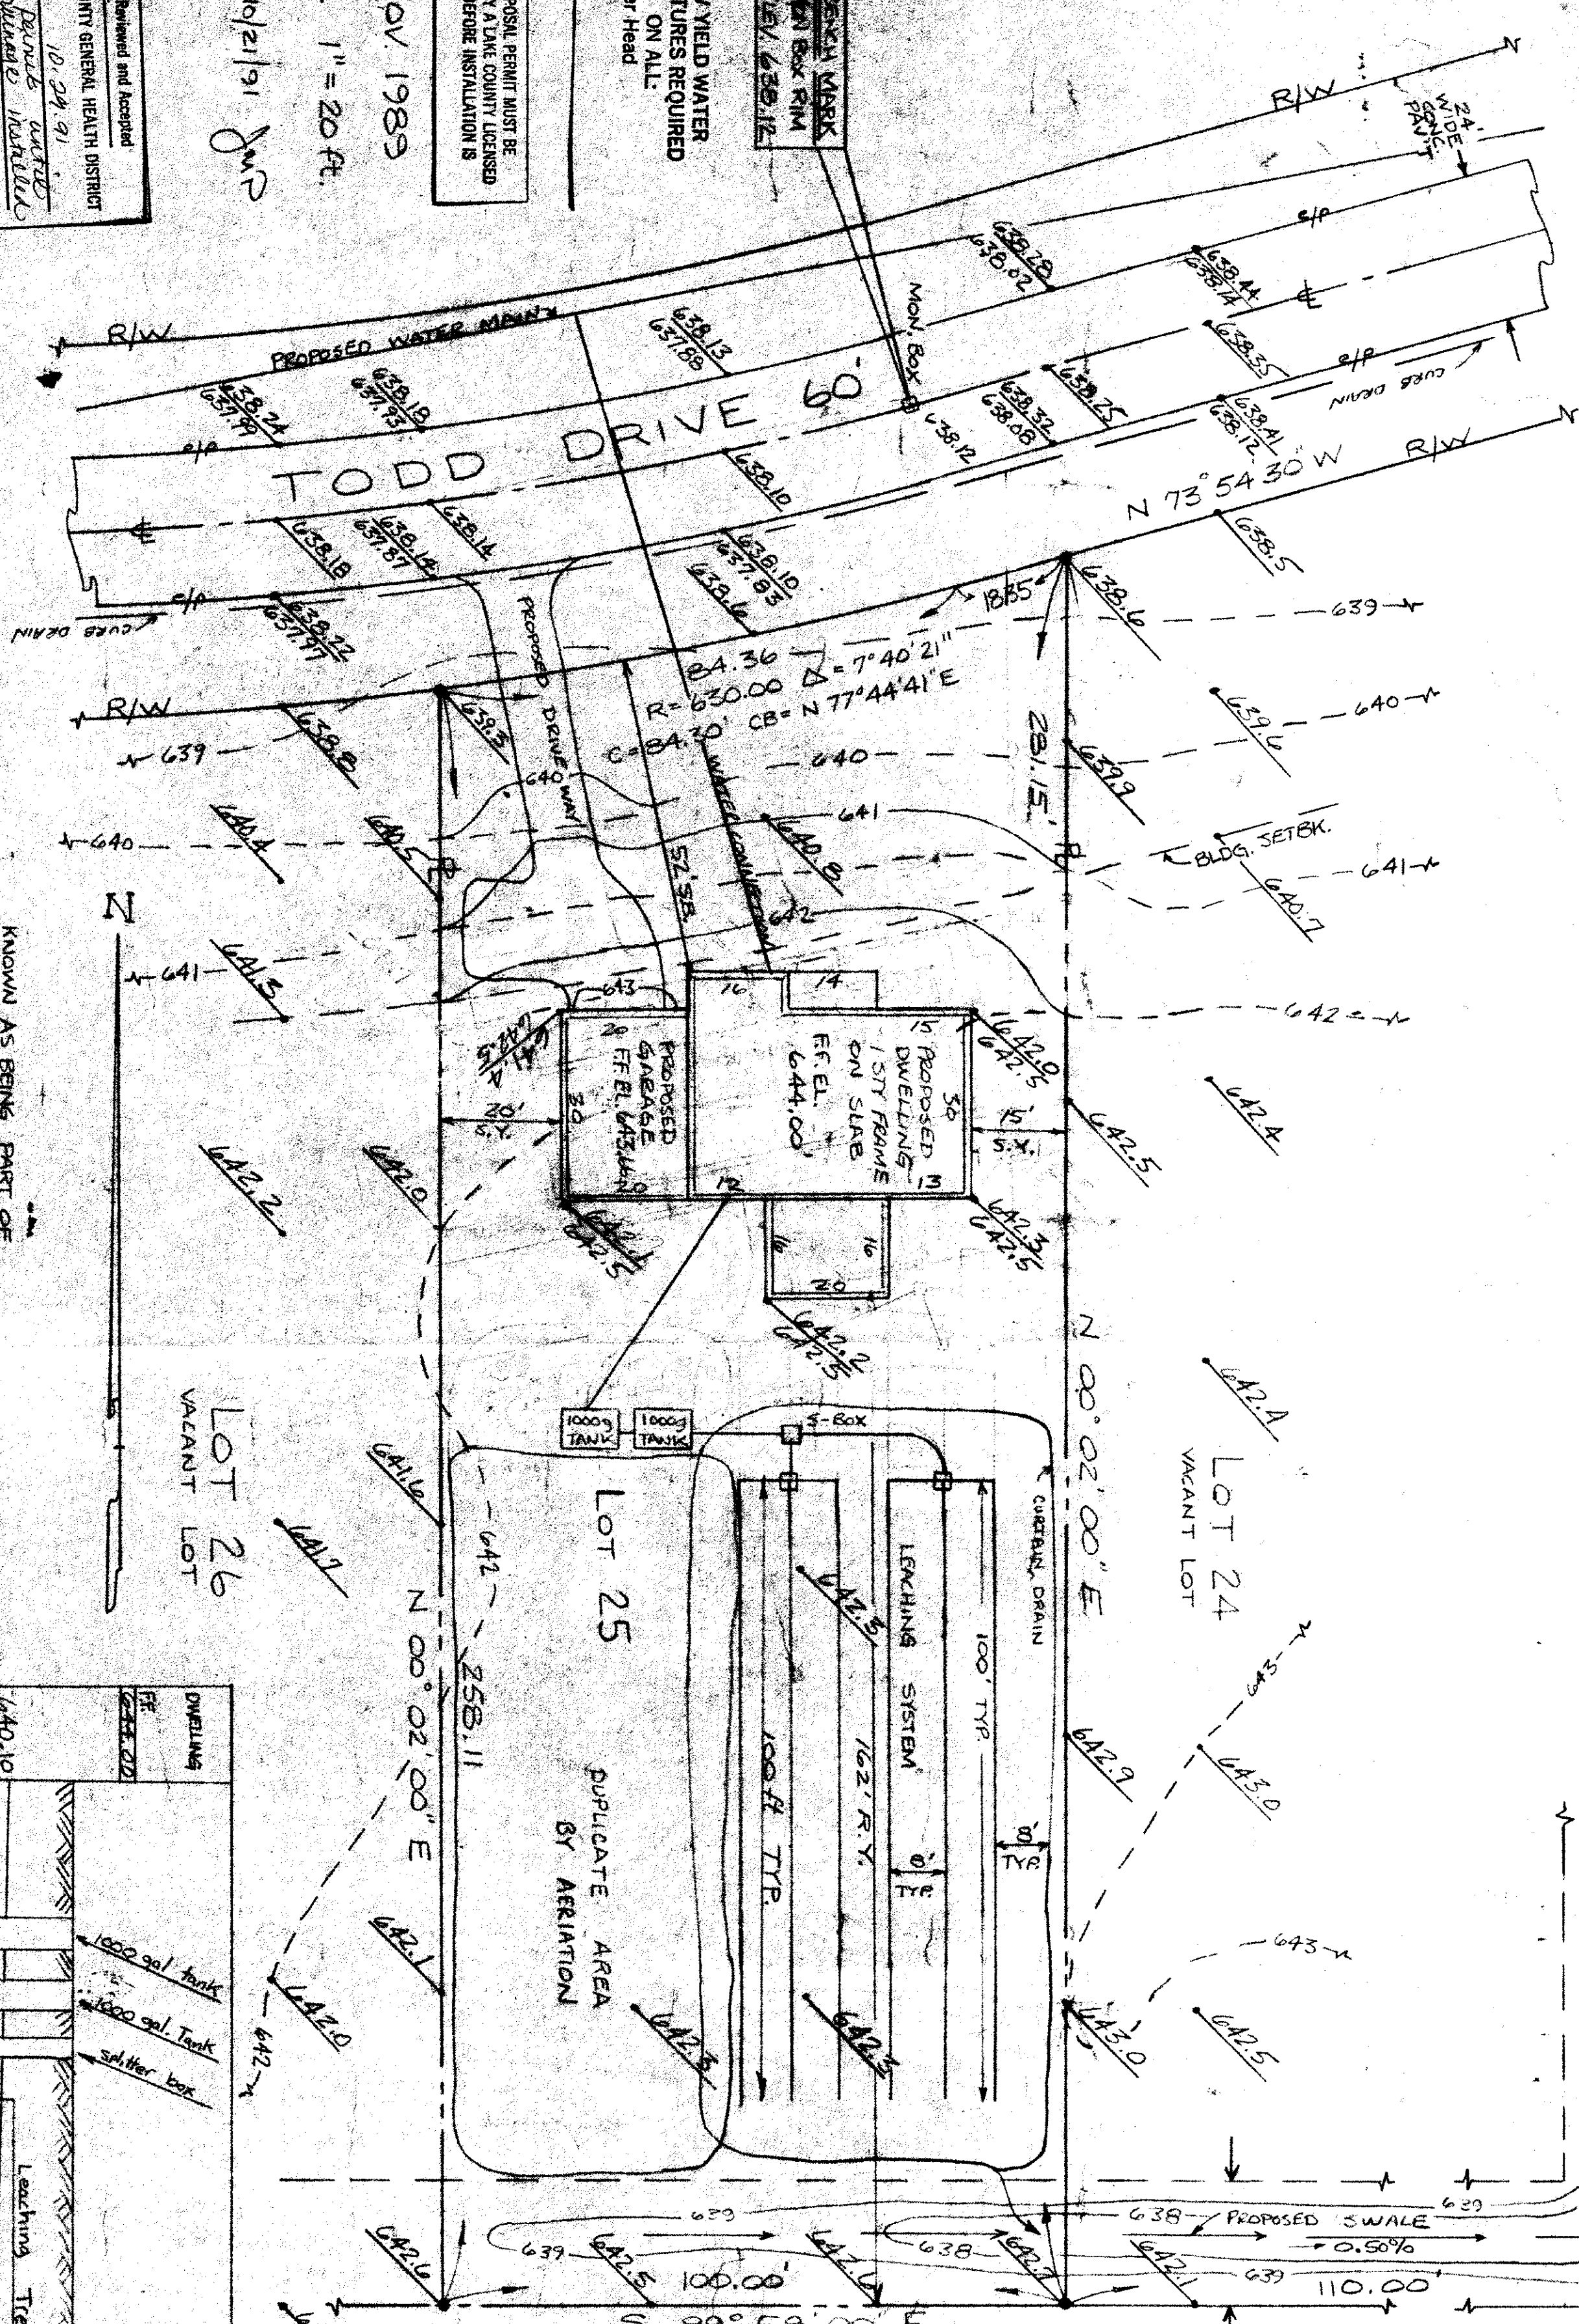


KNOWN AS BEING PART OF  
 MADISON - TOWNLINE ESTATES  
 MADISON TOWNSHIP LAKE CO. O.

SITE PLAN  
 For  
 JOE WELSH

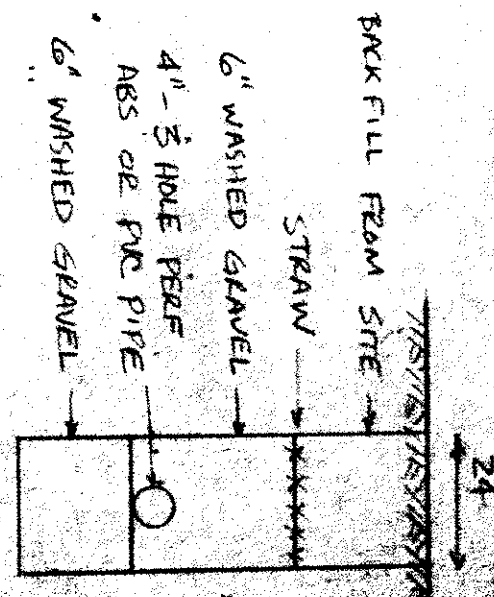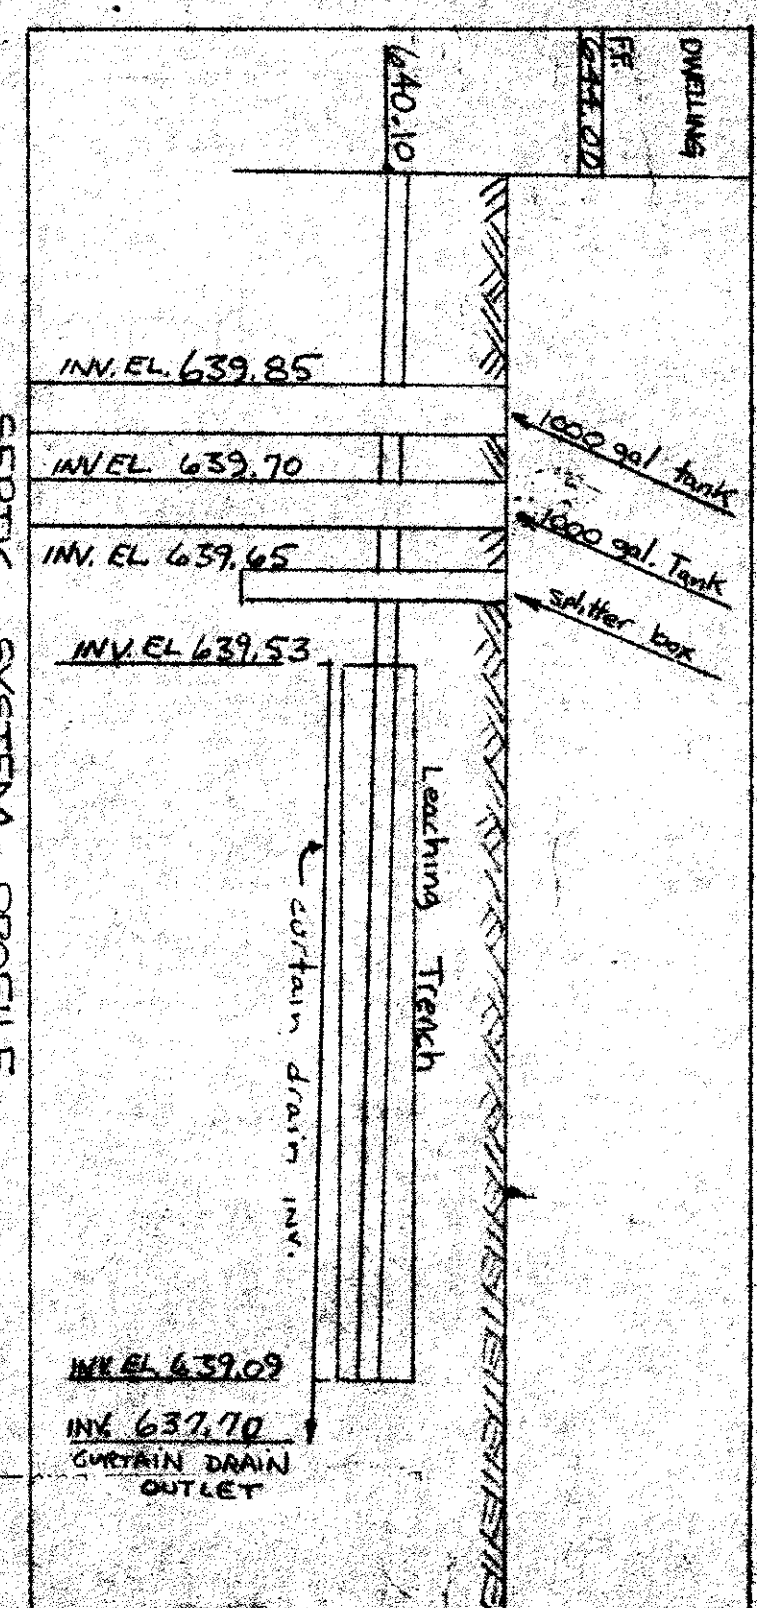

Grading Plan Approved  
 as shown and/or noted  
 THOMAS P. GILLES, P.E.  
 Lake County Engineer  
 Date 11/18/89

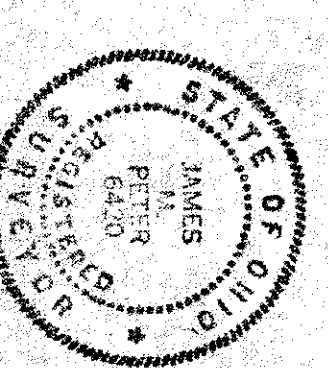

Jim Peter  
 Land Surveyor  
 4759 Crosby Look  
 Rome, Ohio

891108