



NOTE:
EXISTING STREAM
BED TO BE CLEANED
AND MOVED SOUTH
INTO DRAINAGE
EASEMENT,
ROCK CHANNEL
PROTECTION
PROPOSED,
DUPLICATION AREA
APPROX. 20-25 FT
NORTH OF PROPOSED
TOP OF CHANNEL
BANK.

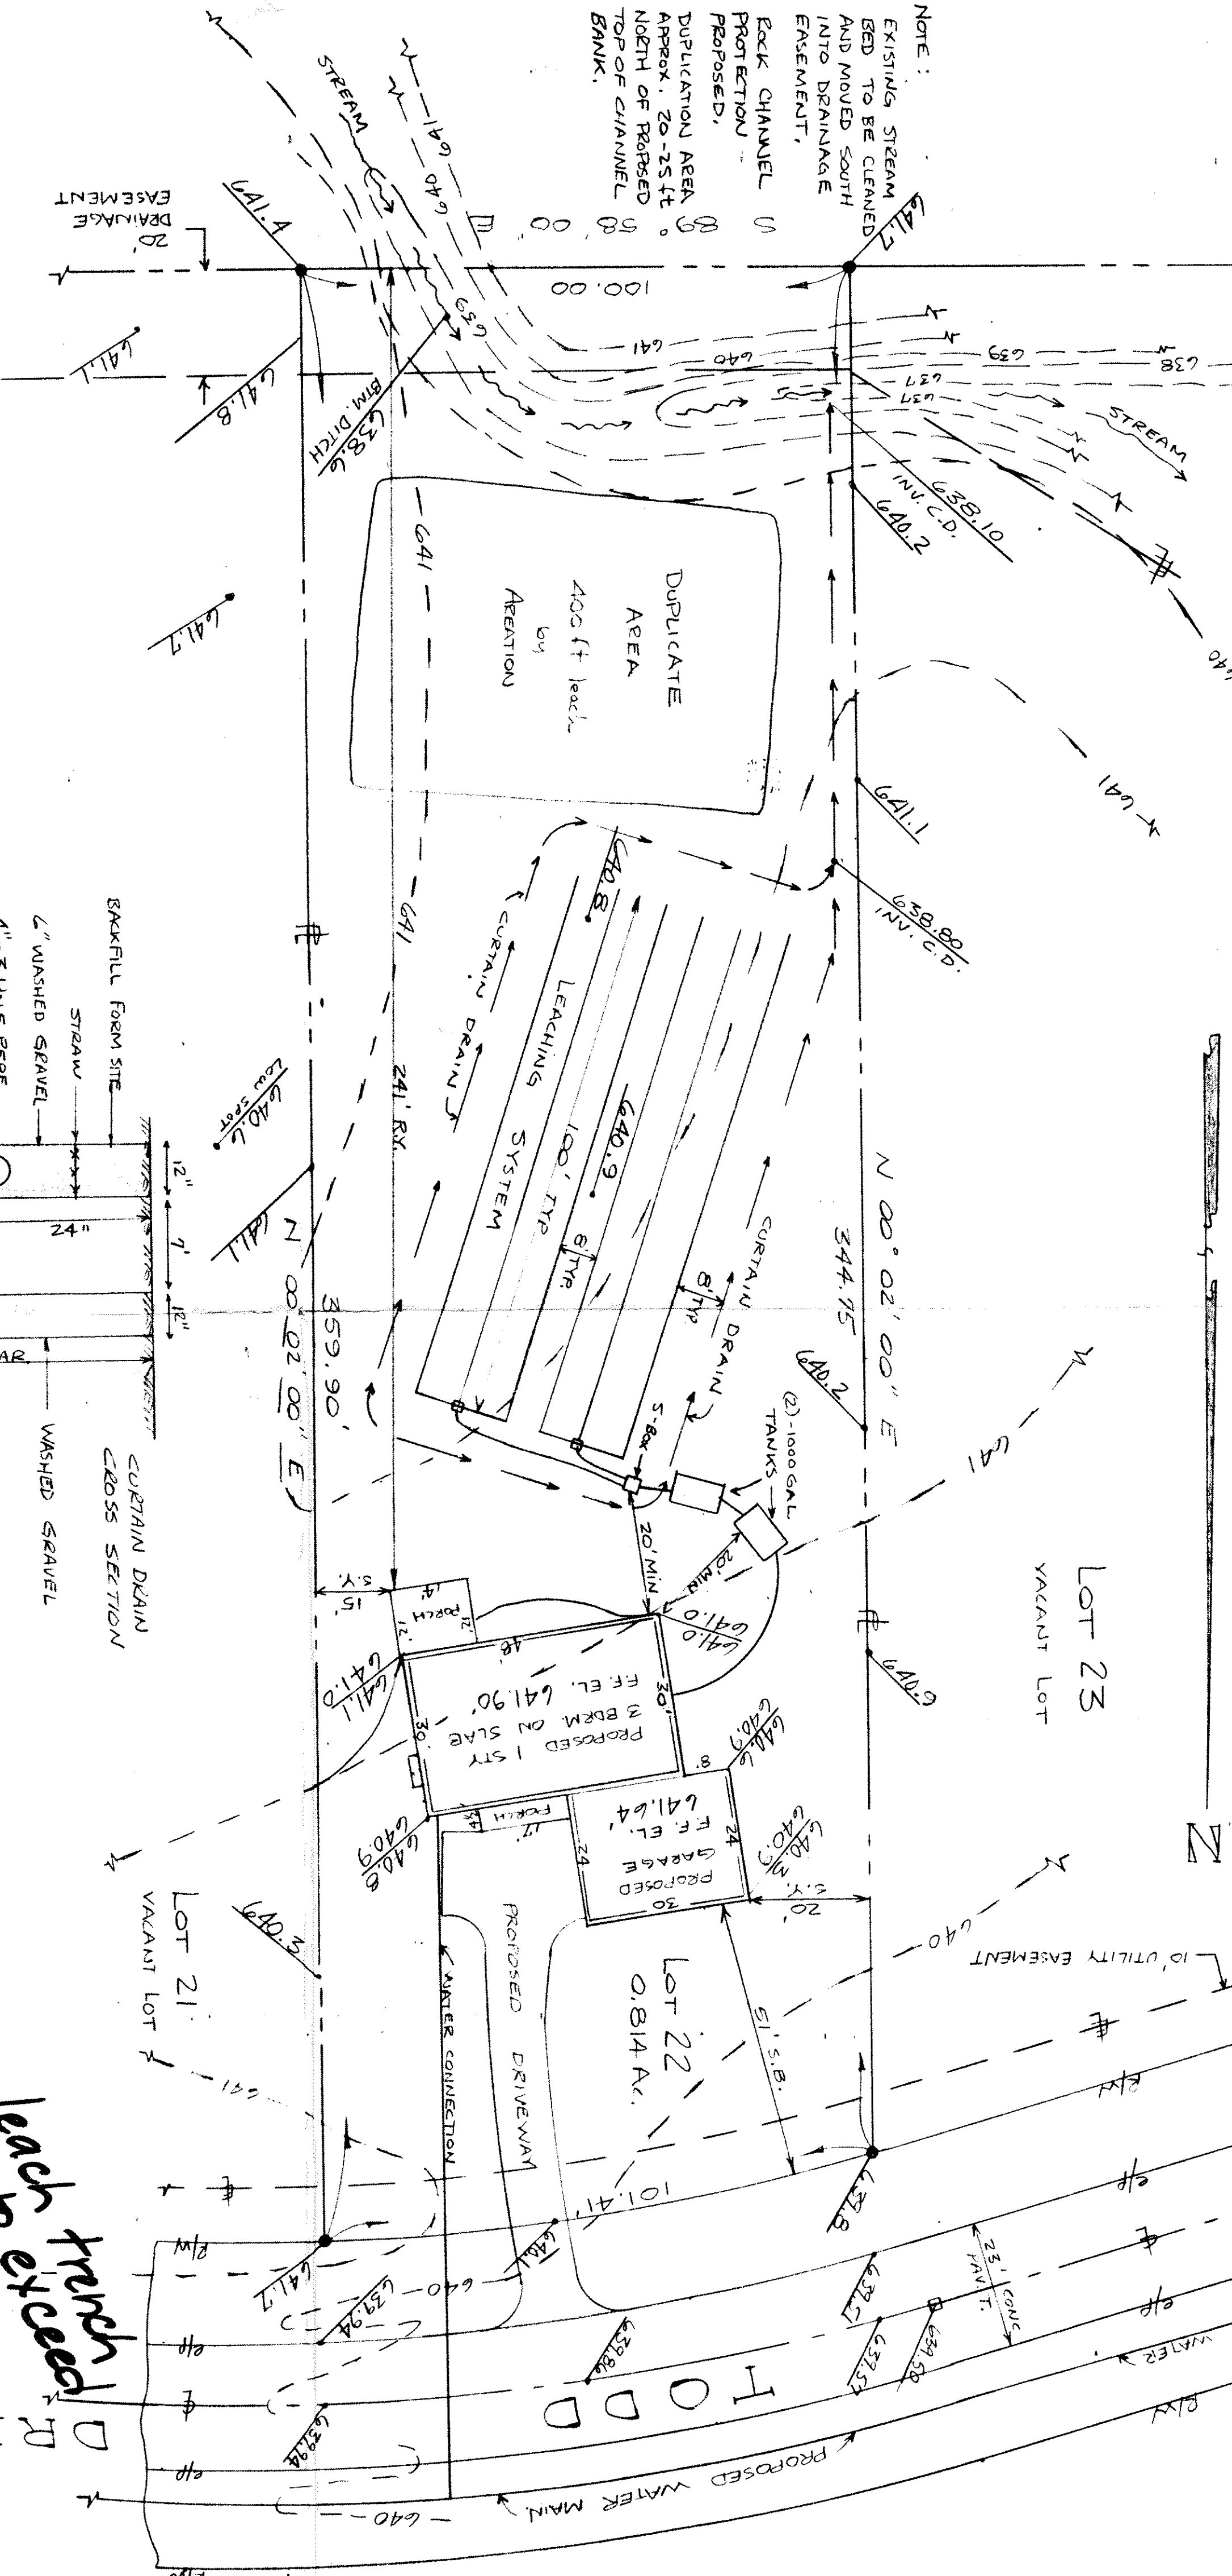

I, THE UNDERSIGNED
HEREBY CERTIFY THAT THE
TOPOGRAPHY SHOWN HEREON
INDICATED BY ONE FOOT
CONTOURS & ELEVATIONS
REPRESENTS AN ACTUAL
FIELD TOPOGRAPHIC SURVEY
MADE BY ME ON THE 15th
DAY OF JULY, 1991, AND
THAT AS OF THAT DATE
THE ELEVATIONS WERE
TAKEN AT APPROPRIATE
INTERVALS AND THAT
THEY EXISTED AS
SHOWN HEREON.

Grading Plan Approved
as shown and/or noted
THOMAS P. GILLES, PROJECT
Lake County Engineer
Date: 7/25/91
By: SEE WASTE SYSTEM

639.45 INV. IN
639.29 INV. OUT
639.21 INV. IN
639.05 INV. OUT
639.0 INV. IN
1000 GAL. TANK
1000 GAL. TANK
5-Box

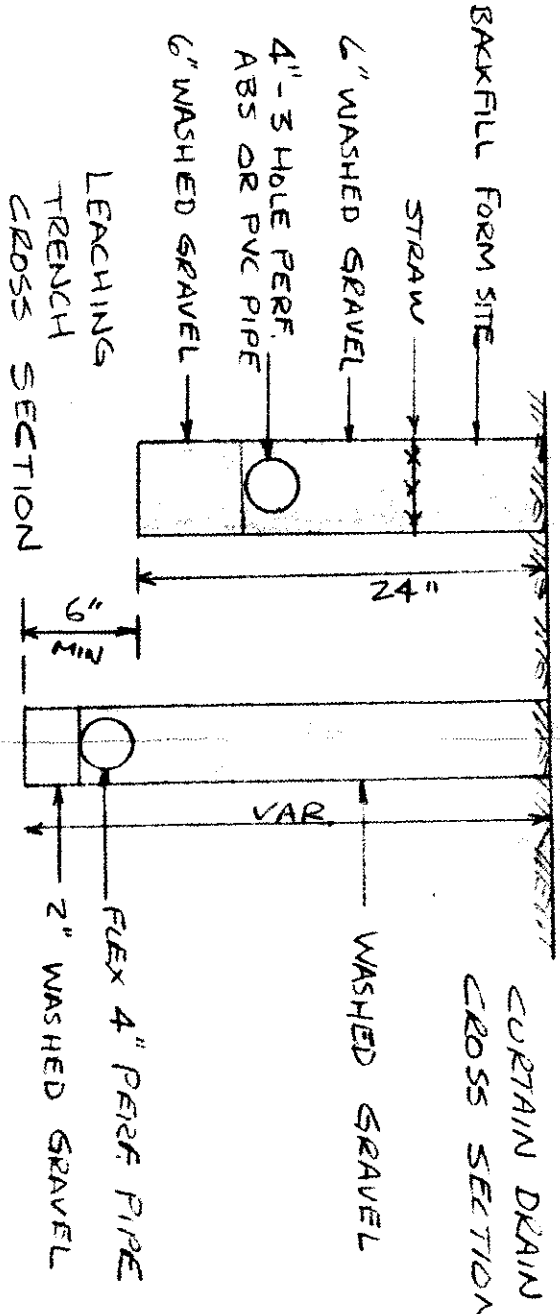

SEPTIC SYSTEM PROFILE

638.1 INV. C.D.
638.80 INV.

SEWAGE DISPOSAL PERMIT MUST BE
OBTAINED BY A LAKE COUNTY LICENSED
INSTALLER BEFORE INSTALLATION IS
STARTED.

LOW YIELD WATER
FIXTURES REQUIRED
ON ALL:

- Shower Head
- Toilet

4759 Greasy Creek Rd.

Jim Peter Land Survey

APPROVED
MADISON TWP. ZONING
DEBIE
JUL 30 1991

17 JULY, 1991
SCALE 1" = 20 FT

leach trench
not 24" deep

BENCH MARK
M.S. RIM
ELEV. 641.21

LAKE COUNTY GENERAL HEALTH DISTRICT
Date: 7/25/91

JOEL LUCIA, R.S., M.P.H.
Health Commissioner