


TOPOGRAPHY SHOWN HEREON, INDICATED BY ONE FOOT CONTOURS & ELEVATIONS, REPRESENTS AN ACTUAL FIELD TOPOGRAPHIC SURVEY MADE BY ME ON THE 1ST DAY OF MARCH 1996 AND THAT THE ELEVATIONS WERE TAKEN AT APPROPRIATE INTERVALS AND THAT AS OF THAT DATE THEY EXISTED AS SHOWN HEREON.

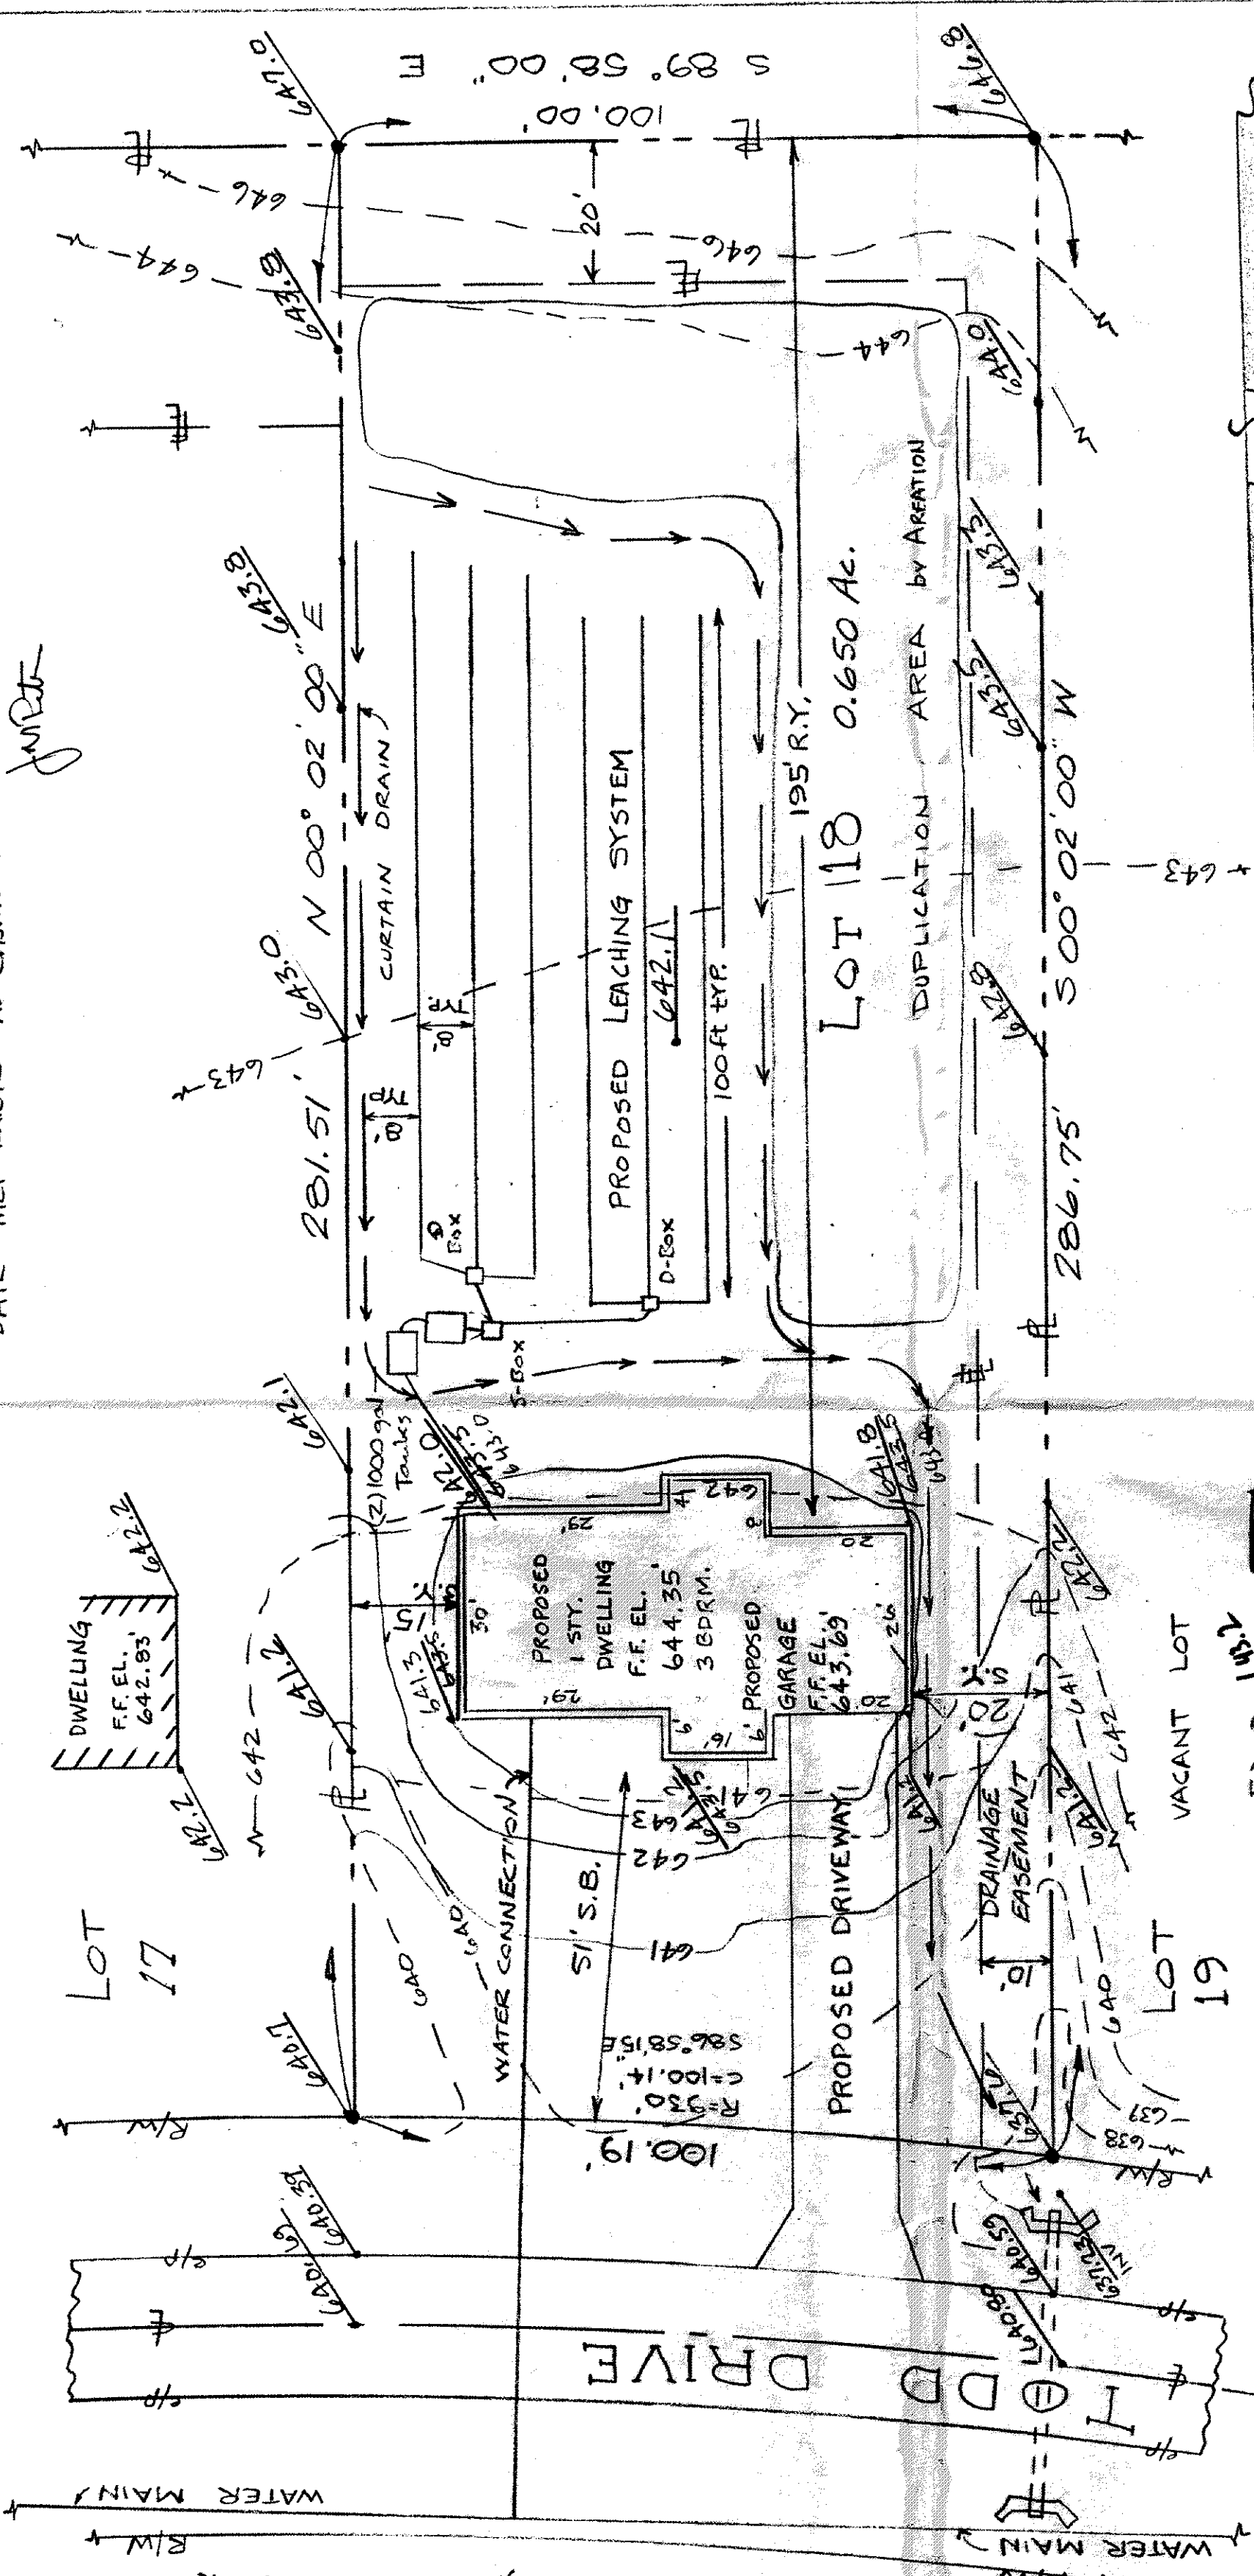

- LEGEND:
- 96-- EXIST. CONTOUR ELEV.
 - 97-- PROP. CONTOUR ELEV.
 - 97.1 EXIST. ELEV.
 - 93.0 PROP. ELEV.
 - #- EASEMENT LINE
 - #- PROPERTY LINE
 - DENOTES 1/2" IRON BAR


SITE PLAN

FOR
JOE WELCH

5/18 TODD DRIVE
MADISON-TOWNLINE
ESTATES SUBDIVISION
MADISON TOWNSHIP
LAKE COUNTY, O.

SCALE 1" = 20 ft
MAY 9, 1996

JIM PETER LAND SURVEY
4755 CROSBY-COOK RD.
ROME, OHIO 44095
P: 216-294-2187

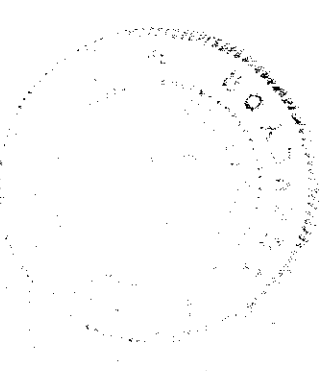

JMP

DWG NO 240301

NOTE: EASEMENT LINES SHOWN ARE PROPOSED.

SEWAGE DISPOSAL PERMIT MUST BE OBTAINED BY A LAKE COUNTY LICENSED INSTALLER BEFORE INSTALLATION IS STARTED.


- A. To be brought to finished grade
1. Septic tank manhole covers
 2. Splitter box cover
 3. Distribution box cover

- B. No footer drains or downspouts to be discharged into septic tanks


- C. All waste water to be discharged to septic tanks

LOW YIELD WATER FIXTURES REQUIRED ON ALL:

- Shower Head
- Toilet

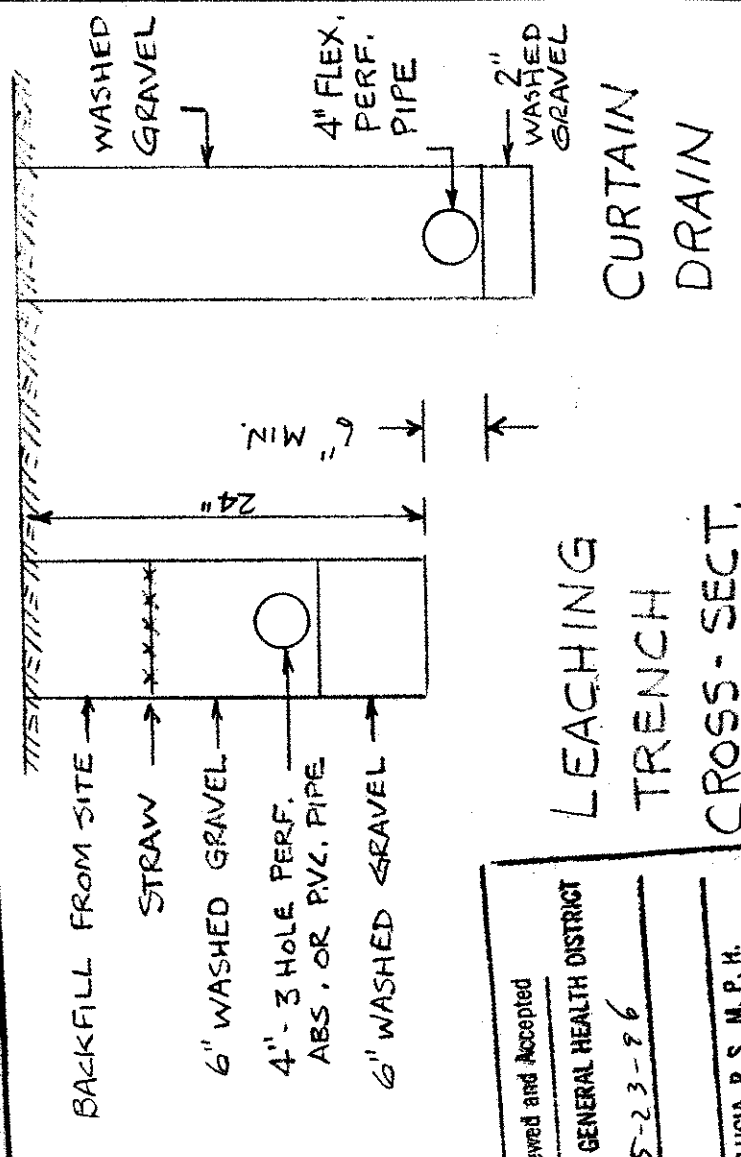

SEPTIC SYSTEM PROFILE

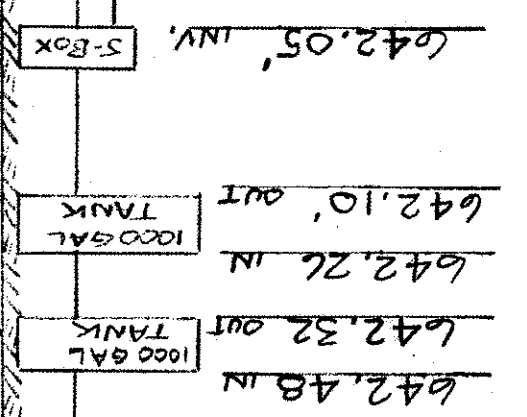

ROOF DRAINS SHALL DISCHARGE TO SPLASH BLOCKS.

Lower finished grade to 643.0

LEACHING TRENCH CROSS-SECT.

Reviewed and Accepted
LAKE COUNTY GENERAL HEALTH DISTRICT
5-23-96
JOEL LUCHA, R.S., M.P.H.
Health Commissioner
BY J. L. Lucha