

- LEGEND:
- 98.0 --- EXIST. CONTOUR ELEV.
 - 97.1 - PROP. CONTOUR ELEV.
 - 97.1 EXIST. ELEV.
 - 98.0 PROP. ELEV.
 - EASEMENT LINE
 - PROPERTY LINE
 - DENOTES 1/2" x 1/8" BAR

SITE PLAN


FOR
JOE WELCH

S/L 17 TODD DRIVE
MADISON - TOWNLINE
ESTATES SUBDIVISION


MADISON TOWNSHIP
LAKE COUNTY, O.

SCALE 1" = 20 ft
25 APRIL 1994

JIM PETER LAND SURVEY
4759 CROSBY - COOK RD
ROME, OHIO 44085

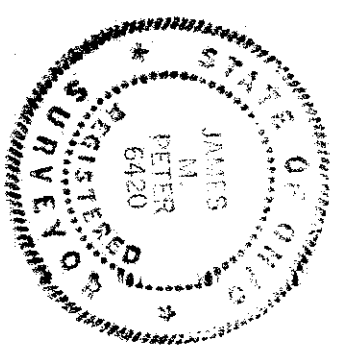

DWG NO 940302

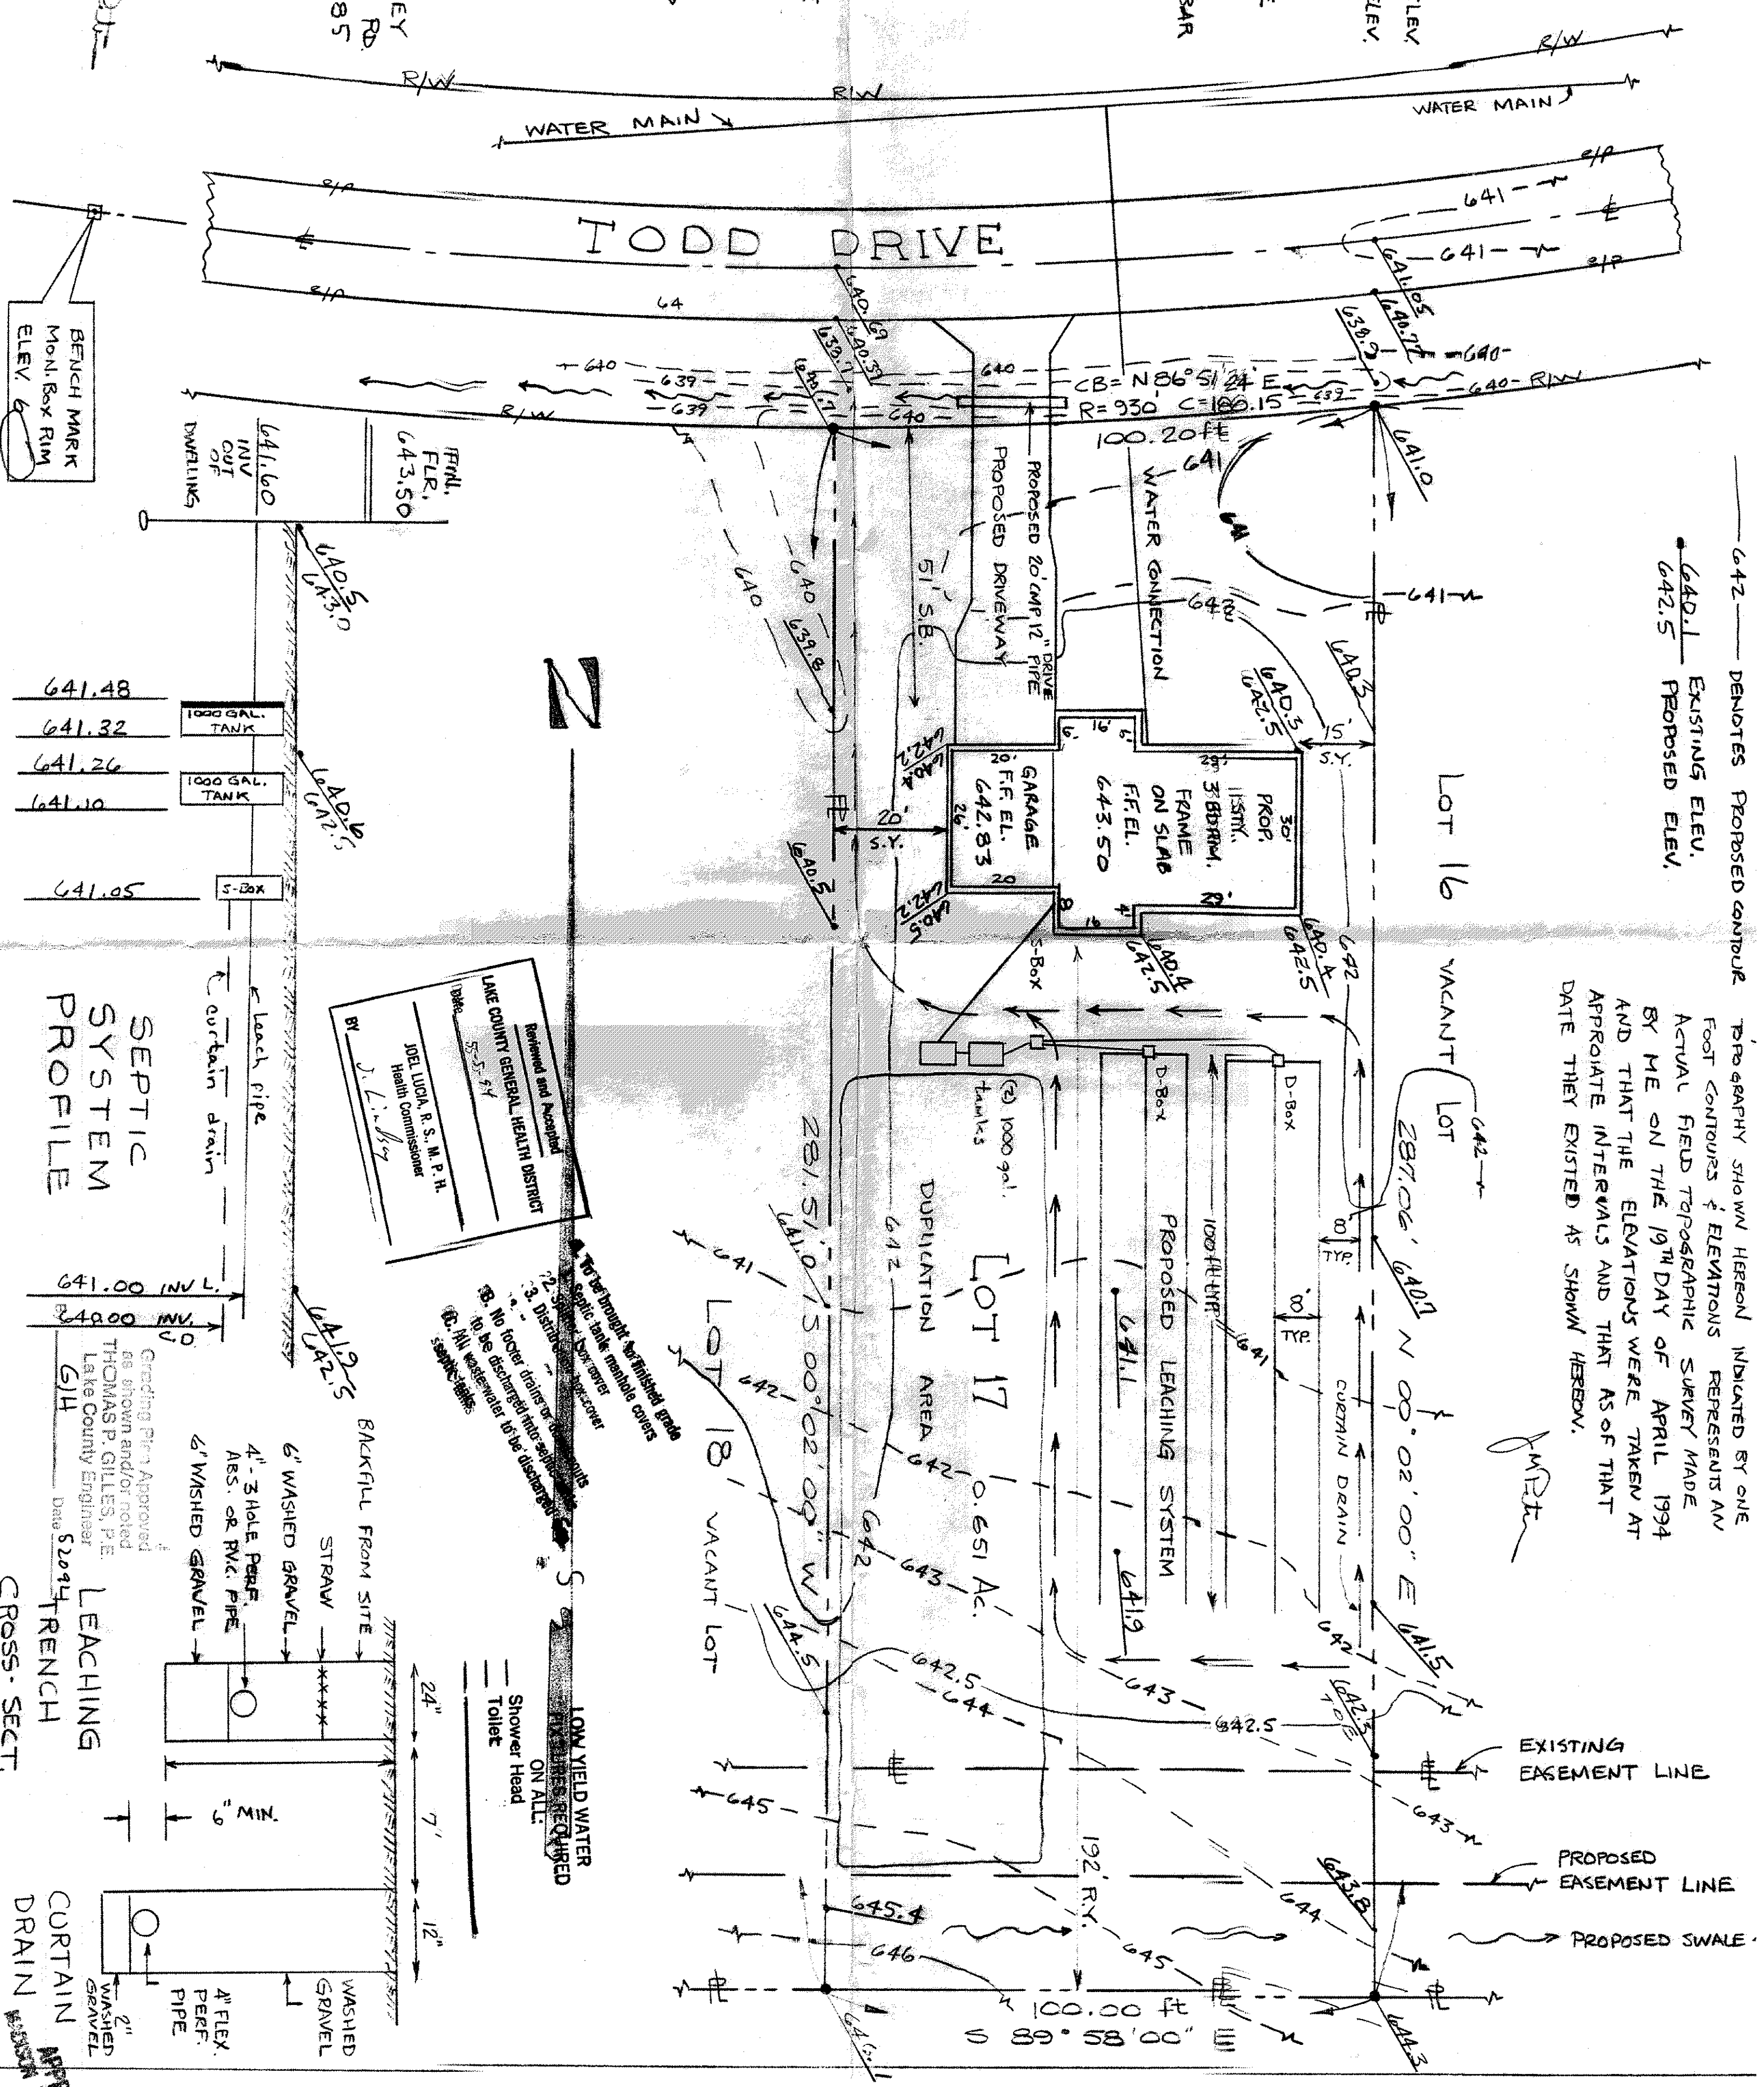


642 --- DENOTES PROPOSED CONTOUR
640.1 --- EXISTING ELEV.
642.5 --- PROPOSED ELEV.

TOPOGRAPHY SHOWN HEREON INDICATED BY ONE FOOT CONTOURS & ELEVATIONS REPRESENTS AN ACTUAL FIELD TOPOGRAPHIC SURVEY MADE BY ME ON THE 19TH DAY OF APRIL 1994 AND THAT THE ELEVATIONS WERE TAKEN AT APPROPRIATE INTERVALS AND THAT AS OF THAT DATE THEY EXISTED AS SHOWN HEREON.

Reviewed and Accepted
LANE COUNTY GENERAL HEALTH DISTRICT
JOEL LUCHA, R. S. M. P. H.
Health Commissioner
BY J. L. Lucha

SEPTIC SYSTEM PROFILE

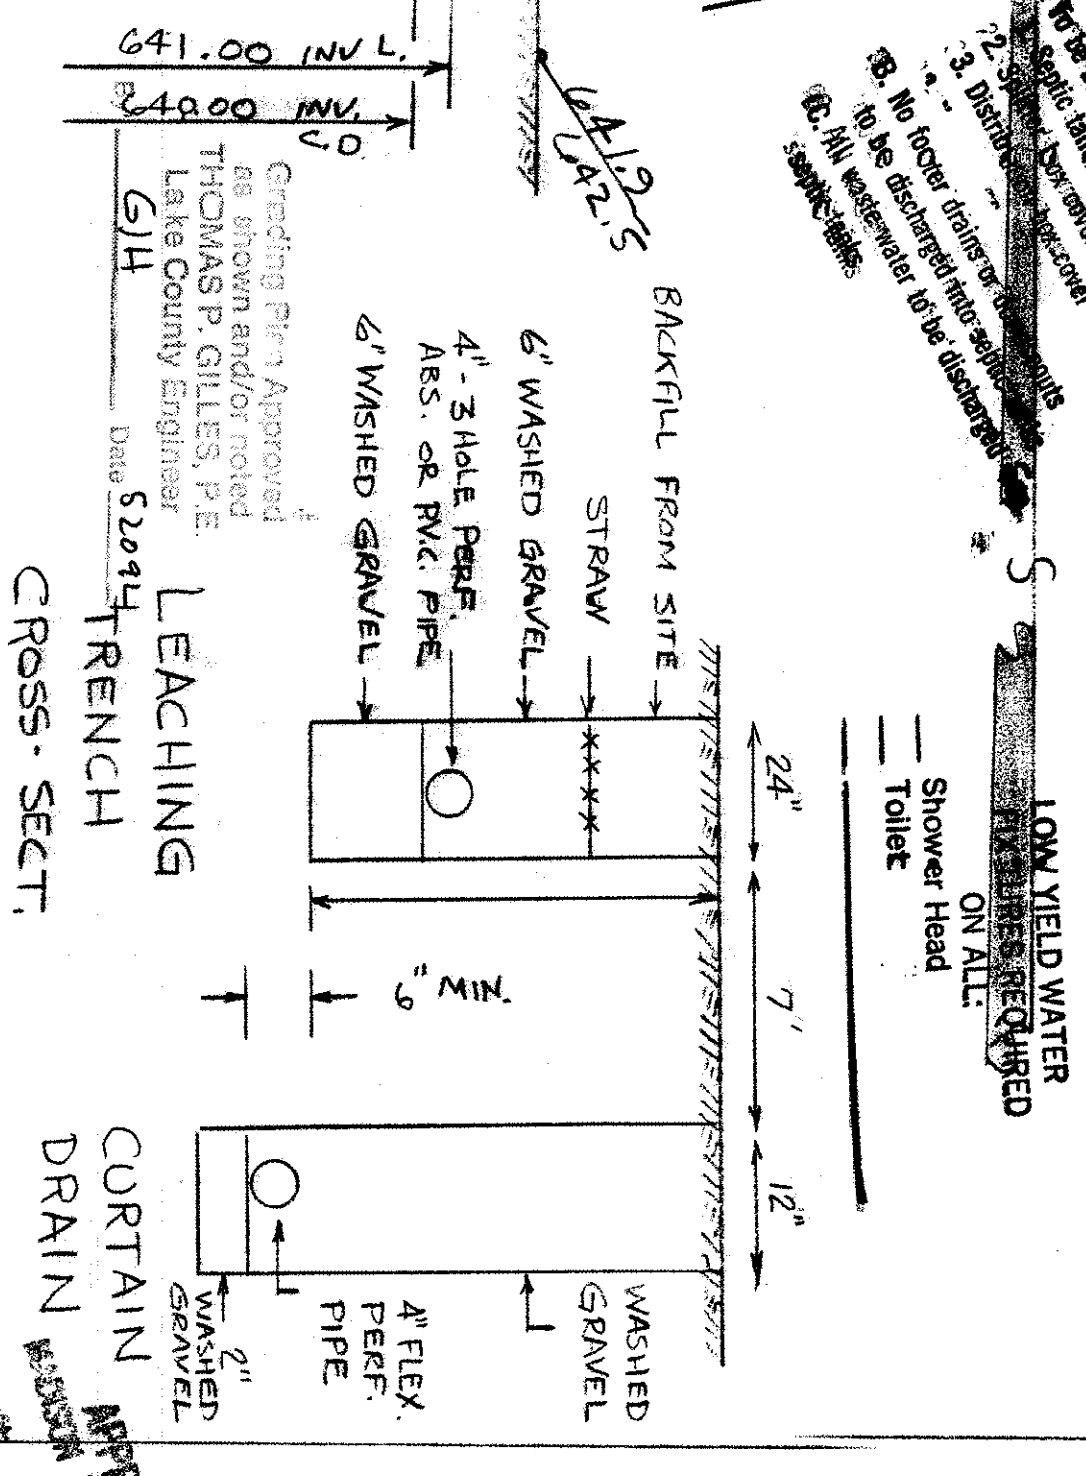

LEACHING TRENCH CROSS-SECT.

APPROVED
THOMAS P. GILLES, P.E.
Lake County Engineer
Date 5/29/94