


JIM PETER LAND SURVEY
4759 CROSBY-COOK RD.
ROME, OHIO 44085

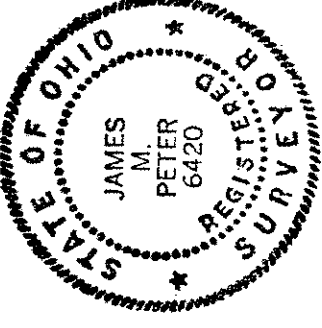

I, THE UNDERSIGNED, HEREBY CERTIFY
THAT THE TOPOGRAPHY SHOWN HEREON,
REPRESENTED BY ONE FOOT CONTOUR
INTERVALS, REPRESENTS AN ACTUAL
FIELD TOPOGRAPHIC SURVEY MADE
BY ME ON THE 15TH DAY OF MARCH
1995, AND THAT THE ELEVATIONS
SHOWN REPRESENT THE GROUND
ELEVATIONS AS OF THAT DATE.

- A. To be brought to finished grade
1. Septic tank manhole covers
 2. Splitter box cover
 3. Distribution box cover
- B. No footer drains or flowspouts
to be discharged into septic tanks
- C. All waste water to be discharged into
septic tanks

Reviewed and Accepted
LAKE COUNTY GENERAL HEALTH DISTRICT
Date 3-30-95
JOEL LUCIA, R. S., M. P. H. Health Commissioner
BY J. Lucia

LOW YIELD WATER
FIXTURES REQUIRED
ON ALL:
Shower Head
Toilet



SEWAGE DISPOSAL PERMIT MUST BE
OBTAINED BY A LAKE COUNTY LICENSED
INSTALLER BEFORE INSTALLATION IS
STARTED.

Grading Plan Approved
as shown and/or noted
THOMAS P. GILLES, P.E.
LAKE COUNTY ENGINEER
APPROVED FOR PERMITTING
1 APR 1995
DATE 4/1/95
PERMIT 14500

CROSS-SECT.

CROSS-SECT.

LEACHING
TRENCH

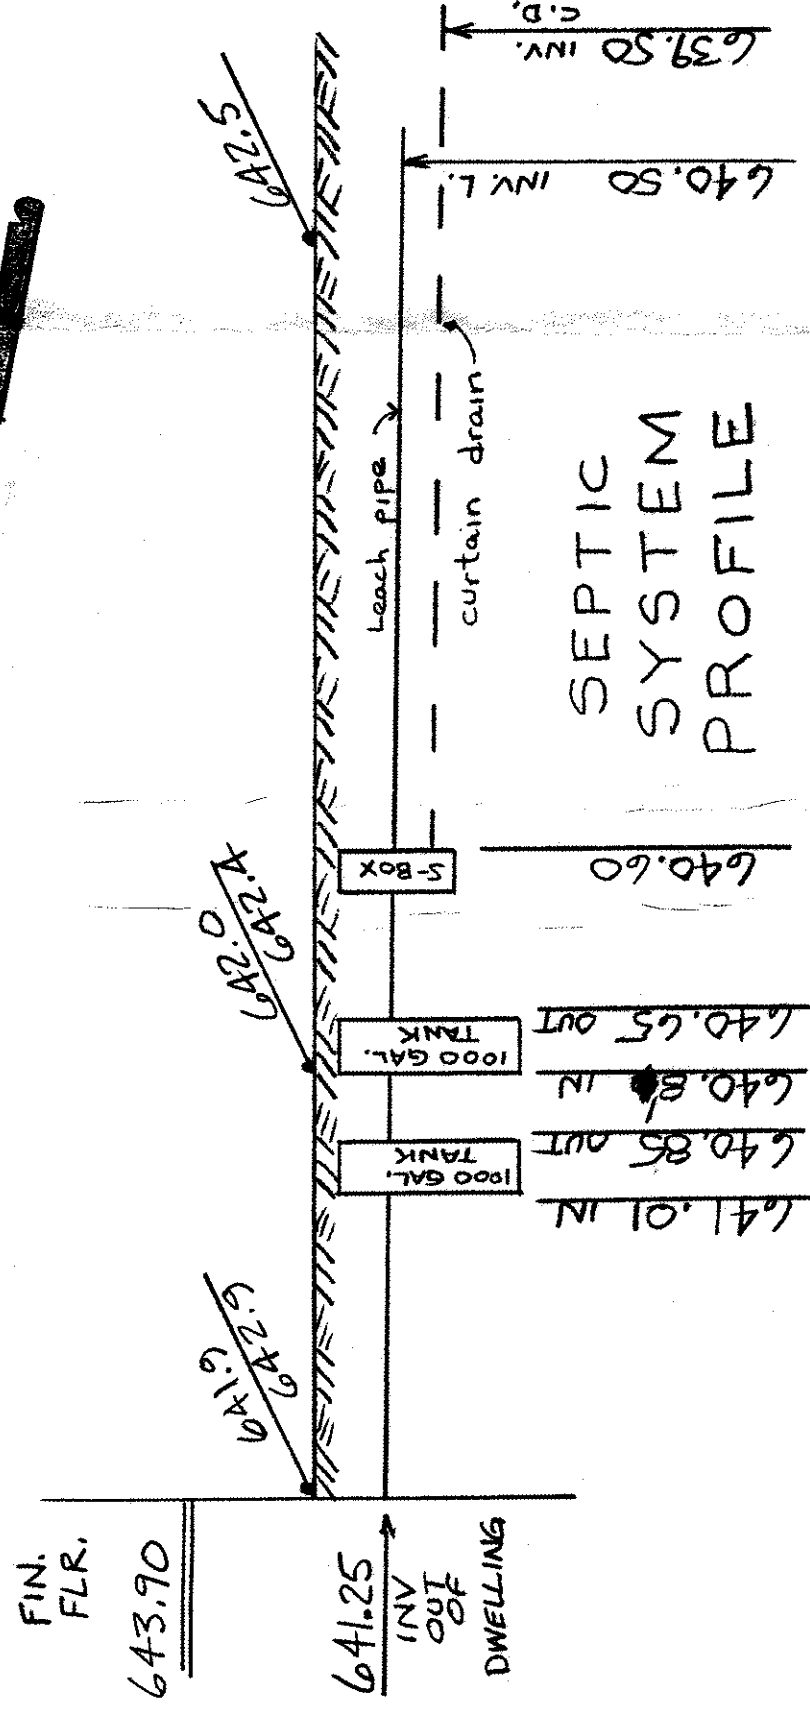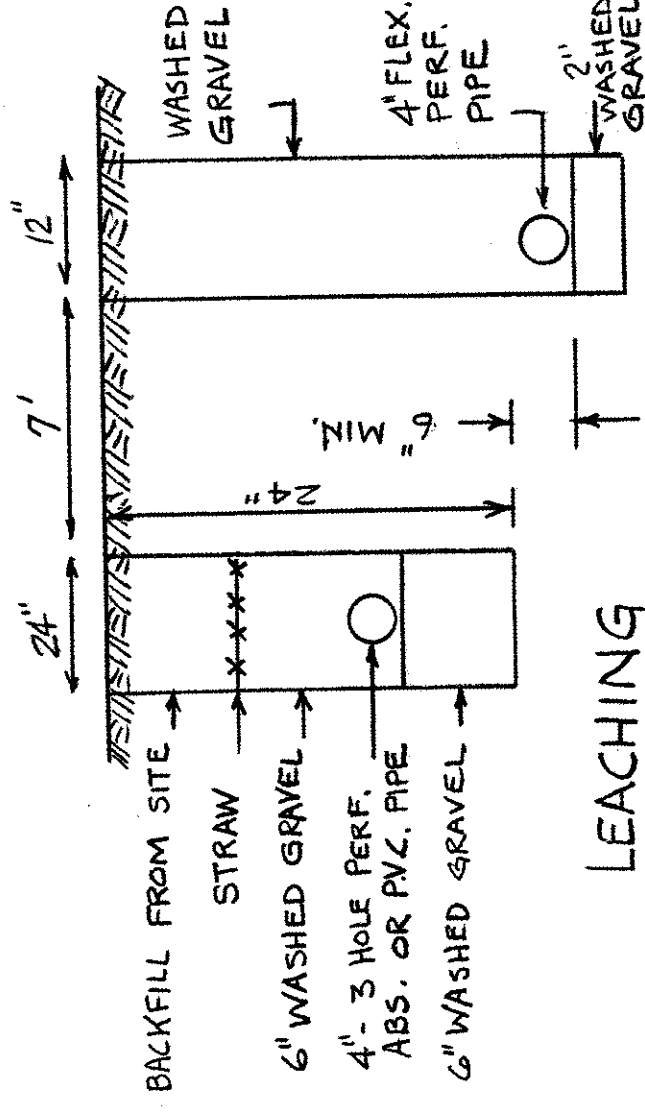

SITE PLAN

FOR
JOE WELCH

S/L 16 TODD DRIVE
MADISON-TOWNLINE
ESTATES SUBDIVISION

MADISON TOWNSHIP
LAKE COUNTY, O.

SCALE 1" = 20 ft.
18 MAR. 1995

