



LEACHING TRENCH CROSS SECTION

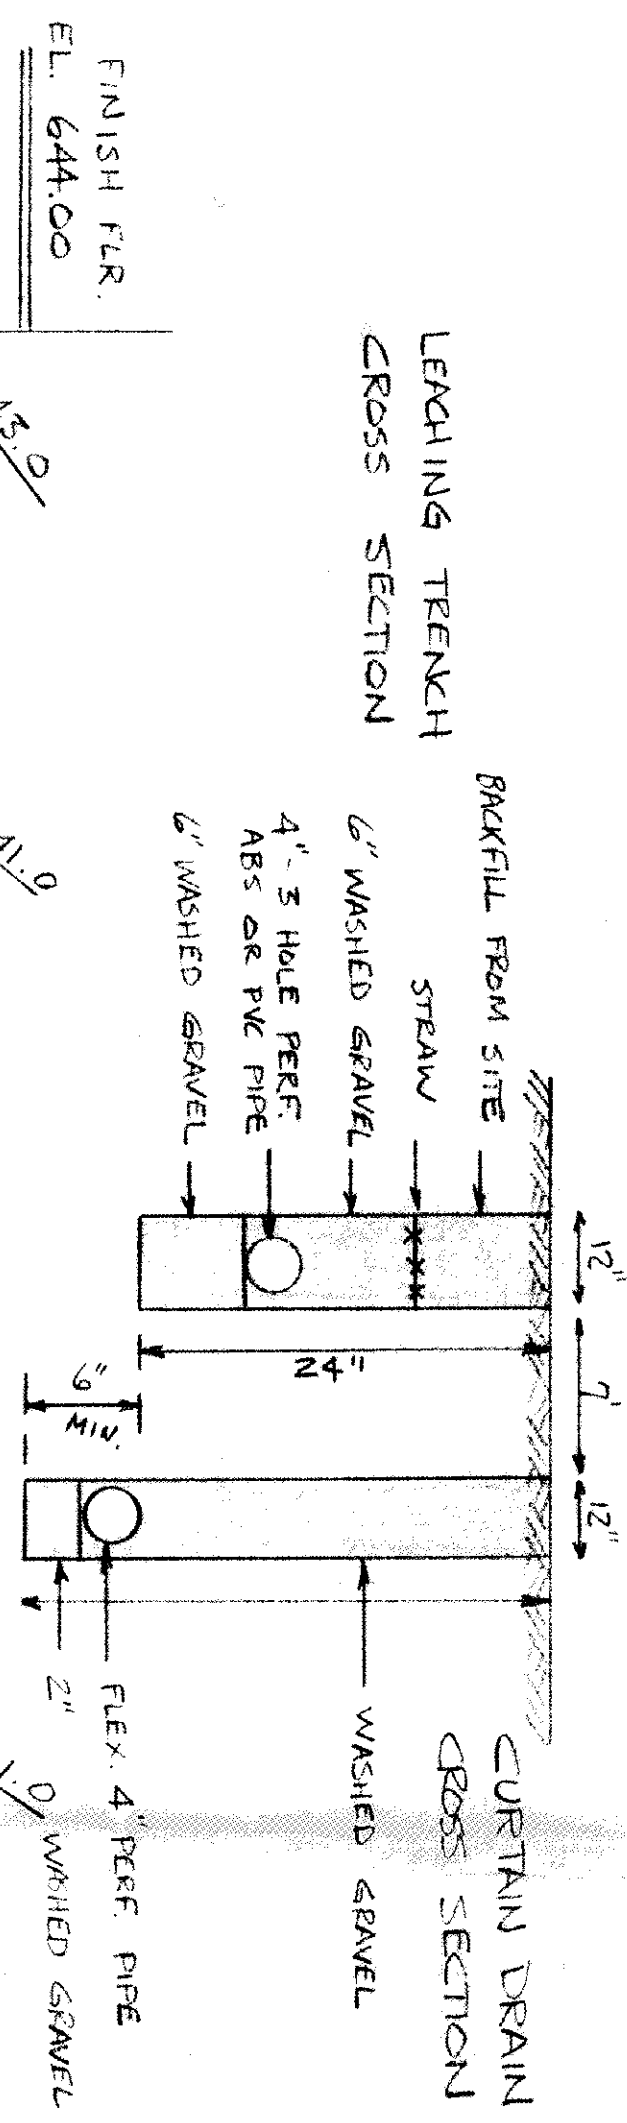

SEPTIC SYSTEM PROFILE

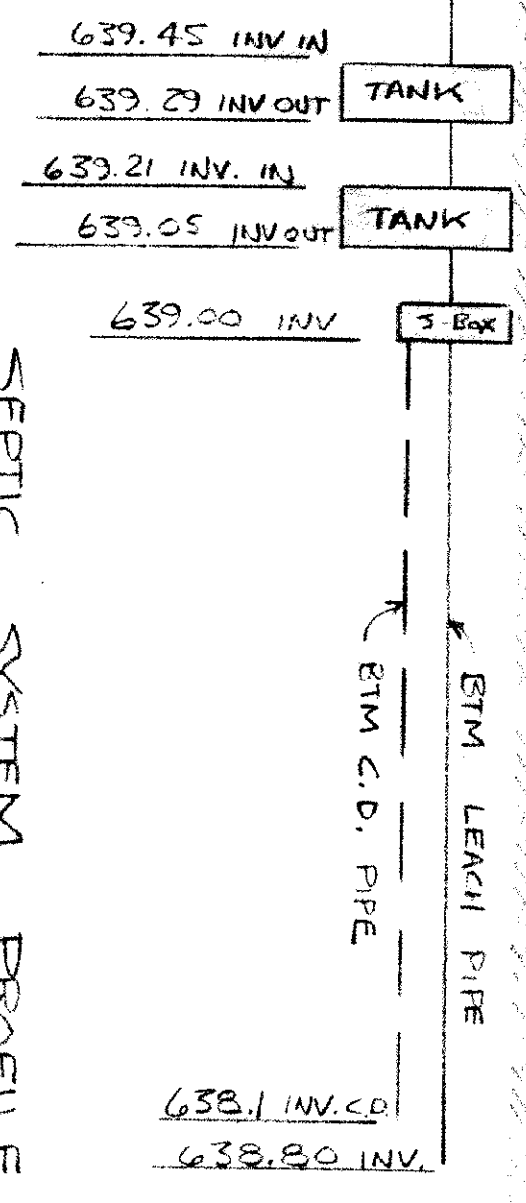


SITE PLAN

FOR
JOE WELCH

S/L 14 MADISON - TOWNLINE ESTATES
MADISON TOWNSHIP, LAKE COUNTY, OHIO
22 MAY 1993 SCALE 1" = 20 FT.

THIS IS TO CERTIFY THAT THE TOPOGRAPHY SHOWN HEREON, INDICATED BY ONE FOOT CONTOUR INTERVALS, ELEVATIONS WAS AN ACTUAL TOPOGRAPHIC SURVEY MADE BY ME ON THE 20TH DAY OF MAY 1993 AND THAT AS OF THAT DATE THE ELEVATIONS EXISTED AS SHOWN HEREON.

H: A GADEN V. 338 P. 63

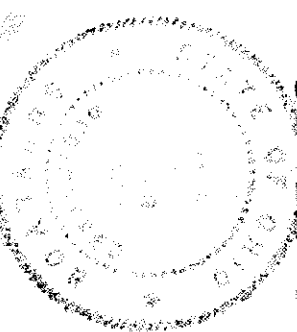


JIM PETER LAND SURVEYOR
4799 CROSBY - COOK RD.
ROME, OHIO 44085
216-294-2187

APPROVED
MADISON TWP. ZONING
Permit: 13806
Zoning Inspector: JWA

JUN 14 1993

ROOF DRAINS
SHALL DISCHARGE
TO SPLASH BLOCKS.

Grading Plan Approved
as shown and/or noted
THOMAS P. GILLES, P.E.
Lake County Engineer
By: GJH Date: 6-21-93

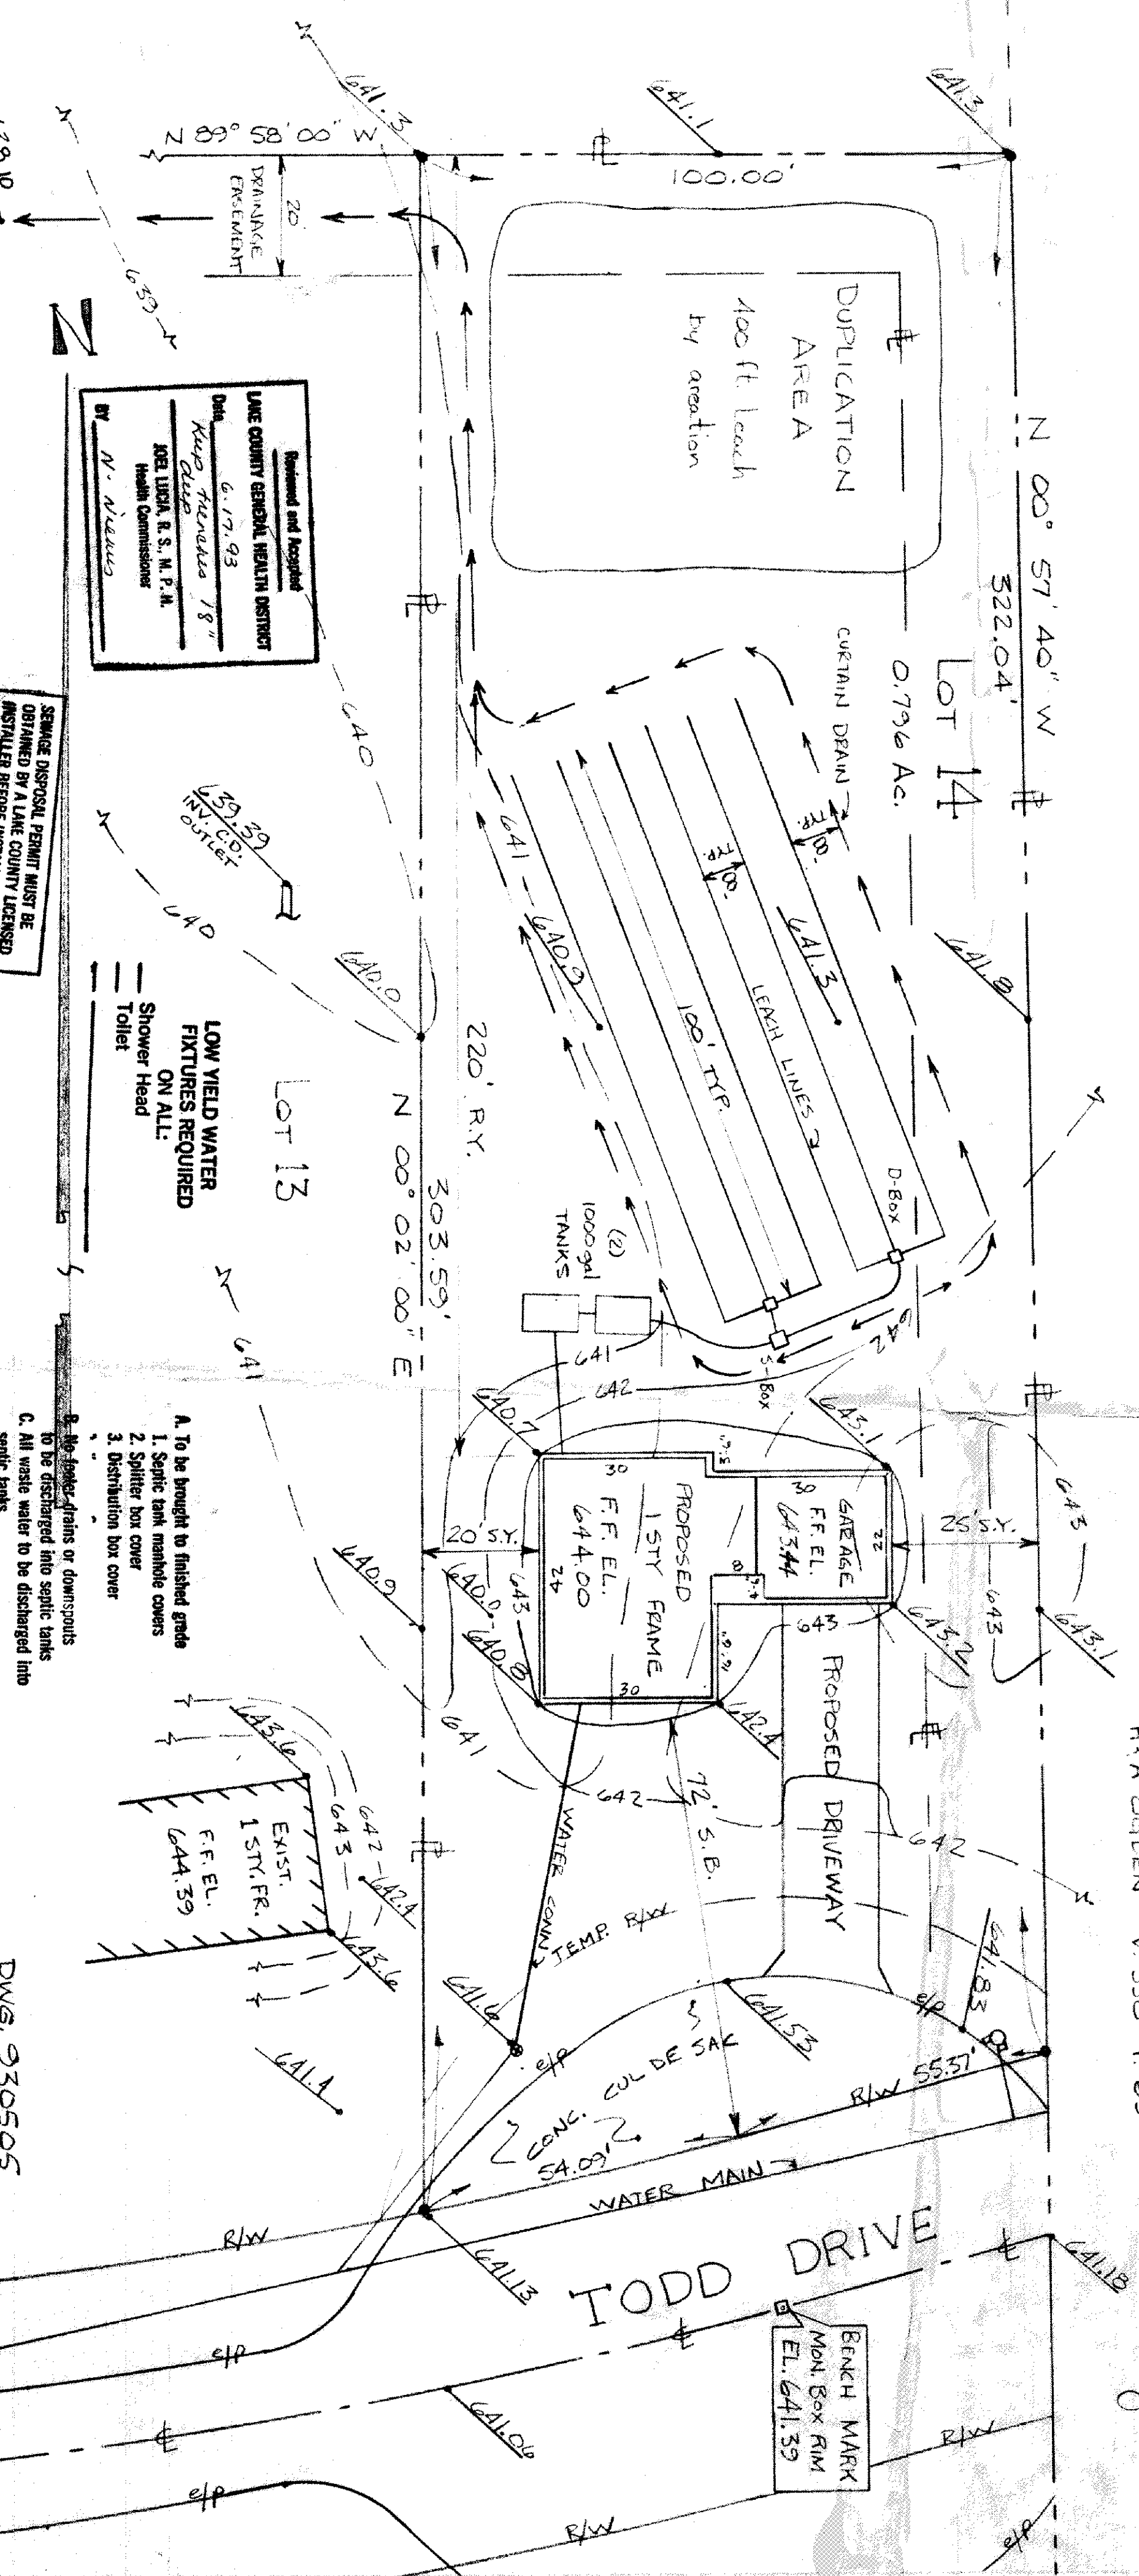

Reviewed and Accepted
LAKE COUNTY GEN. HEALTH DISTRICT
Date: 6-17-93
Krupp, Michael 18"
JOEL LUDKA, R.S., M.P.H.
Health Commissioner
BY: N. N. N. N.

SEWAGE DISPOSAL PERMIT MUST BE
OBTAINED BY A LAKE COUNTY LICENSED
INSTALLER BEFORE

LOW YIELD WATER
FIXTURES REQUIRED
ON ALL:
Shower Head
Toilet

1. To be brought to finished grade
2. Septic tank manhole covers
3. Splitter box cover
4. Distribution box cover

DWG. 930505