
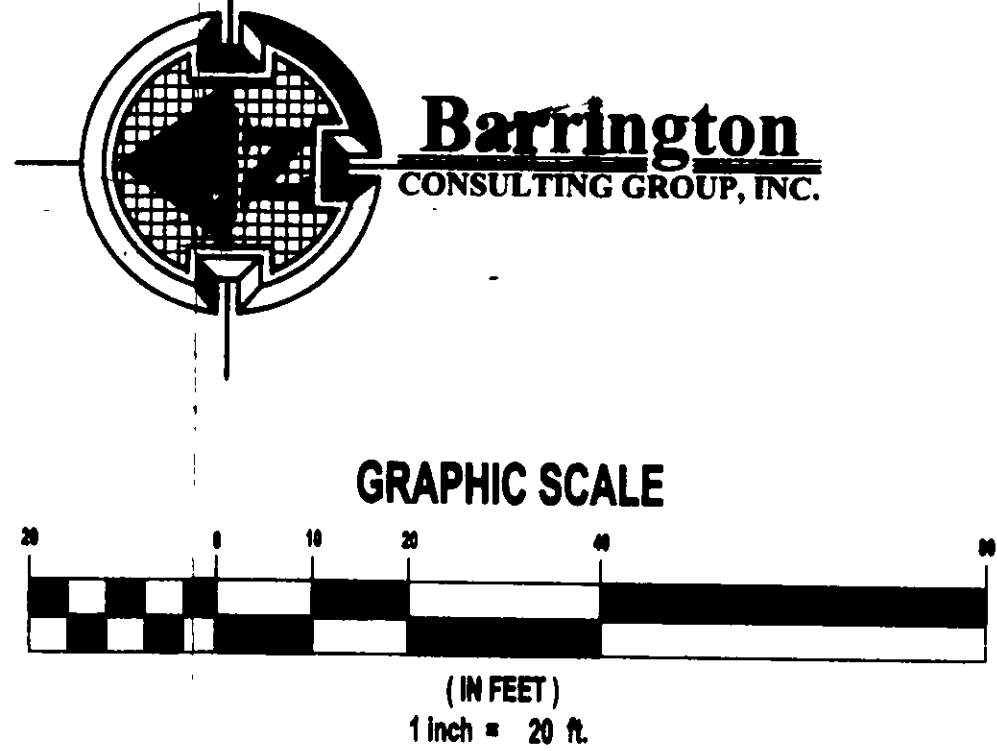
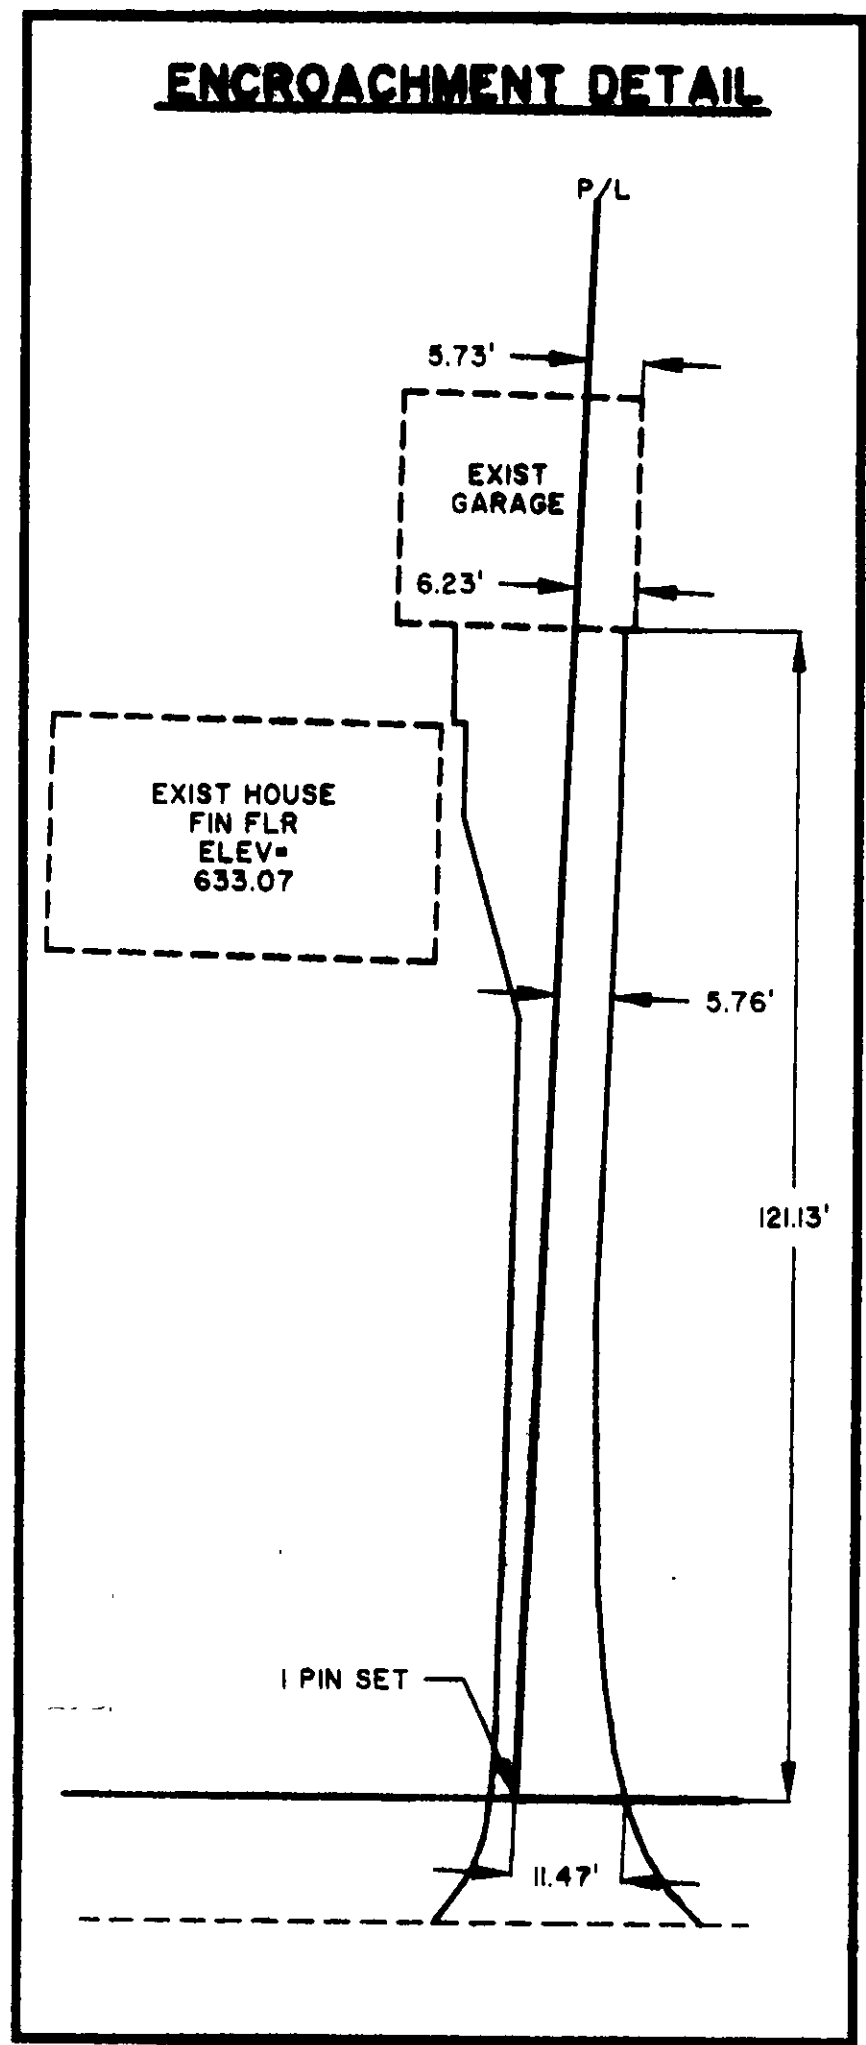


\\GRA\CRK_210\99138\99138A.dwg F:\Jan 21 04 10 35 2000 Copyright Barrington Consulting Group, Inc

FORM C:\SCIENCE\LIBRARY\FORMS\AKS6.DWG

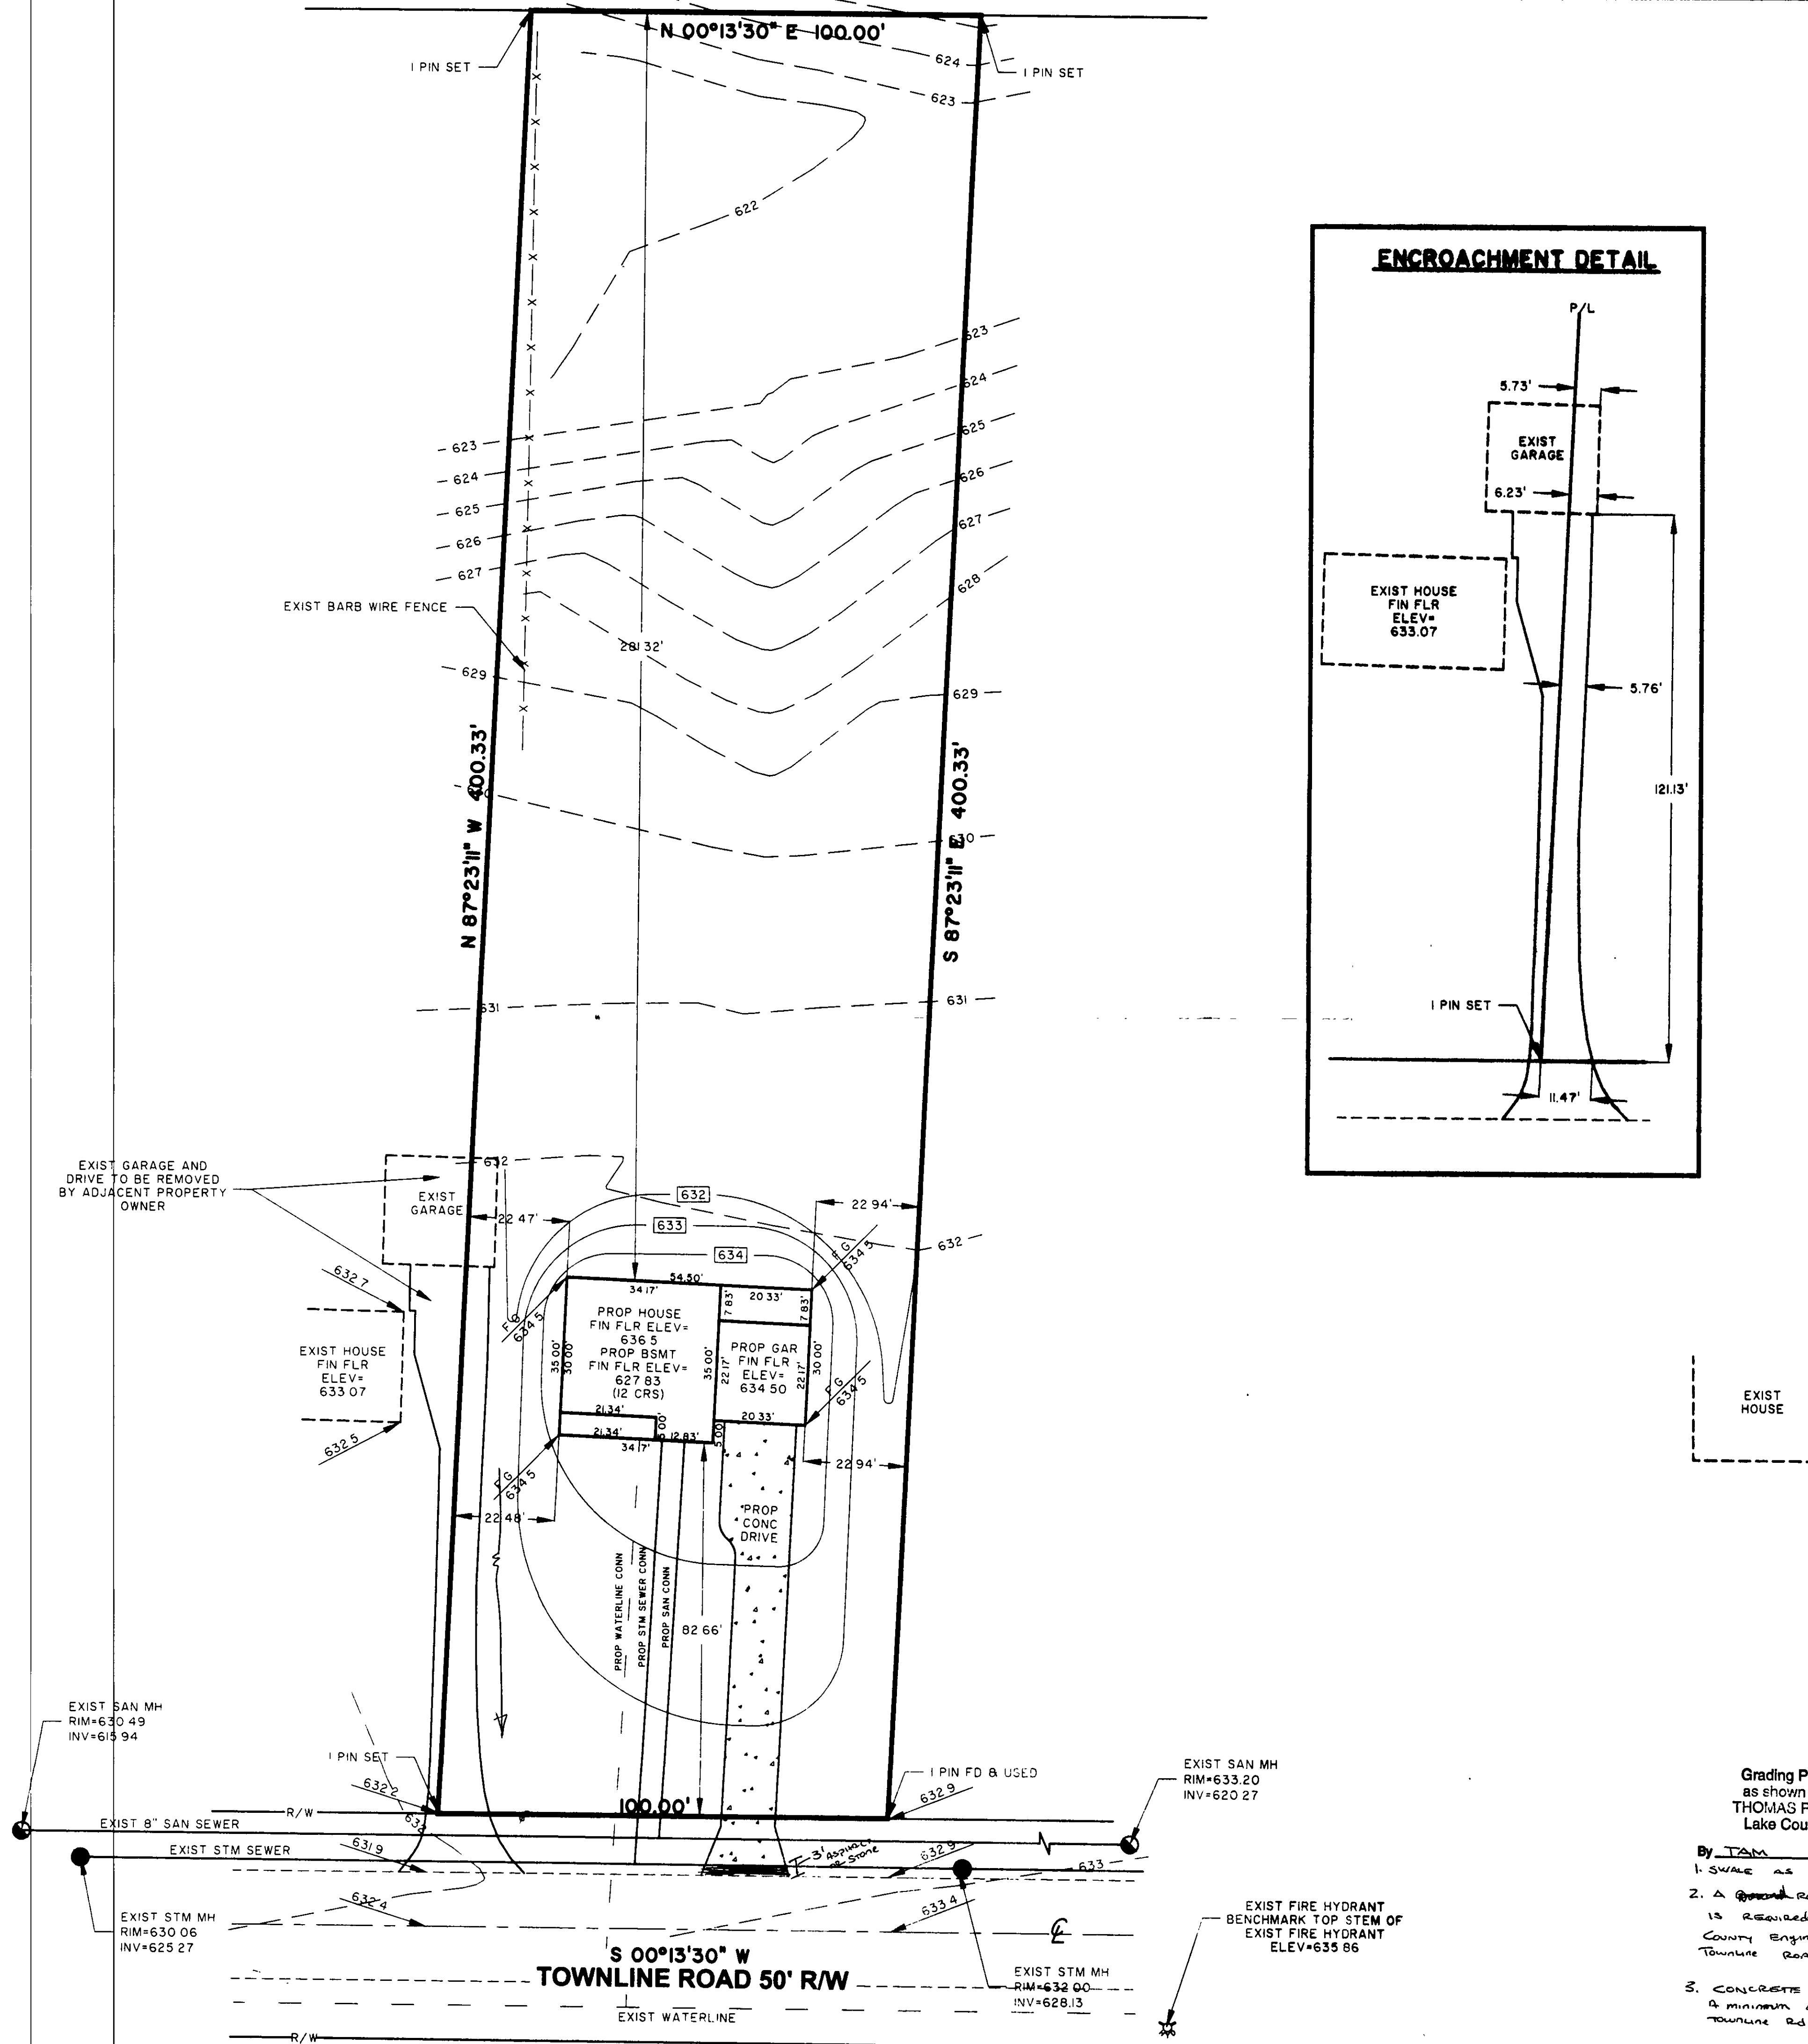

GENERAL NOTES:

1. BENCHMARK - TOP STEM OF EXISTING FIRE HYDRANT LOCATED IN FRONT PP No. 1B-124-41, ELEVATION = 635.86.
2. ALL DOWNSPOUTS TO BE OUTLETTED TO SPLASH BLOCKS.
3. CONTRACTOR RESPONSIBLE FOR CONTACTING THE OHIO UTILITY PROTECTION SERVICE (1.800.362.2764) AND ALL UTILITY COMPANIES A MINIMUM OF 41 HOURS PRIOR TO CONSTRUCTION.
4. THE LOCATION BOTH HORIZONTAL AND VERTICAL OF EXISTING UNDERGROUND UTILITIES SHOWN HEREON, HAVE BEEN OBTAINED BY A DILIGENT AND COMPREHENSIVE SEARCH OF AVAILABLE RECORDS. VERIFICATION BY FIELD OBSERVATION HAS BEEN CONDUCTED WHERE PRACTICAL, HOWEVER, BARRINGTON CONSULTING GROUP, INC. DOES NOT GUARANTEE THE COMPLETENESS, NOR ACCURACY THEREOF.

CERTIFICATION :

"I THE UNDERSIGNED HEREBY CERTIFIES THAT THIS TOPOGRAPHY INDICATED BY 1 FOOT CONTOURS AND ELEVATION SHOWN HEREON REPRESENTS AN ACTUAL SURVEY MADE BY ME ON THE 23rd DAY OF DECEMBER, 1999 AND THE ELEVATIONS WERE TAKEN AT AN APPROPRIATE INTERVAL AND AS OF THAT DAY THEY EXISTED AS INDICATED HEREON.

"I HEREBY CERTIFY THAT THIS PLAN WAS PREPARED BY ME AND IS CORRECT TO THE BEST OF MY KNOWLEDGE AND BELIEF"

APPROVED
MADISON TOWNSHIP ZONING
DATE: 2/1/00
BY: DM 2002R
DAVID W. NOVAK, P.S. No. 7507

Grading Plan Approved
as shown and/or noted
THOMAS P. GILLES, P.E.
Lake County Engineer

- By TAM Date 2/23/2000
1. SCALE AS SHOWN
 2. A proposed road opening point is required from the Lake County Engineer for work within Township Road R/W.
 3. CONCRETE DRIVE MUST END A MINIMUM OF 3' FROM TOWNSHIP RD Edge OF PAVEMENT

| REVISIONS | BY |
|-----------|----|
| | |
| | |
Barrington
CONSULTING GROUP, INC.
38342 WESTERN PARKWAY, SUITE 10
WILLOUGHBY, OHIO 44094
PHONE 440.946.1761 FAX 440.918.0496

NEUBERT
CONSTRUCTION, INC.
3871 CENTER STREET
PERRY, OHIO

SITE PLAN
TOWNSHIP ROAD, MADISON TOWNSHIP
PP No. 01-B-124-0-00-068-0

| | |
|---|--------------|
| DRY C.R. KRAFT CHECKED DWN DATE JAN 3 2000 SCALE 1" = 20' JOB NO. 99158 SHEET 11 | OF SHEETS |
|---|--------------|