




**Grading Plan Approved**  
as shown and/or noted  
**THOMAS P. GILLES, P.E.**  
Lake County Engineer

By Tom Date 7/10/00

1. Lower P.G. as noted
2. Grade as shown
3. Storm lateral construction will require a permit from N. Perry Vector and Lake County Engineer
4. Utility work within 20' will require a permit from Lake County Engineer and N. Perry Vector
5. SEE AND TOP Zoning permit 20200

**ROOF DRAINS**  
**SHALL DISCHARGE**  
**TO SPLASH BLOCKS.**

- NOTES:
1. The Contractor Shall Verify the Following Before Starting:  
Finish Floor Elevations and House Size.  
Location and elevation of existing utility connections.
  2. Contractor Shall Contact OUPS at least 2 Working days prior to construction, 1-800-362-2764.

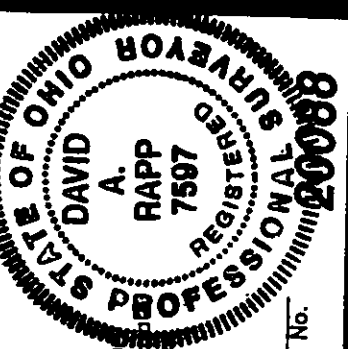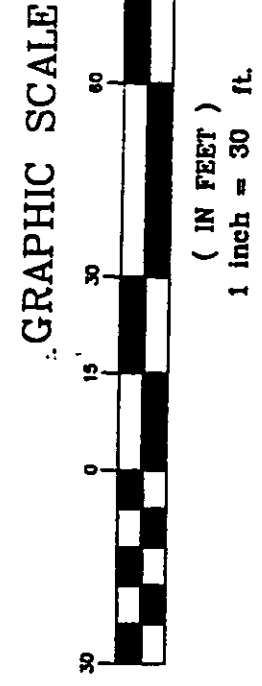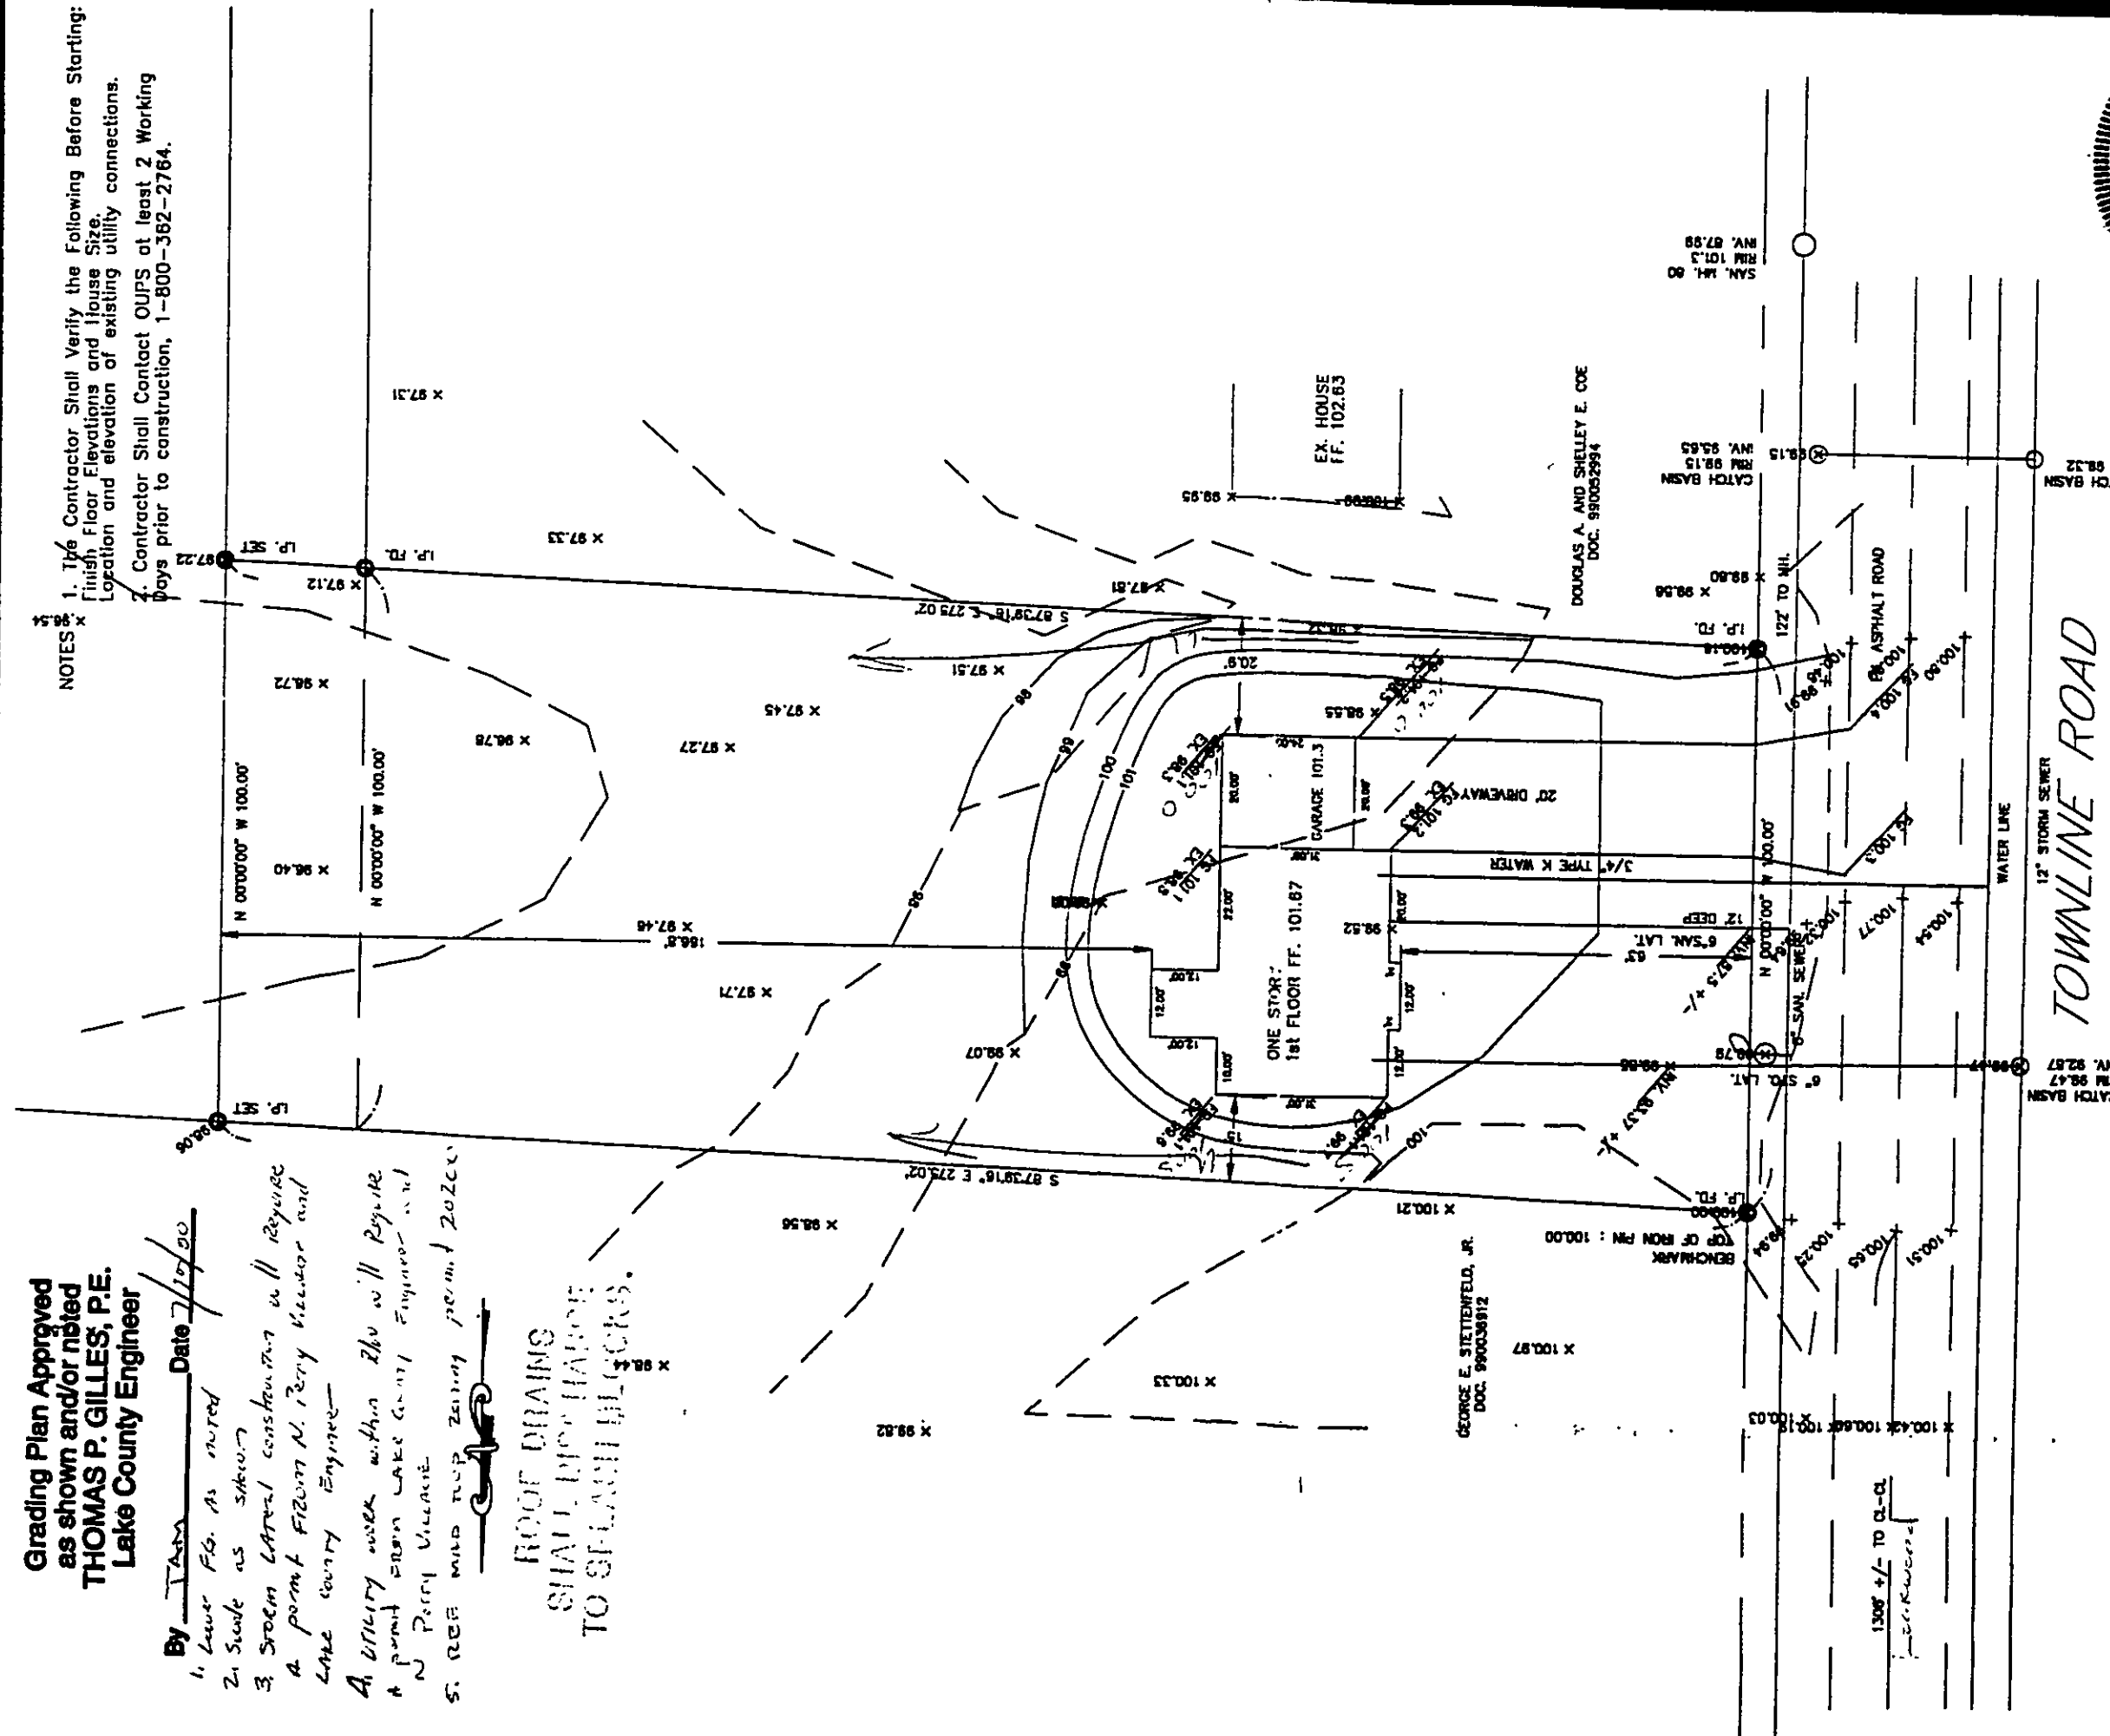

I, the undersigned hereby certify that this topography, indicated by 1' contours and elevations shown hereon represents an actual field survey made by me in June, 2000 and that the elevations were taken at appropriate intervals and that as of that date they exist as indicated hereon.

*David A. Rapp*  
David A. Rapp  
Reg. No. 7597  
Date 7-17-02

**COR Consultants, Inc.**

23 S. Forest Street  
Geneva, Ohio 44041  
440-466-8085

DATE: JUNE, 2000  
DRAWN BY: DAR  
CHECKED BY: BMQ  
APPROVED BY: DAR  
P.S. No. 7897

**JOE WELSH**  
**PP. No. 1B-124-69**  
**Site Plan**  
MADISON TOWNSHIP