
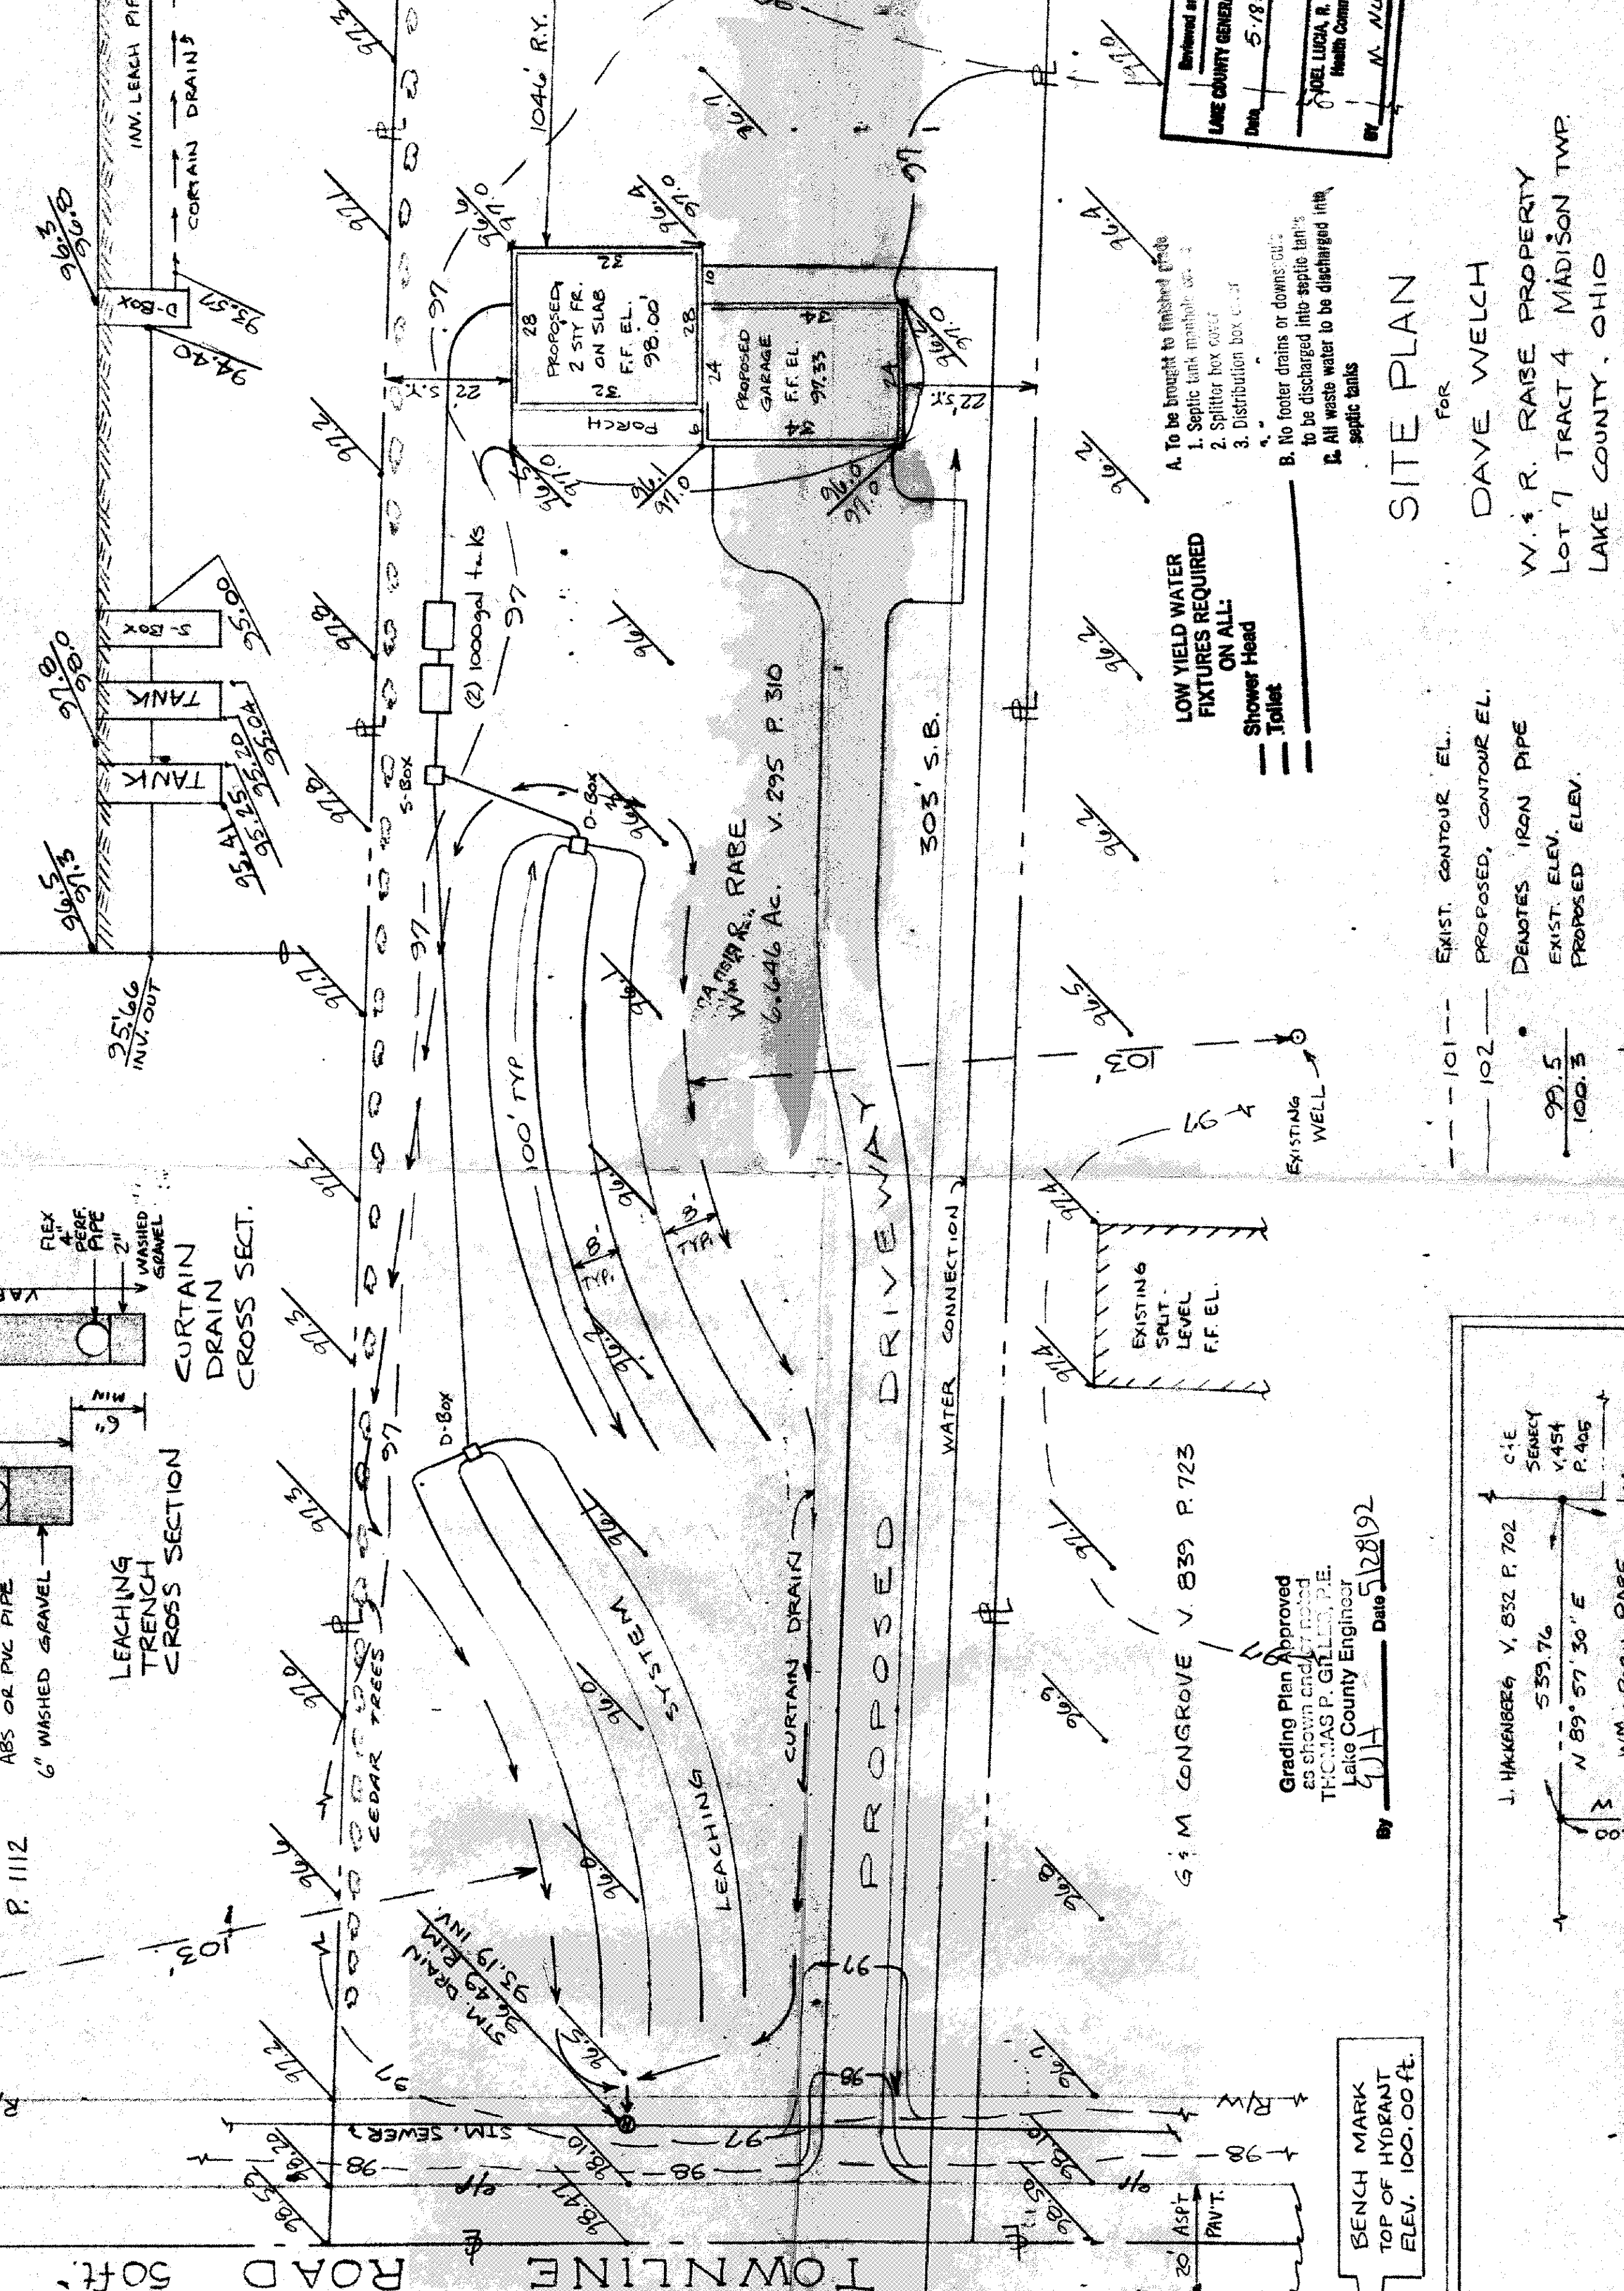
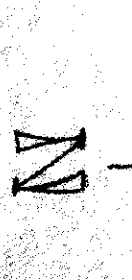
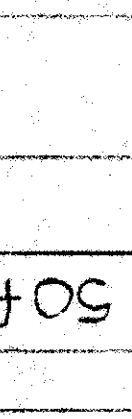


SEPTIC SYSTEM PROFILE

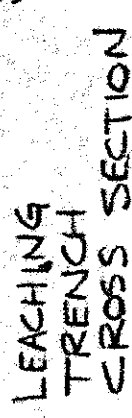

**LOW YIELD WATER
FIXTURES REQUIRED
ON ALL:
Shower Head
Toilet**

SITE PLAN

FOR

DAVE WELCH
W. & R. RAISE PROPERTY
LOT 7 TRACT 4 MADISON TWP.
LAKE COUNTY, OHIO
SCALE 1" = 20 ft.
5 MAY 1992
JIM PETER LAND SURVEY
4759 CROSBY COOK RD.

EXIST. CONTOUR E.L.
PROPOSED, CONTOUR E.L.
DENOTES IRON PIPE
EXIST. ELEV.
PROPOSED ELEV.
PROPERTY LINE
APPROVED
CENTERLINE
SECTION TWP. ZONING
RIGHT OF WAY 134621
Zoning Inspector *[Signature]*

PROPERTY LINE
APPROVED
CENTERLINE FROM TWP. ZONING
RIGHT OF WAY 13481
Zoning Inspector *WLL*

SEWAGE DISPOSAL PERMIT MUST BE OBTAINED BY A LAKE COUNTY LICENSED INSTALLER BEFORE INSTALLATION IS STARTED.

Grading Plan Approved
as shown and/or noted
THOMAS P. GILLER, P.E.
Lake County Engineer
4/14 Date 5/22

