

Madison Township
RECEIVED MAY 07 1987

Grading Plan Approved
as shown and for notes
THOMAS P. GILLES, P.E.
Lake County Engineer
By *thp* Date 6.13.87

SITE PLAN

MADISON TOWNSHIP LAKE COUNTY, OHIO

for: B. HEATH CONSTRUCTION
CLIENT OWNER
J5560 GAR HIGHWAY MONTVILLE 44064
ADDRESS STREET CITY ZIP

SUBDIVISION	NAME	STREET	PERM. PARCEL NO.	STREET
SUBLOT NO.	VOL. - PG.	LOT	VOLUME	PAGE
		7		4

LEGEND

- SANITARY MANHOLE
- STORM MANHOLE
- INLET OR CATCH BASIN
- HYDRANT
- EXISTING CONTOURS
- PROPOSED CONTOURS
- EXIST. ELEV.
- PROP. ELEV.
- WATER VALVE (GAS)
- WATER METER (GAS)
- AS BUILT ELEVATION
- INDICATES DIRECTION OF SURFACE DRAINAGE





REMARKS

ALL BOUNDARY DATA SHOWN WAS OBTAINED FROM (DEEDS, RECORDED SUBDIVISION PLAT OR OTHER PUBLIC RECORDS)
LOCATIONS AS SHOWN OF ADJACENT WELLS AND SEPTIC TANKS OBTAINED FROM LAKE COUNTY HEALTH DEPARTMENT

DESIGN CERTIFICATION

THIS PLAT WAS PREPARED BY ME, AND IS CORRECT TO THE BEST OF MY KNOWLEDGE AND BELIEF.

NAME *Thomas P. Gilles* SURVEYOR REGISTRATION NO. *6627*

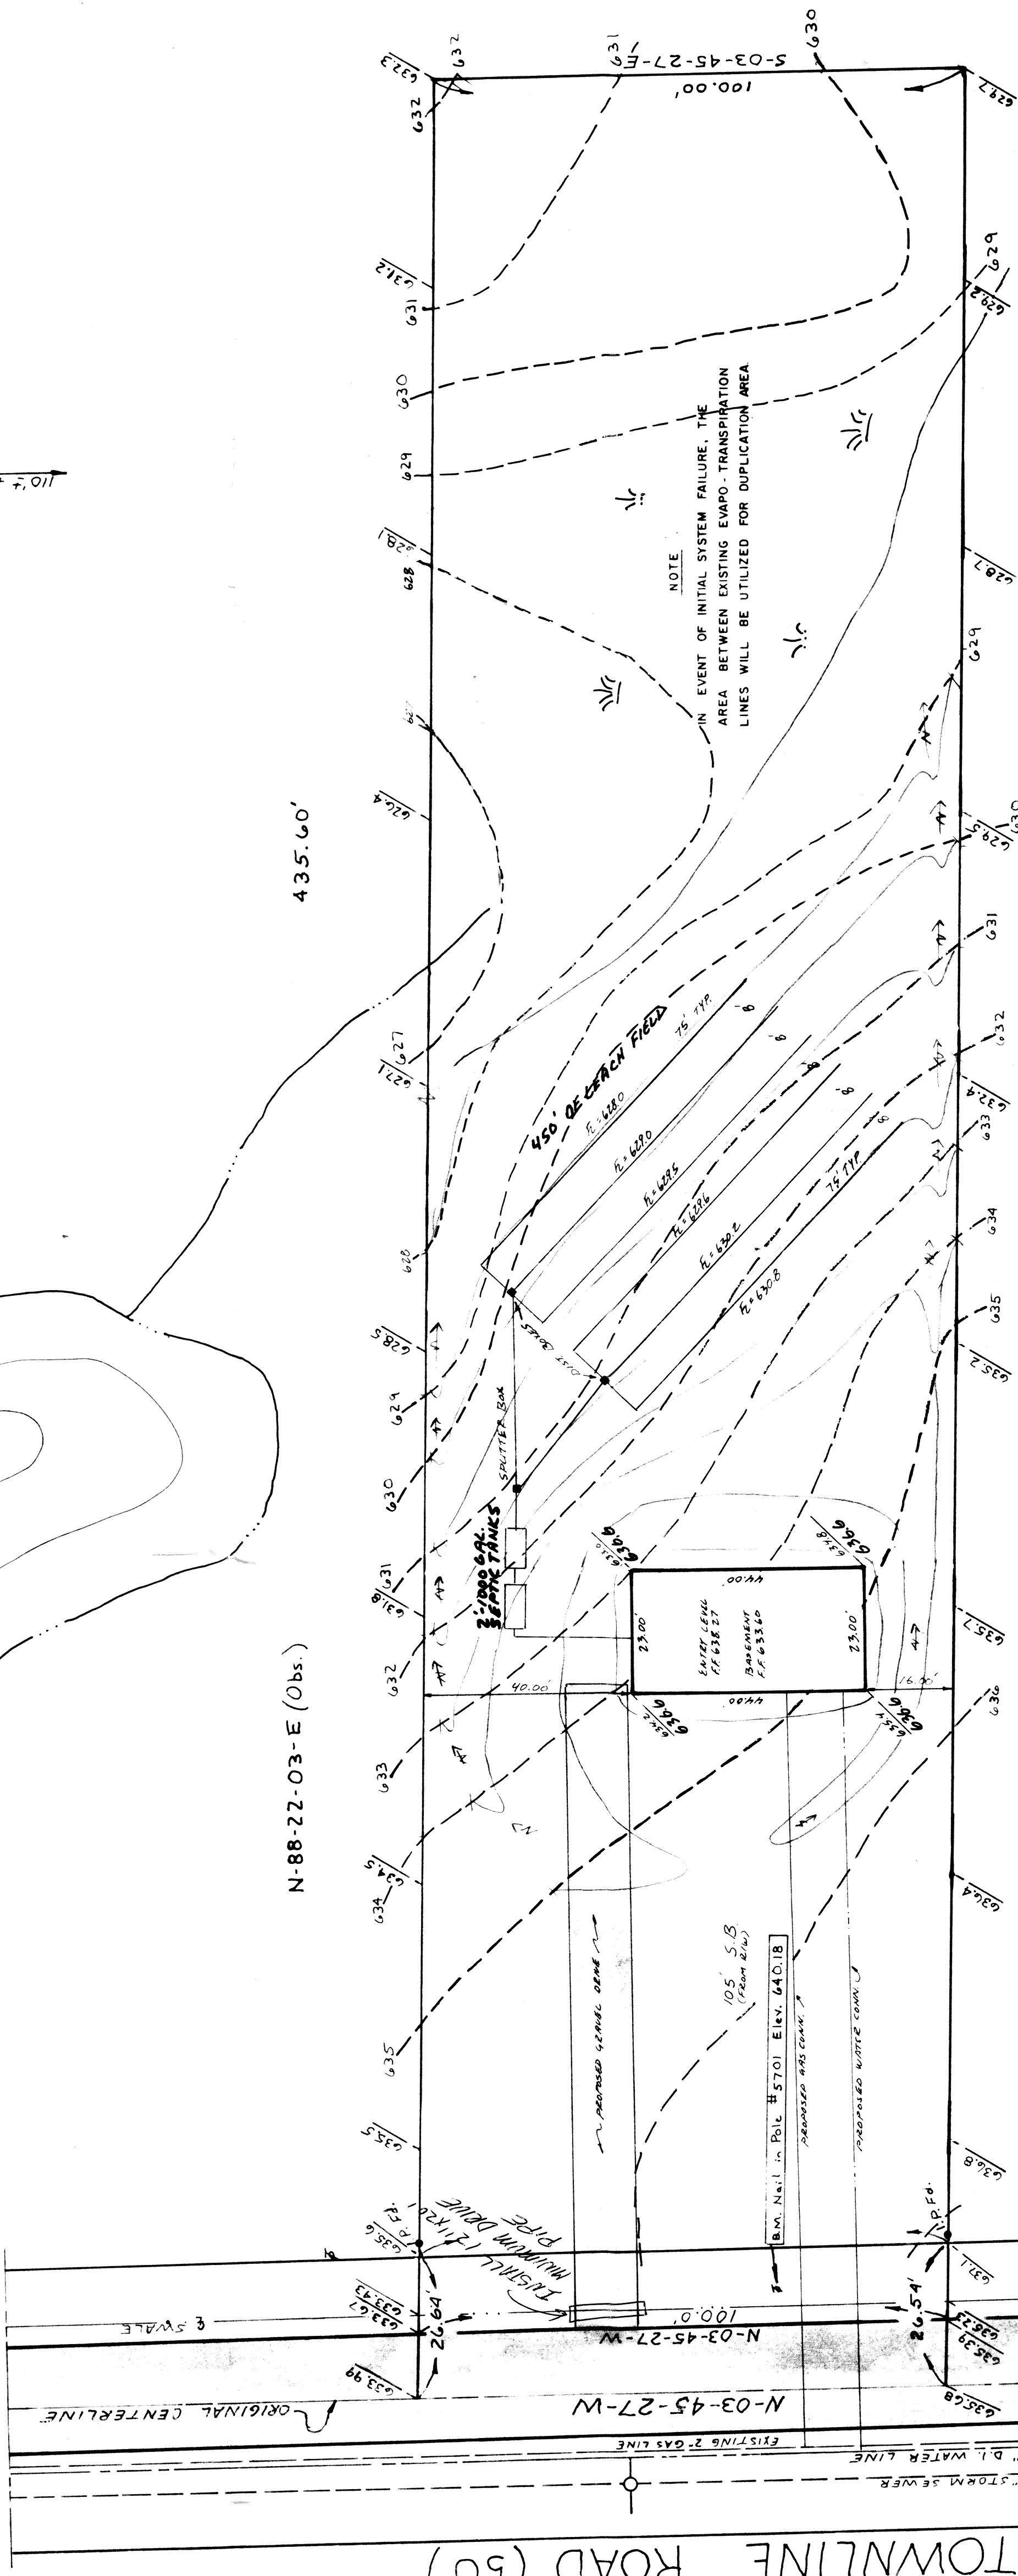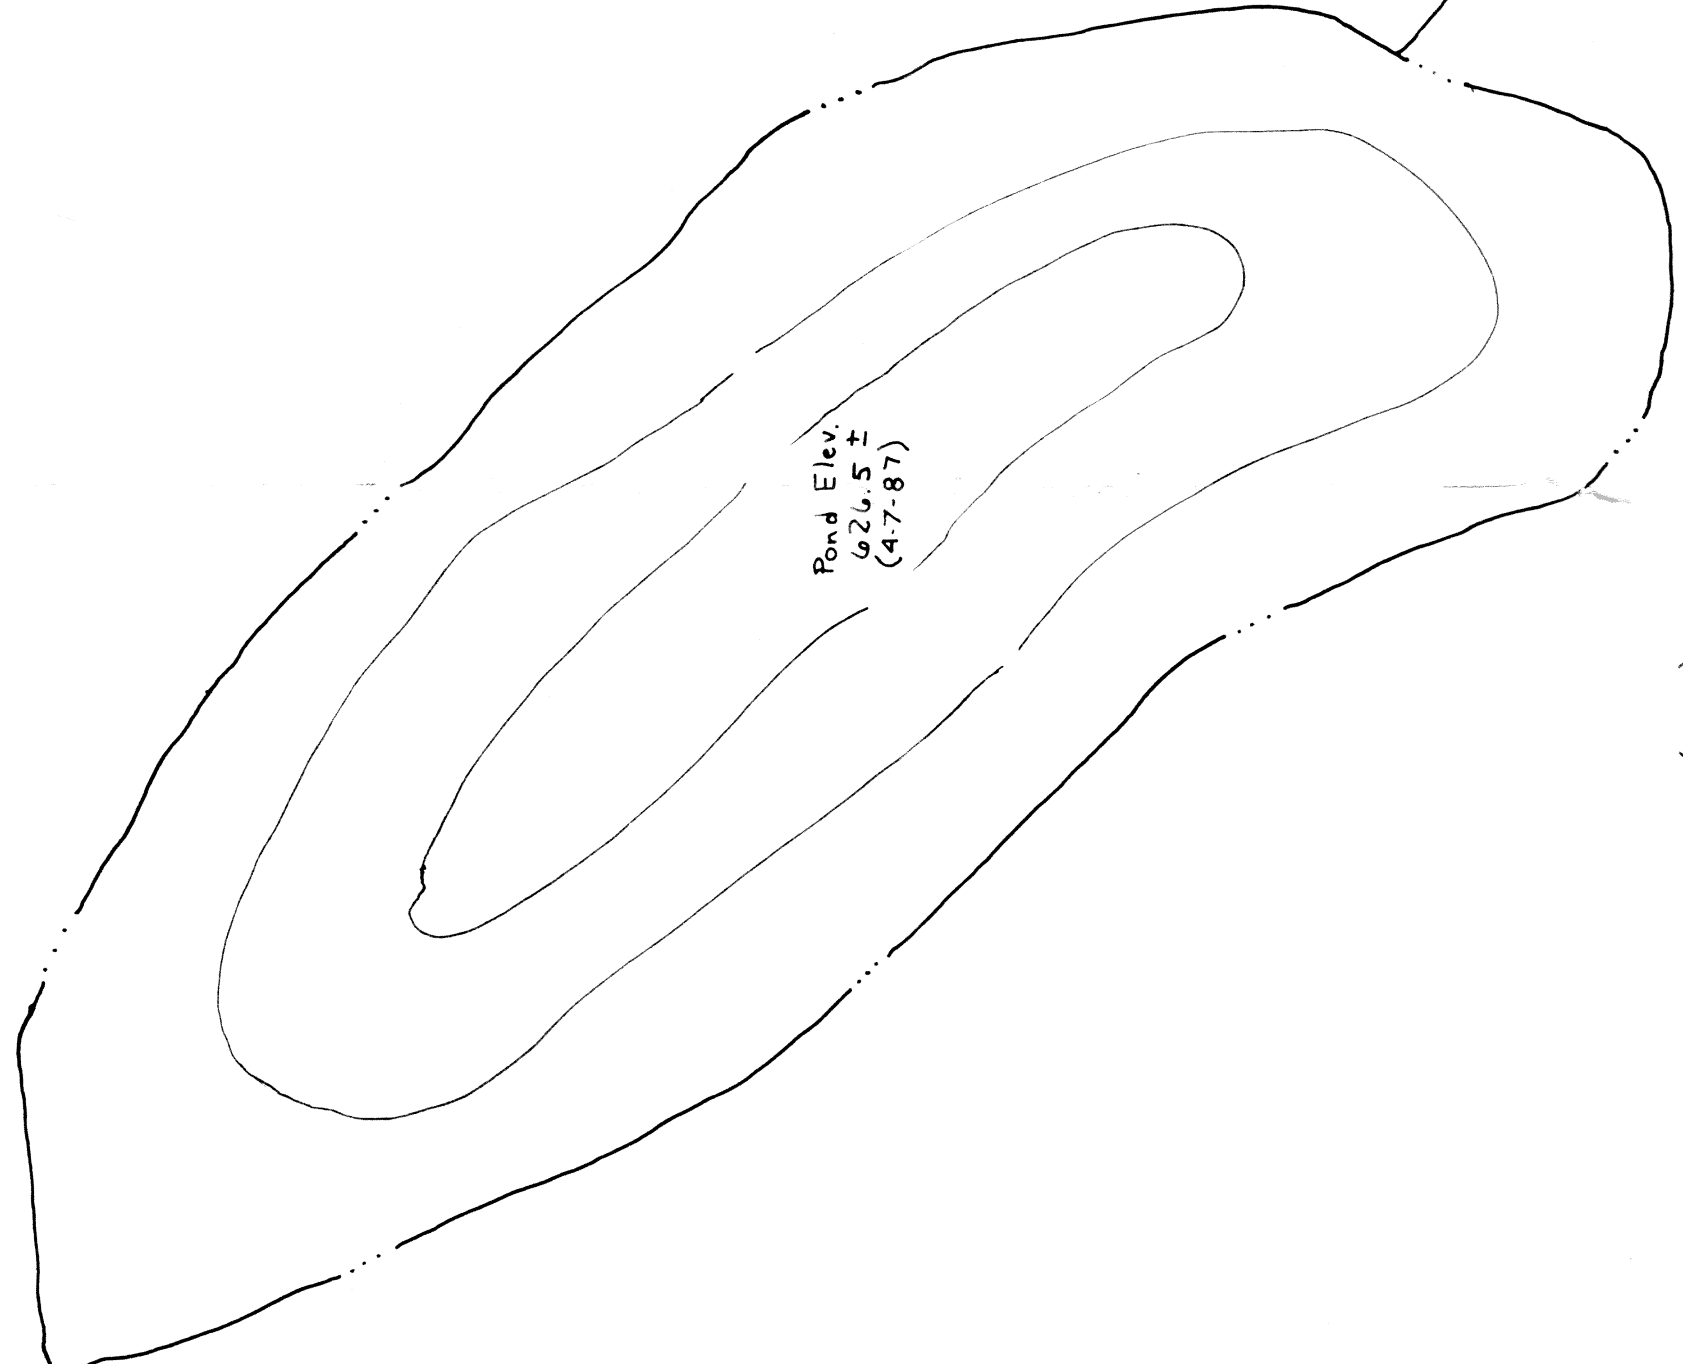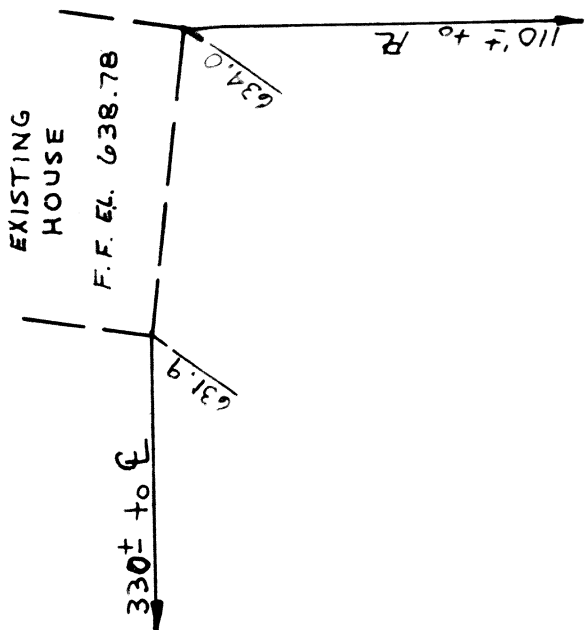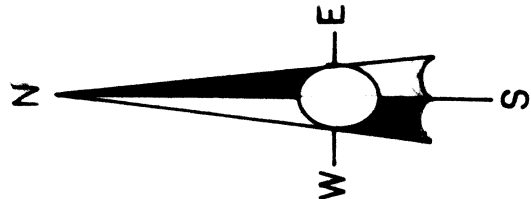

S-88-22-03-W (Obs.)

NOTES: HOUSE, WALK WAY
2. SANITARY MANHOLE
3. HYDRANT
4. ANTI-SIPHON VALVE
5. SEPTIC SYSTEM

APPROVED
MADISON TWP. ZONING
Permit 12068
Zoning Inspector *[Signature]*





A'TERRA ENGINEERING & SURVEYING
100 N ST CLAIR ST, PAINESVILLE, OH. 44062-9250

SCALE 1" = 20'
DATE March 1987
DRAWN BY
APPROVED BY D.S.

SITE PLAN FOR B. HEATH CONSTRUCTION

DRAWING NUMBER
87004700

"HYDRAULIC PROFILE"

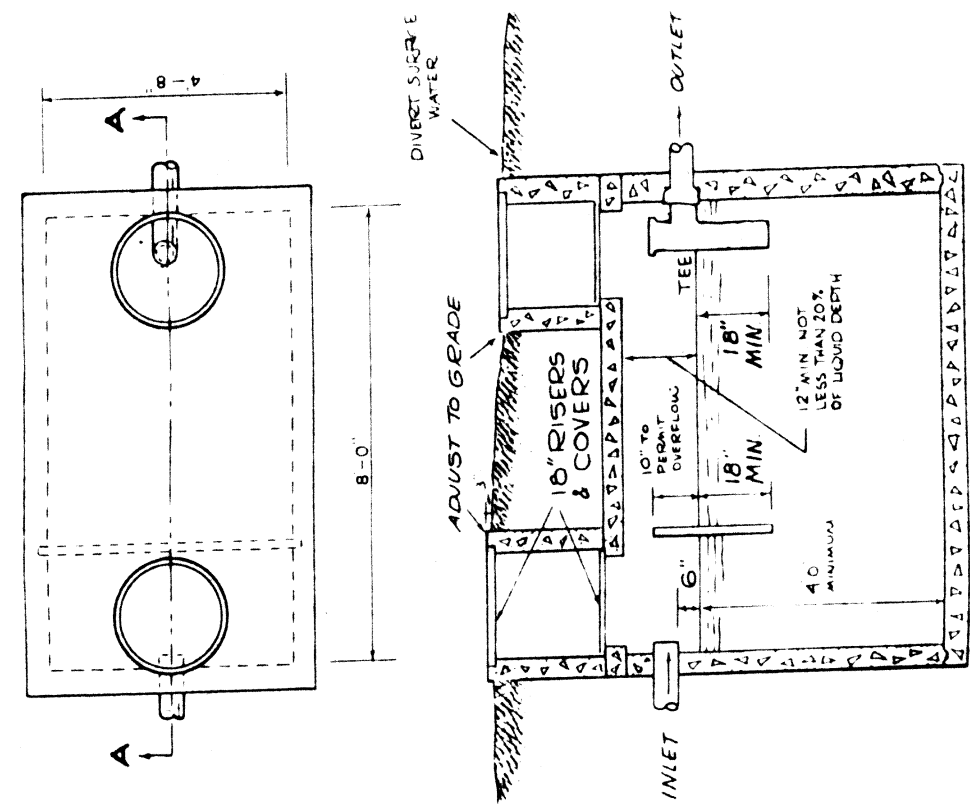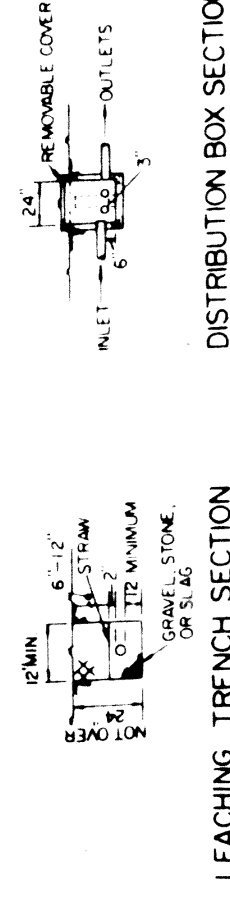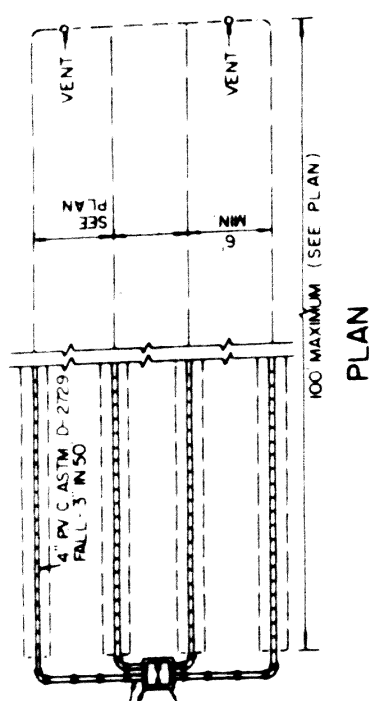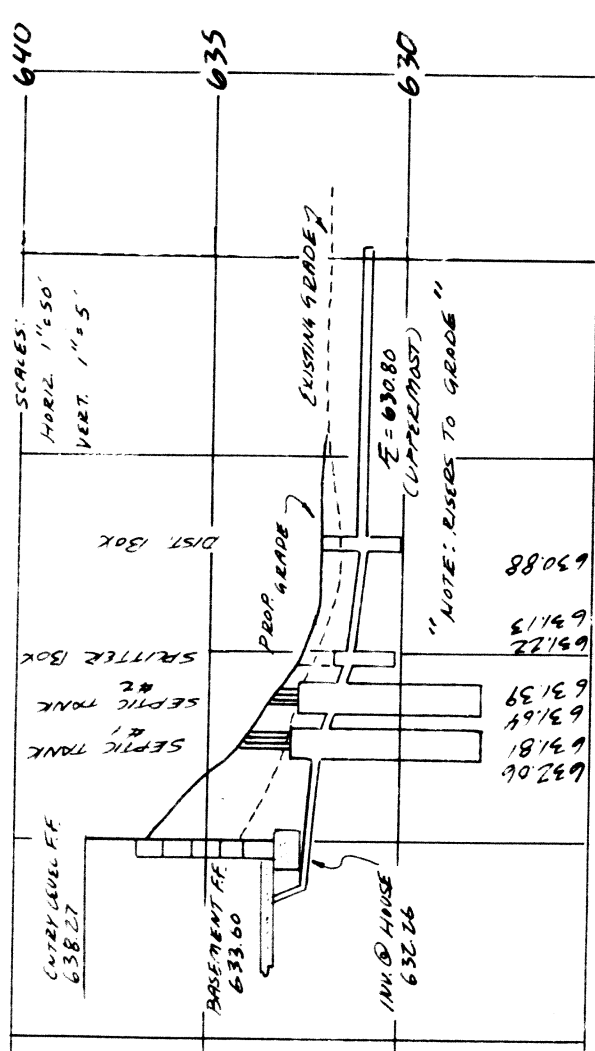

SECTION A-A SEPTIC TANK