

SITE PLAN


FDR

THE TRUE SDELL'S

BEING A PART OF LOT 5, TRACT 14,
TOWNSHIP OF MARION, COUNTY OF LAKE
STATE OF OHIO.


HYDRAULIC PROFILE
VERT. 11.5' 11.6' 11.7' 11.8' 11.9' 12.0'

FF-100.45

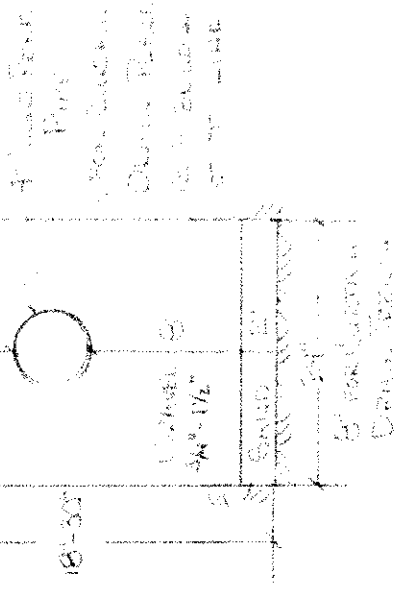

I, the undersigned, hereby certify that this topography, indicated by 1" = 20' and elevations shown herein represent an actual field survey made by me on 3-11-80 and that the elevations were taken at appropriate intervals and that as of that date they existed as indicated herein.

11/10/80 H. E. S.

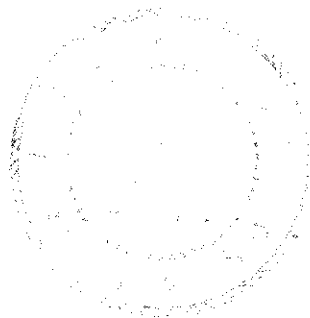

Reviewed and Accepted
LAKE COUNTY GENERAL HEALTH DISTRICT
Date 5-16-80
JOEL LUCIA, R. S., M. P., H.
Health Commissioner
Joel Lucia

LOW YIELD WATER
FIXTURES REQUIRED
ON ALL:
Shower Head
Toilet

- To be brought to finished grade
1. Septic tank cover
 2. Splitter box cover
 3. Distribution
 4. No footer drains on septic tanks
 5. No footer drains on septic tanks
 6. All waste water to be discharged into septic tanks

SEWAGE DISPOSAL PERMIT MUST BE OBTAINED BY A LAKE COUNTY LICENSED INSTALLER BEFORE INSTALLATION IS STARTED.

private
private
#1211

Grading Plan Approved
as shown and/or noted
THOMAS P. GILLES, P.E.
Lake County Engineer
By GJH Date 6/4/90

VILLAGE SURVEYING Co.
202 Third St. Fairport Har. OH 44017
(216) 357-1354

2500' TO TRACKS