


- A. To be brought to finished grade
1. Septic tank manhole covers
 2. Splitter box cover
 3. Distribution box cover
- Water drains or downspouts
 B. All discharged into septic tanks
 C. All waste water to be discharged into septic tanks

BENCH MARK
 TOP OF HYDRANT
 ELEV. 100.00 ft

LOW YIELD WATER
 FIXTURES REQUIRED
 ON ALL:
 Shower Head
 Toilet

SEWAGE DISPOSAL PERMIT MUST BE
 OBTAINED BY A LAKE COUNTY LICENSED
 INSTALLER BEFORE INSTALLATION IS
 STARTED.

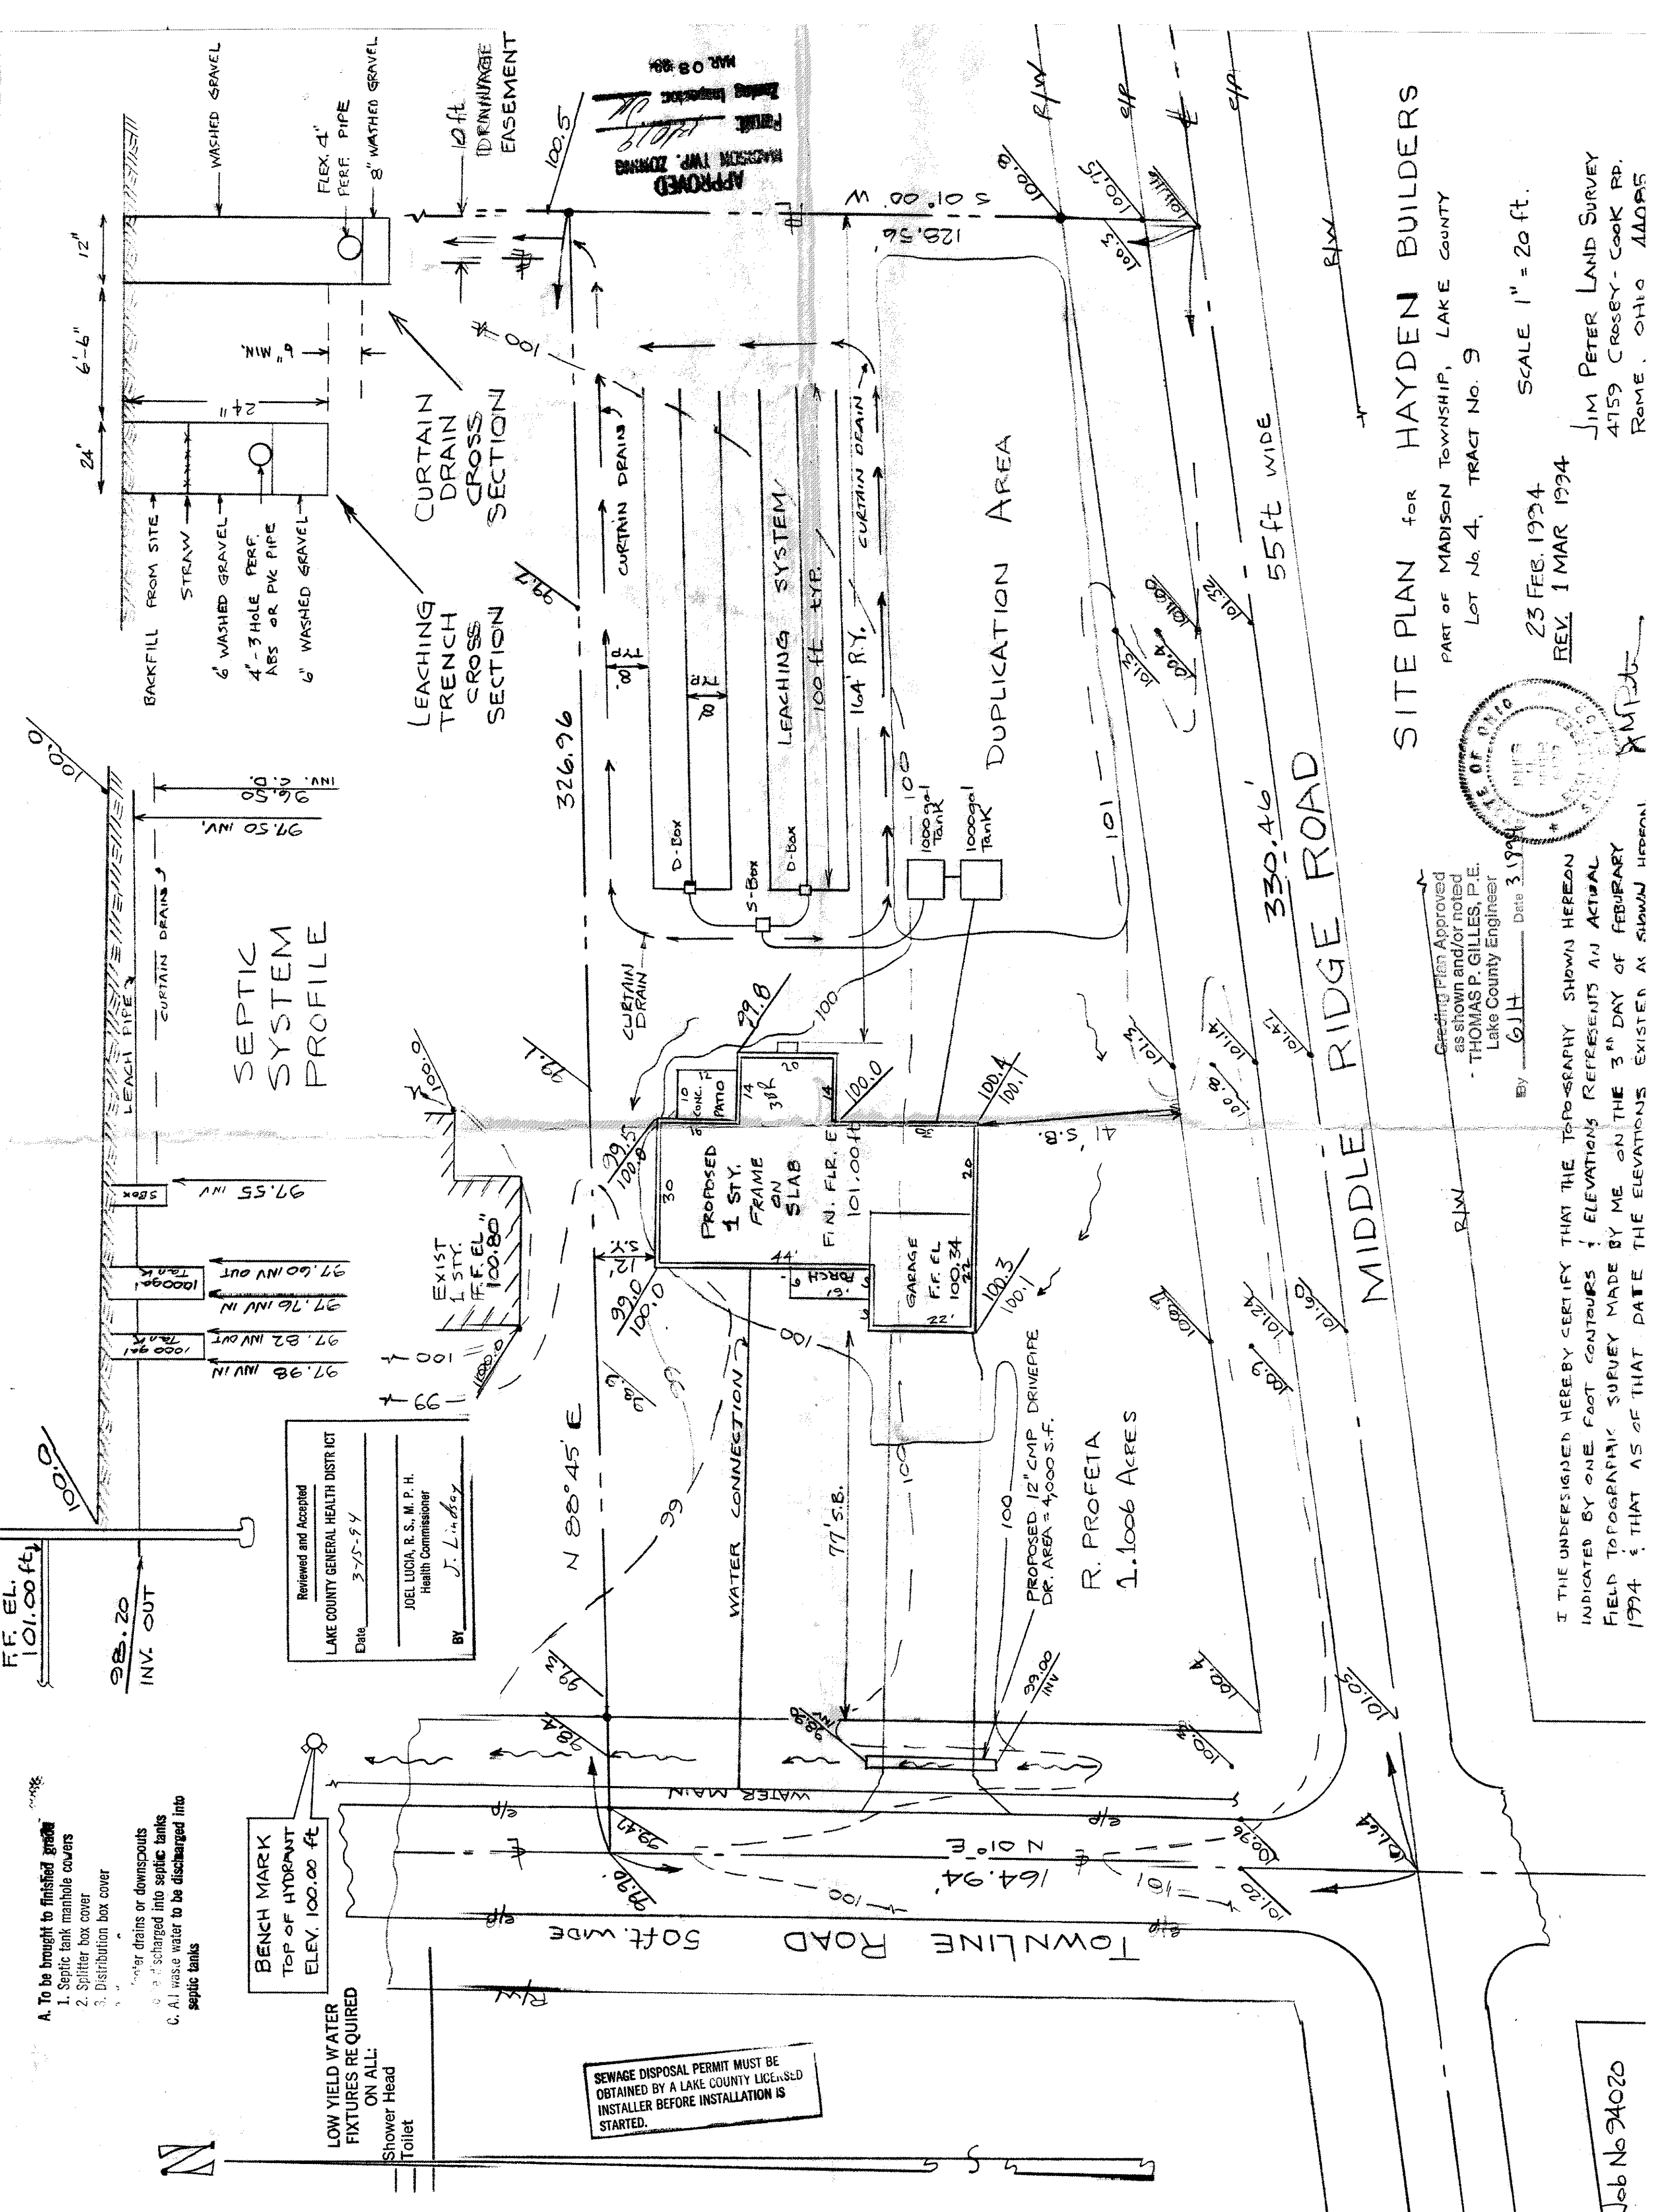


Reviewed and Accepted
 LAKE COUNTY GENERAL HEALTH DISTRICT
 Date 3-5-94
 BY J. Lindley
 JOEL LUCIA, R. S., M. P. H.
 Health Commissioner

SITE PLAN for HAYDEN BUILDERS

PART OF MADISON TOWNSHIP, LAKE COUNTY
 LOT No. 4, TRACT No. 9

SCALE 1" = 20 ft.

23 FEB. 1994
 REV. 1 MAR 1994

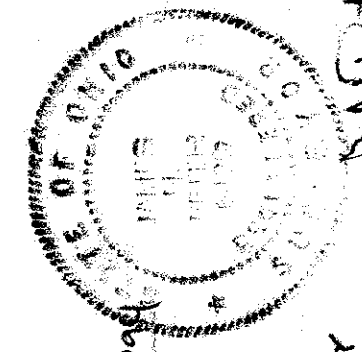

I, THE UNDERSIGNED HEREBY CERTIFY THAT THE TOPOGRAPHY SHOWN HEREON
 INDICATED BY ONE FOOT CONTOURS & ELEVATIONS REPRESENTS AN ACTUAL
 FIELD TOPOGRAPHIC SURVEY MADE BY ME ON THE 3RD DAY OF FEBRUARY
 1994 & THAT AS OF THAT DATE THE ELEVATIONS EXISTED AS SHOWN HEREON

JIM PETER LAND SURVEY
 4759 CROSEY - COOK RD.
 ROME, OHIO 44095

Job No 24020