


SCALE: 1"=20'

EXIST.
PROP.


SITE PLAN

FOR
P.R.M. DEVELOPERS, INC.
BEING KNOWN AS 24, MOORE'S LANDING
SUBDIVISION IN MADISON TOWNSHIP, LAKE COUNTY,
OHIO.

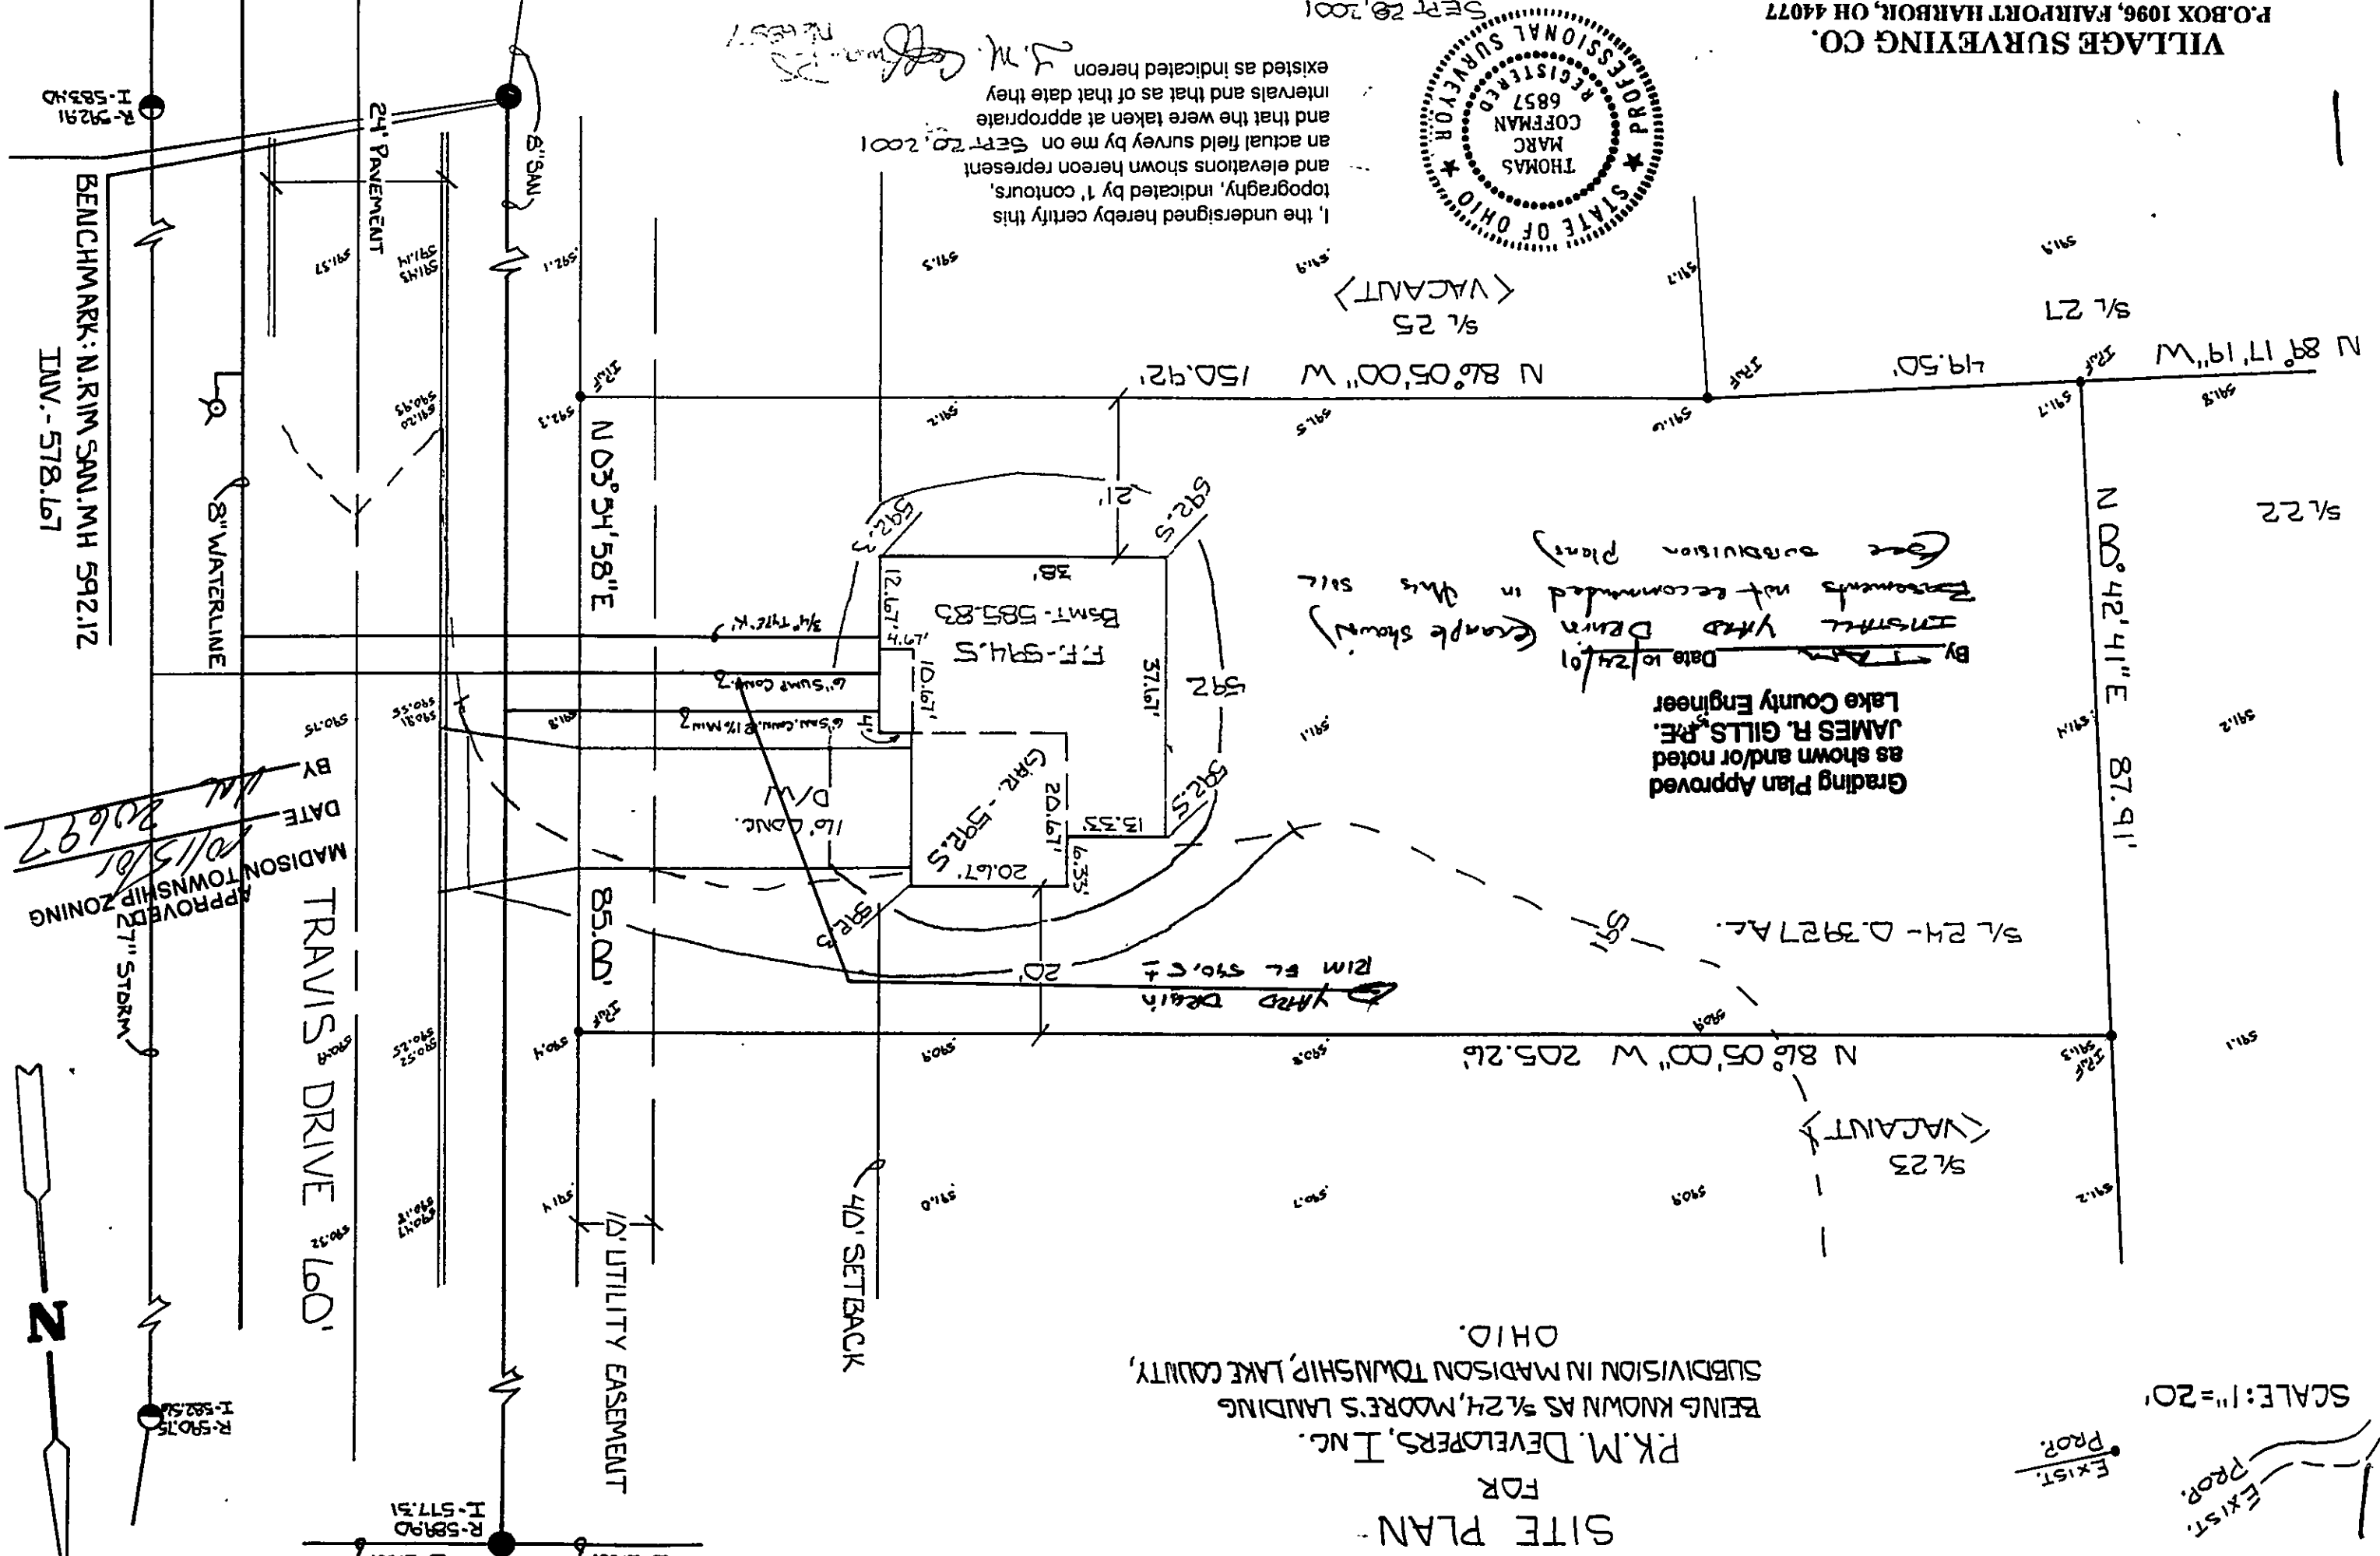

Grading Plan Approved
as shown and/or noted
JAMES R. GILLS, P.E.
Lake County Engineer

By J.R.G. Date 10/24/01
Install Yard Drain (example shown)
Easements not recommended in this site
(see subdivision plans)

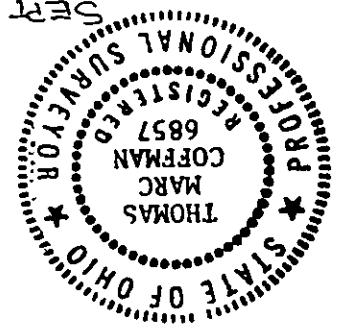

I, the undersigned hereby certify this topography, indicated by 1' contours, and elevations shown hereon represent an actual field survey by me on SEP 20, 2001 and that the were taken at appropriate intervals and that as of that date they existed as indicated hereon

J.M. Coffman
No. 6857

VILLAGE SURVEYING CO.
P.O. BOX 1096, FAIRPORT HARBOR, OH 44077
(440) 357-1359