

BUD HOPKINS

TOWNSHIP OF MADISON
COUNTY OF LAKE STATE OF OHIO


**Grading Plan Approved
as shown and/or noted
THOMAS P. GILLES, P.E.
Lake County Engineer**

By TAM Date 8/18/00
Sworn as shown

DISTURBED AREAS ARE
TO BE RE-SEEDED.

TEMPORARY STONE
TO BE INSTALLED
AT DRIVE ENTRANCE.

SEWER AND WATER
CONNECTIONS TO BE
VERIFIED AT TIME
OF CONSTRUCTION.

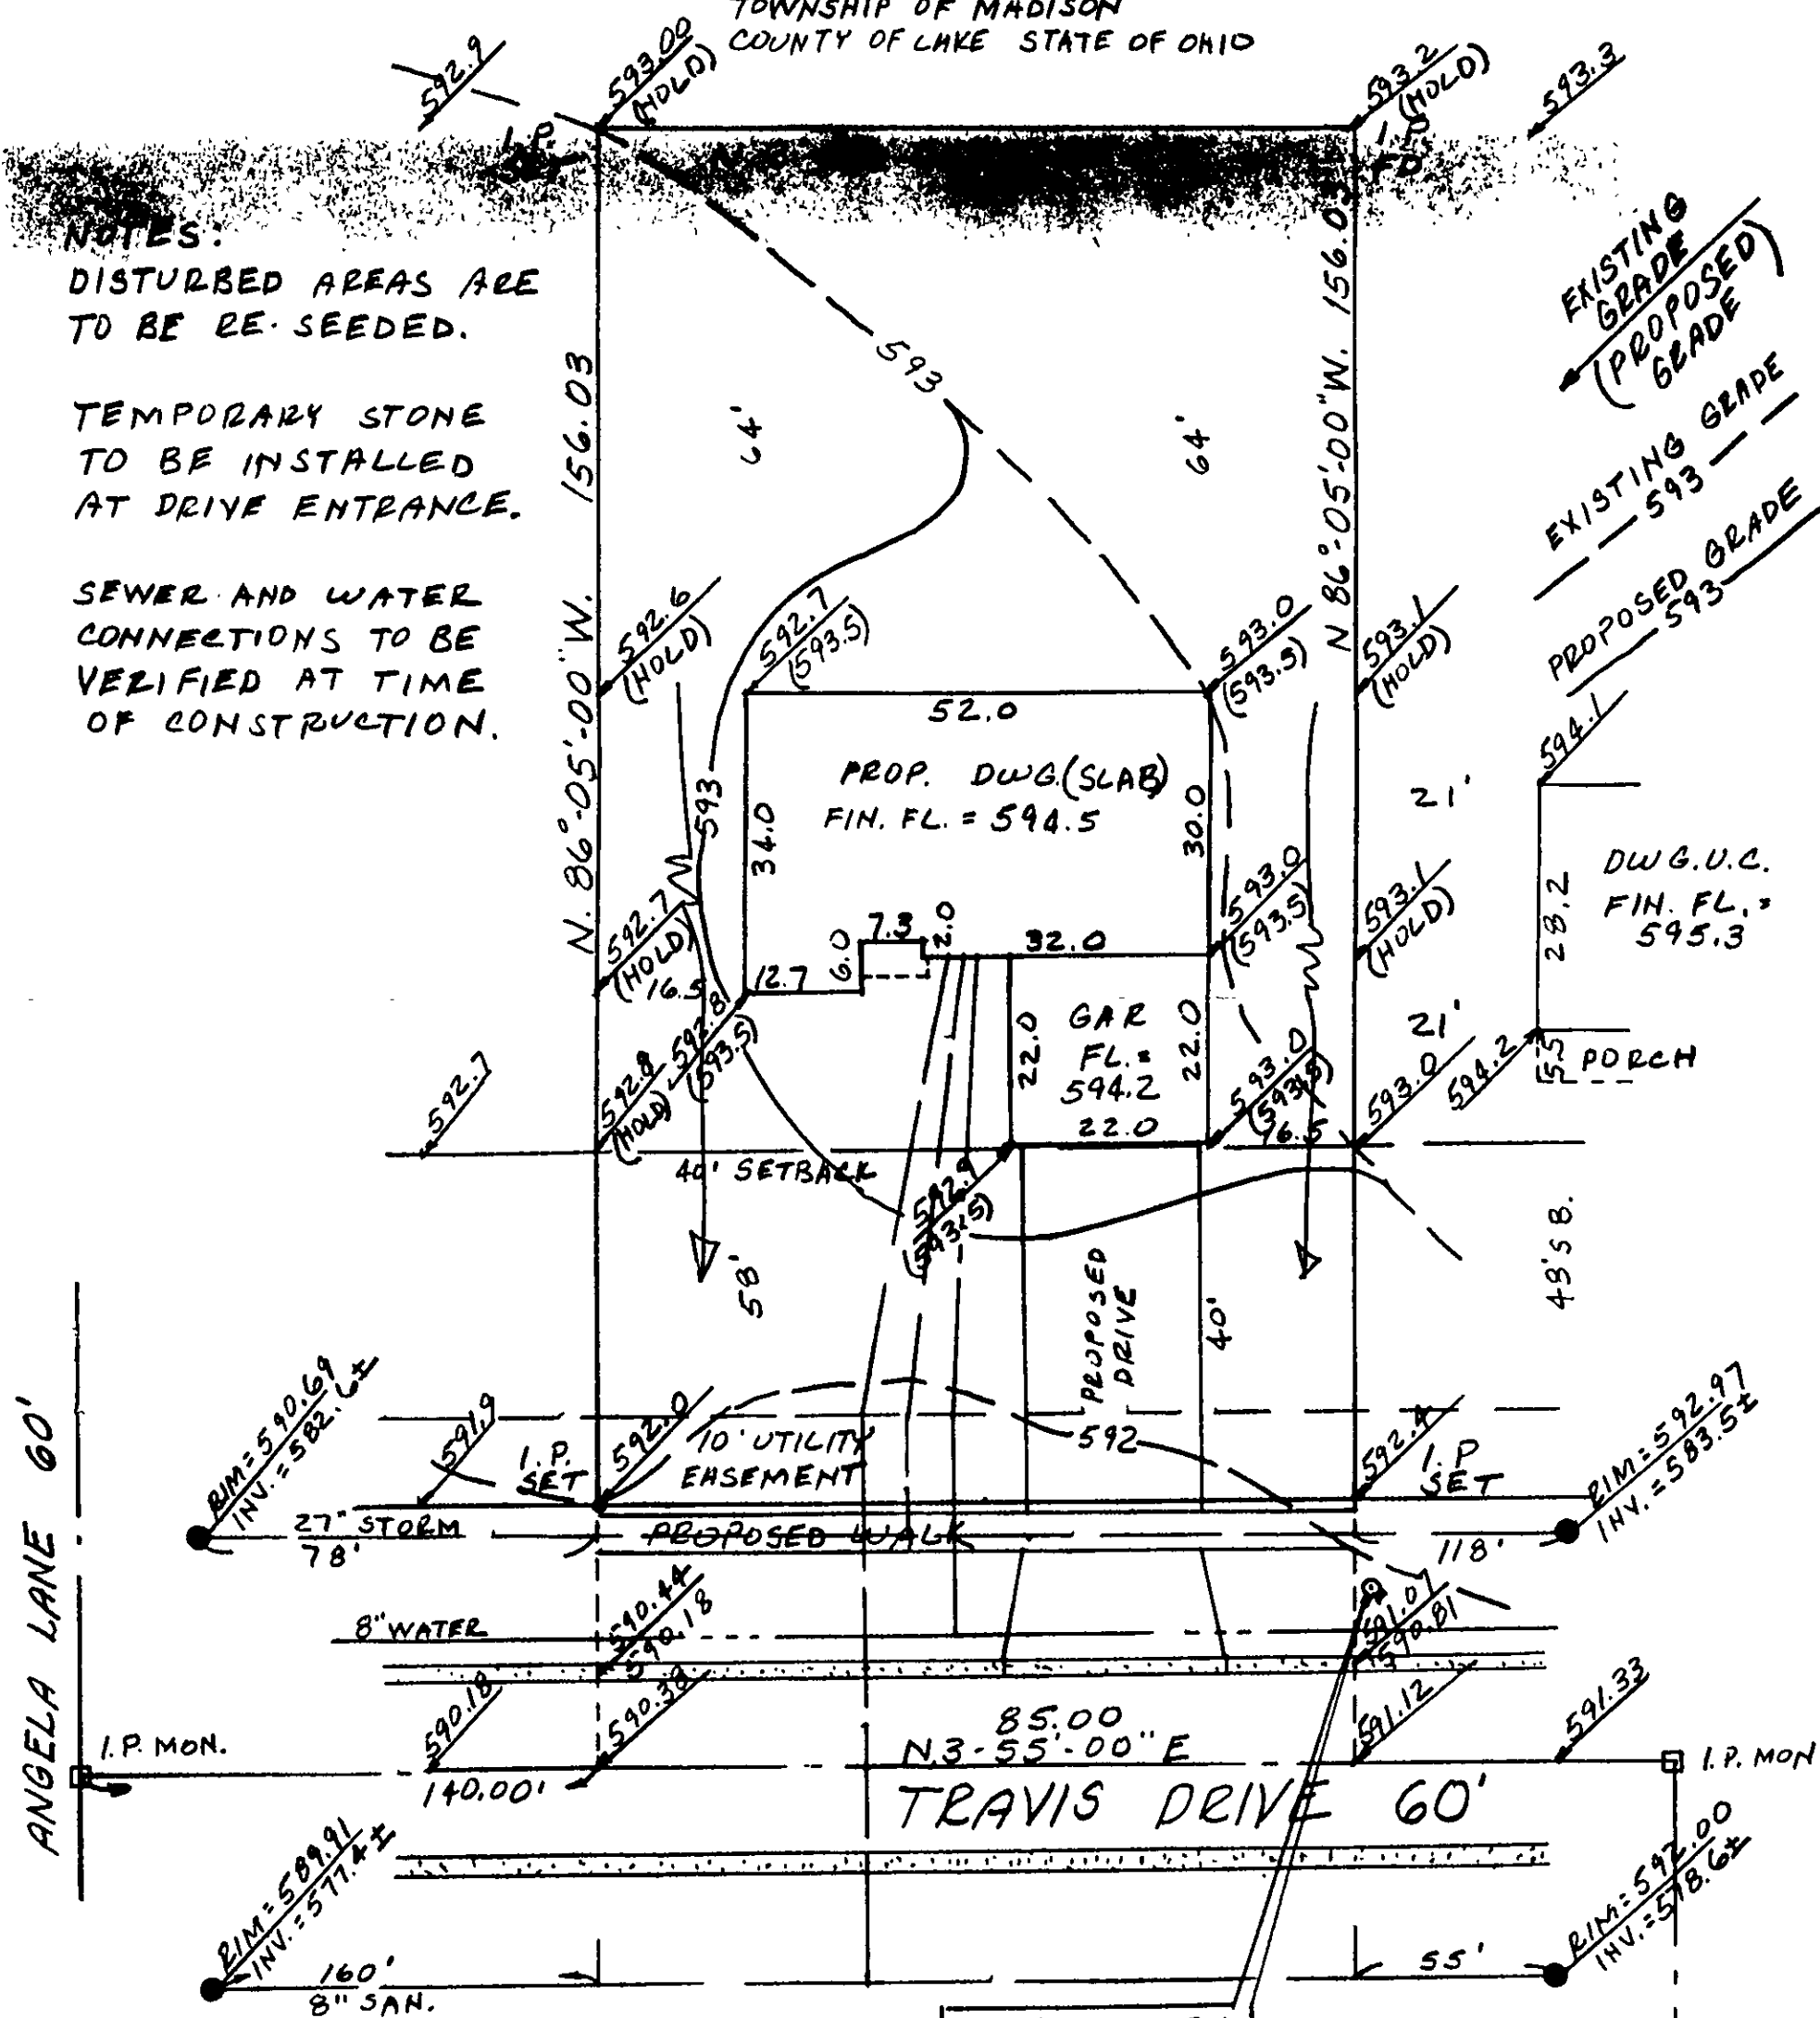

BENCH MARK
TOP OF HYD.
ELEV. = 594.25

JAMES A. ZEMBA P.S. #7094

BENCHMARK SURVEY CO.
5964 S. RIDGE RD.
MADISON, OHIO 44057
440-428-8599 AUG. 10, 2000

With no sidewalk material
in R.O.W. area
as of 8/15/10

APPROVED
MADISON TOWNSHIP ZONING
DATE 8/15/00
BY JM 20263

