

SITE PLAN


FOR

PKM Developers, Inc.

BEING SUBLOT No. 37, IN THE MOORE'S LANDING
SUBDIVISION, IN THE TOWNSHIP OF MADISON,
LAKE COUNTY, OHIO.

Grading Plan Approved
as shown and/or noted
JAMES R. GILLS, P.E.
Lake County Engineer

By JAM Date 6/25/01
Install yard drain (Example shown)
Basements not recommended in
(See subdivision plans)

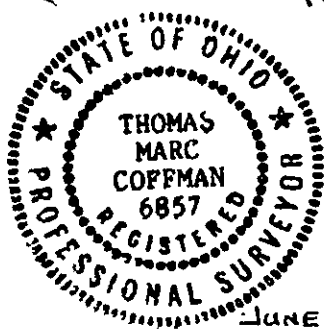

JUNE 8, 2001


I, the undersigned hereby certify this
topography, indicated by 1' contours,
and elevations shown hereon represent
an actual field survey by me on June 8, 2001
and that the were taken at appropriate
intervals and that as of that date they
existed as indicated hereon.

J.M. Coffman P.S.
No. 6857

VILLAGE SURVEYING Co.

P.O. BOX 1096, FAIRPORT HBR, OH 44077

(440) 357-1359

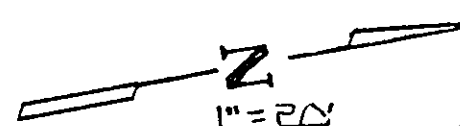

BENCHMARK-592.30
N. Rim 5m MH: Inv-586.89

8" SAN @ 0.4%
R-592.16

N 85° 09' 10" W 151.25' 03"
TRAVIS DR. (A)

APPROVED
MADISON TOWNSHIP ZONING
DATE 6/22/01
BY DM 20563