



SCALE: 1"=20'

SITE PLAN

FOR

PKM DEVELOPER'S INC.
BEING KNOWN AS S/L 34, IN MADRE'S
LANDING SUBD., IN MADISON TOWNSHIP,
LAKE COUNTY, OHIO

BENCHMARK - 592.02
N.R.M. SAN MH - INV. - 581.72

Grading Plan Approved
as shown and/or noted
THOMAS P. GILLES, P.E.
Lake County Engineer

By T. Am Date 8/25/00

Swale as shown
install YARD DRAIN Example shown & ATTACHED

N 00° 51' 48" W 179.39'

Install
YARD
DRAIN
Per sw.
Plan
Example shown

N 89° 17' 19" W 118.84'


N 15° 51' 24" W 157.50'

S/L 35 <VACANT>

VILLAGE SURVEYING CO.
P.O. BOX 1096
FAIRPORT HARBOR, OH 44077

40' SETBACK

TRAVIS DRIVE 60'

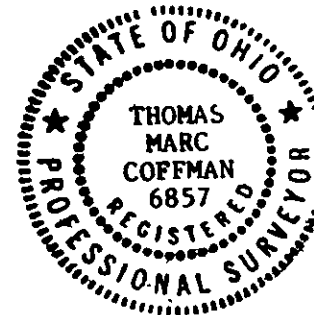

July 25, 2000
REV 8-22-00 HSE

I, the undersigned hereby certify that
this topography, indicated by 1' contours
and elevations shown hereon represent an
actual field survey made by me on July 11, 2000
and that the elevations were taken at
appropriate intervals and that as of that
date they existed as indicated hereon.

Thomas Marc Coffman
P.E.
No. 6857

APPROVED
MADISON TOWNSHIP ZONING

DATE

BY

8/27/00
UM 20258