


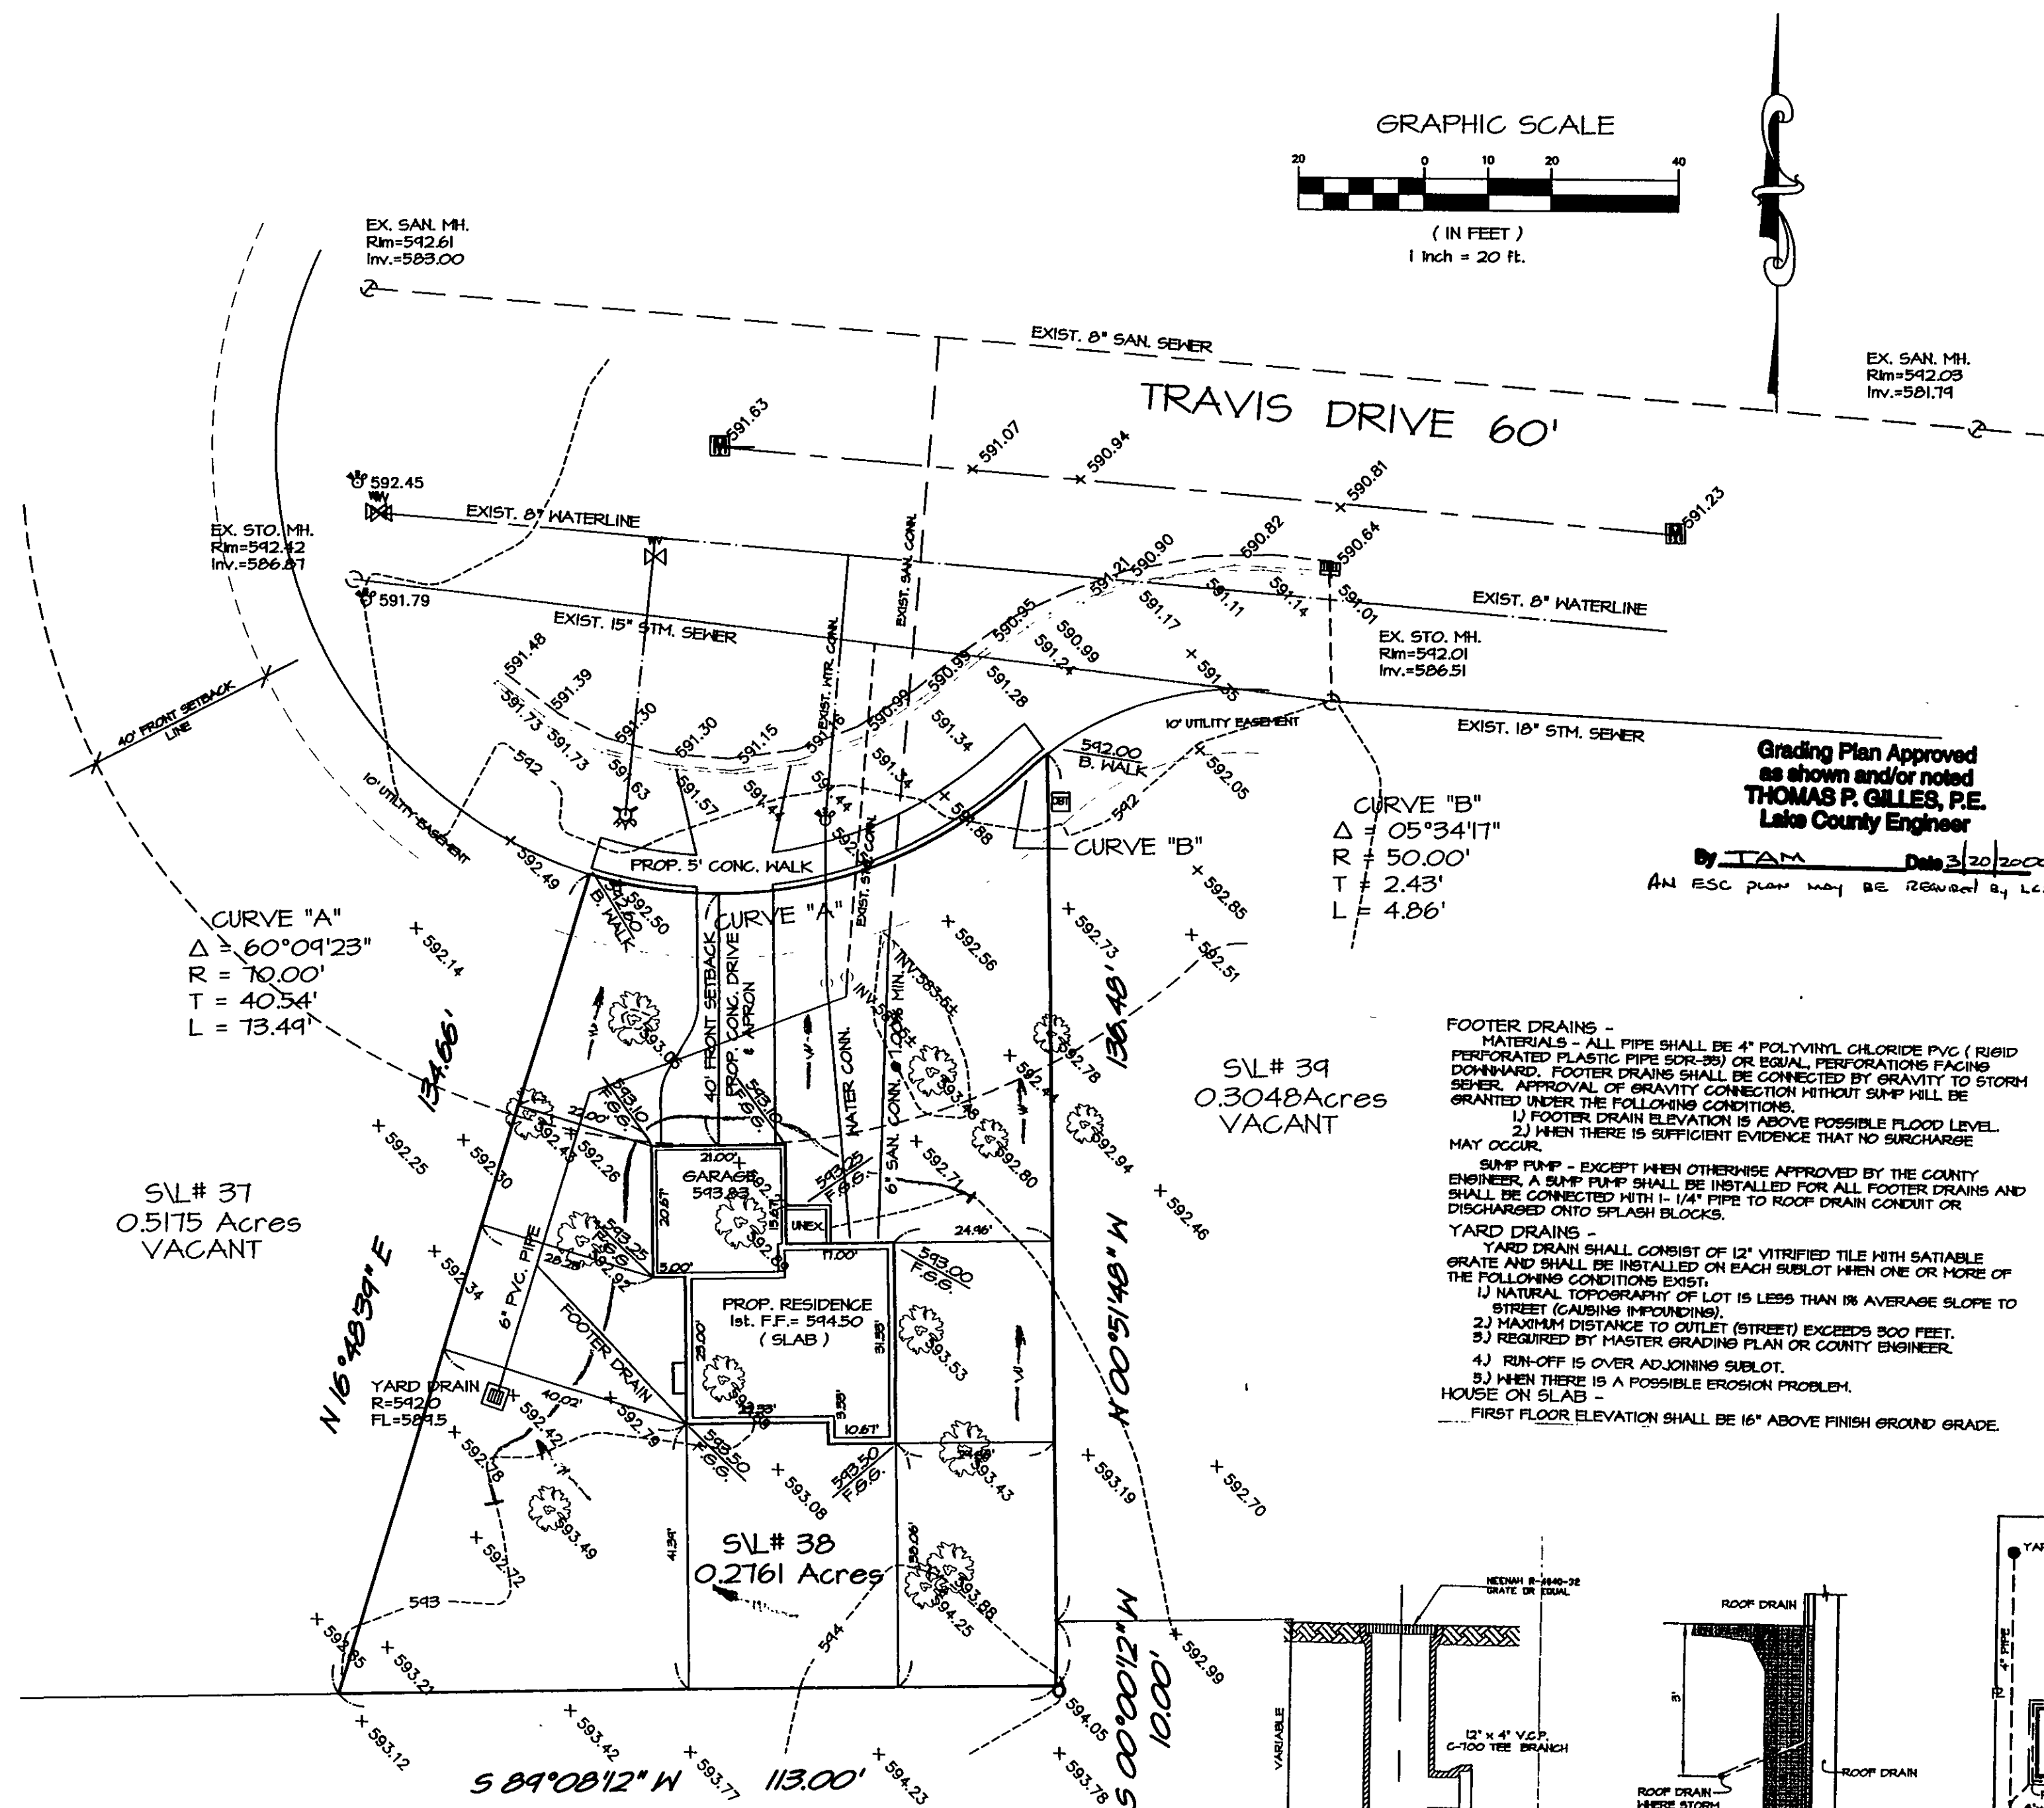



Grading Plan Approved
as shown and/or noted
THOMAS P. GILLES, P.E.
Lake County Engineer

By TAM Date 3/20/2000
AN ESC plan may BE REVERSED BY L&S

FOOTER DRAINS -
MATERIALS - ALL PIPE SHALL BE 4\"

YARD DRAINS -
YARD DRAIN SHALL CONSIST OF 12\"

HOUSE ON SLAB -
FIRST FLOOR ELEVATION SHALL BE 16\"

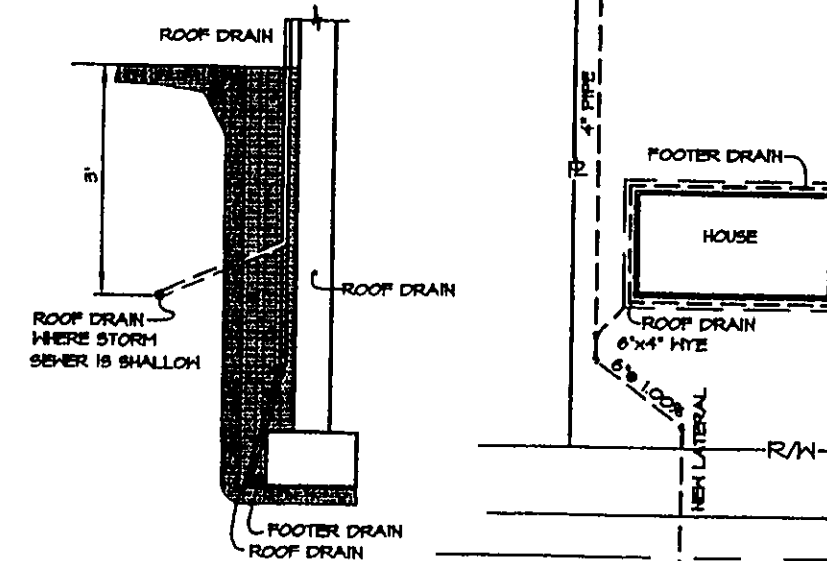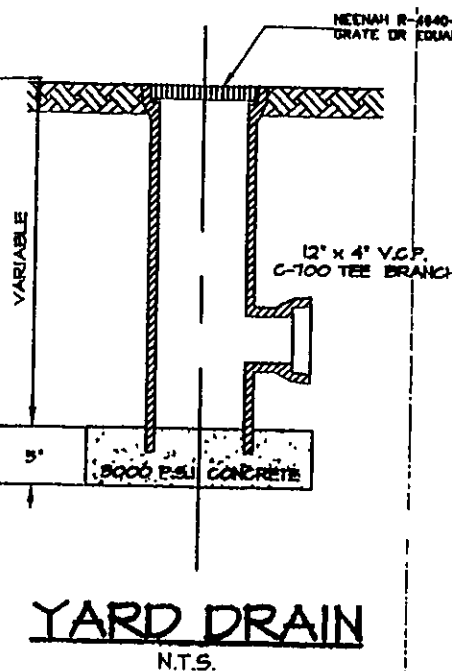

SITE PLAN

For: CUSTOM CRAFTED HOMES

ADDRESS STREET MADISON CITY

SUBLOT No. SVL# 38 MOORE'S LANDING SUBD. SUBDIVISION NAME VOL. PAGE

MADISON TOWNSHIP TRACT-LOT MADISON CITY



CHECK LIST

LOT DIMENSIONS & BEARINGS
TIE TO NEAREST STREET
SUBLOT No. (PARCEL No.)
SURROUNDING OWNERS
BUILDING DIMENSIONS
SETBACK, SIDEYARD, REARYARD
FINISHED GRADES
DRIVE & APRON TYPE, WIDTH, THICKNESS
SIDEWALK TYPE, WIDTH, THICKNESS
CULVERT TYPE, DIA., LENGTH
WATER MAIN SIZE, LOCATION
SAN. SEWER SIZE, % GRADE, LOCATION
SAN. MH. CAST. ELEV., INV. ELEV.
SAN. CONN. SIZE, % GRADE, LOCATION
STORM SEWER SIZE, % GRADE, LOCATION
STORM MH. CAST. ELEV., INV. ELEV.
PAV'T. TYPE, GRADE, CURBS
6\"



STATE SEAL

DESIGN CERTIFICATION

THIS PLAT WAS PREPARED BY ME, AND IS CORRECT
TO THE BEST OF MY KNOWLEDGE AND BELIEF.

DAVID A. PIETRANTONE P.E. : E-61756

"AS-BUILT" CERTIFICATION

I HEREBY CERTIFY THAT THE CIRCLED INFORMATION IS EXISTING
AS OBTAINED ON THE SITE 19 AND IS
CORRECT TO THE BEST OF MY KNOWLEDGE AND BELIEF.

DAVID A. PIETRANTONE P.E. : E-61756

LEGEND

STORM MANHOLE
SANITARY MANHOLE
EXISTING CONTOURS
PROPOSED CONTOURS

PROP. FG
EXIST. ELEV.
DIRECTION OF SURFACE DRAINAGE

DRAWN BY
D. Abbott
CHK'D BY
DATE
MARCH 13, 2000
JOB No.

#00-*018

BENCHMARK:

TOP OF EXISTING FIRE HYDRANT
SOUTH SIDE OF CUL-DE-SAC
ELEVATION = 594.80

CONTRACTOR TO VERIFY:
1. FIN. FLR. ELEVATIONS & HSE. SIZES.
2. LOCATION & ELEVATIONS OF EXIST.
UTILITY CONNECTIONS.
"BEFORE STARTING CONSTRUCTION"

APPROVED
MADISON TOWNSHIP ZONING
DATE 3/12/00
BY du 20047

PRINTED
MAR 16 2000

LAKE INC.

#00-018