


I, further certify that the topography, indicated by 1 foot contours and elevations shown hereon represent an actual field survey made by me on Oct. 2, 2002 and the elevations were taken at the appropriate intervals and that as of that date they existed as indicated hereon.

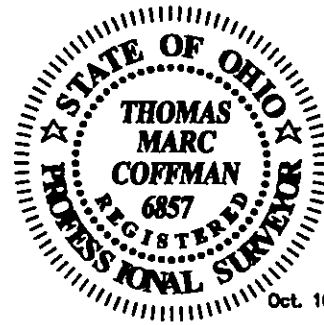

Oct. 10, 2002

Being Sublot No. 33 of the Moore's  
Landing Subdivision, in the Township of  
Madison, County of Lake , State of Ohio.

