

1/2

## SITE PLAN

MADISON TOWNSHIP, LAKE COUNTY, OHIO

for: NORTHCOAST HOMES

CLIENT		OWNER	
ADDRESS	STREET	CITY	ZIP
MOORES LANDING		TRACT	STREET
SUBDIVISION 35-16	NAME	LOT	
30	VOL-16	TRAVIS DRIVE	
SUBLOT NO.	STREET	VOL-PG.	PERM. PARCEL NO.

## LEGEND

SANITARY MANHOLE	---○---	1	100.0	100.0 ± 2	PROP. ELEV.
STORM MANHOLE	---●---	2			
INLET OR CATCH BASIN	---○---	3			
HYDRANT	---○---	4			
EXISTING CONTOURS	---○---	5			
PROPOSED CONTOURS	---○---	6			

AS BUILT ELEVATION

INDICATES DIRECTION OF SURFACE DRAINAGE

## REMARKS

ALL BOUNDARY DATA SHOWN WAS OBTAINED FROM (DEEDS, RECORDED SUBDIVISION PLAT OR OTHER PUBLIC RECORDS)

LOCATIONS AS SHOWN OF ADJACENT WELLS AND SEPTIC TANKS OBTAINED FROM LAKE COUNTY HEALTH DEPARTMENT

## DESIGN CERTIFICATION

THIS PLAT WAS PREPARED BY ME, AND IS CORRECT TO THE BEST OF MY KNOWLEDGE AND BELIEF.

NAME: *James H. Jones* SURVEYOR REGISTRATION NO. 46313

## CHECK LIST

NO. OF BEDROOMS	WATER MAIN SIZE, LOCATION
DIMENSIONS	SAN. SEWER SIZE & OR. LOC.
BEARINGS	SAN. MH. CAST. ELEV. INV. ELEV.
TIE TO NEAREST STREET	SAN. CONN. SIZE, LOC. DEPTH
SUBLOT NO. PARCEL NO.	STORM SEWER SIZE & OR. LOC.
SURROUNDING OWNERS	STORM MH. CAST. ELEV. INV. ELEV.
BLDG. DIMENSIONS FIN OR.	PAV'T TYPE GRADE CURBS
BLDG. TIES FL'R. GRADES	GAS LINE LOC. SIZE PRESSURE
APRON TYPE WIDTH THICKNESS	SEPTIC TANK LOCATION & DUPLICATION AREA
SIDEWALK TYPE WIDTH THICKNESS	WELL LOCATION
CULVERT TYPE DIA., LENGTH	ISOLATION RADIUS FROM WELL
ROCK OUTCROPPINGS	

REVISIONS			PLAN PREPARED BY:	
NO.	DATE	BY	BABCOCK JONES & ASSOCIATES, INC.	
1	6/8/04	N.S.	PAINESVILLE, OHIO	
2				
3			DRAWN BY N.S.	SCALE 1"=20'
4			CHK'D. H.J.	DATE 6/3/04
5			APP'D. E.W.H.	DATE 6/14/04

"AS BUILT" CERTIFICATION

I, HEREBY CERTIFY THAT THE CIRCLED GRADES ARE EXISTING FINISH GRADES CHECKED IN THE FIELD ON \_\_\_\_\_, 20\_\_\_\_ AND ARE CORRECT TO THE BEST OF MY KNOWLEDGE AND BELIEF.

REGISTERED SURVEYOR

Stormwater Management Plan

Approved as shown and/or noted

JAMES H. JONES, P.E.

County Drainage Engineer

By *6/14* Date *6/14/04*


BM SANITARY MANHOLE  
ELEV-592.14

ROOF DRAINS  
SHALL DISCHARGE  
TO SPLASH BLOCKS.

APPROVED  
MADISON TOWNSHIP ZONING

DATE *6/10/04*BY *IN 21866*

EXISTING UTILITIES NOTE:  
THE SIZE AND LOCATION, BOTH HORIZONTAL AND VERTICAL OF THE UNDERGROUND UTILITIES SHOWN HEREON, HAVE BEEN OBTAINED BY A SEARCH OF AVAILABLE RECORDS. VERIFICATION BY FIELD OBSERVATION HAS BEEN CONDUCTED WHERE PRACTICAL, HOWEVER, BABCOCK, JONES AND ASSOCIATES INC. DOES NOT GUARANTEE THE COMPLETENESS NOR ACCURACY THEREOF.

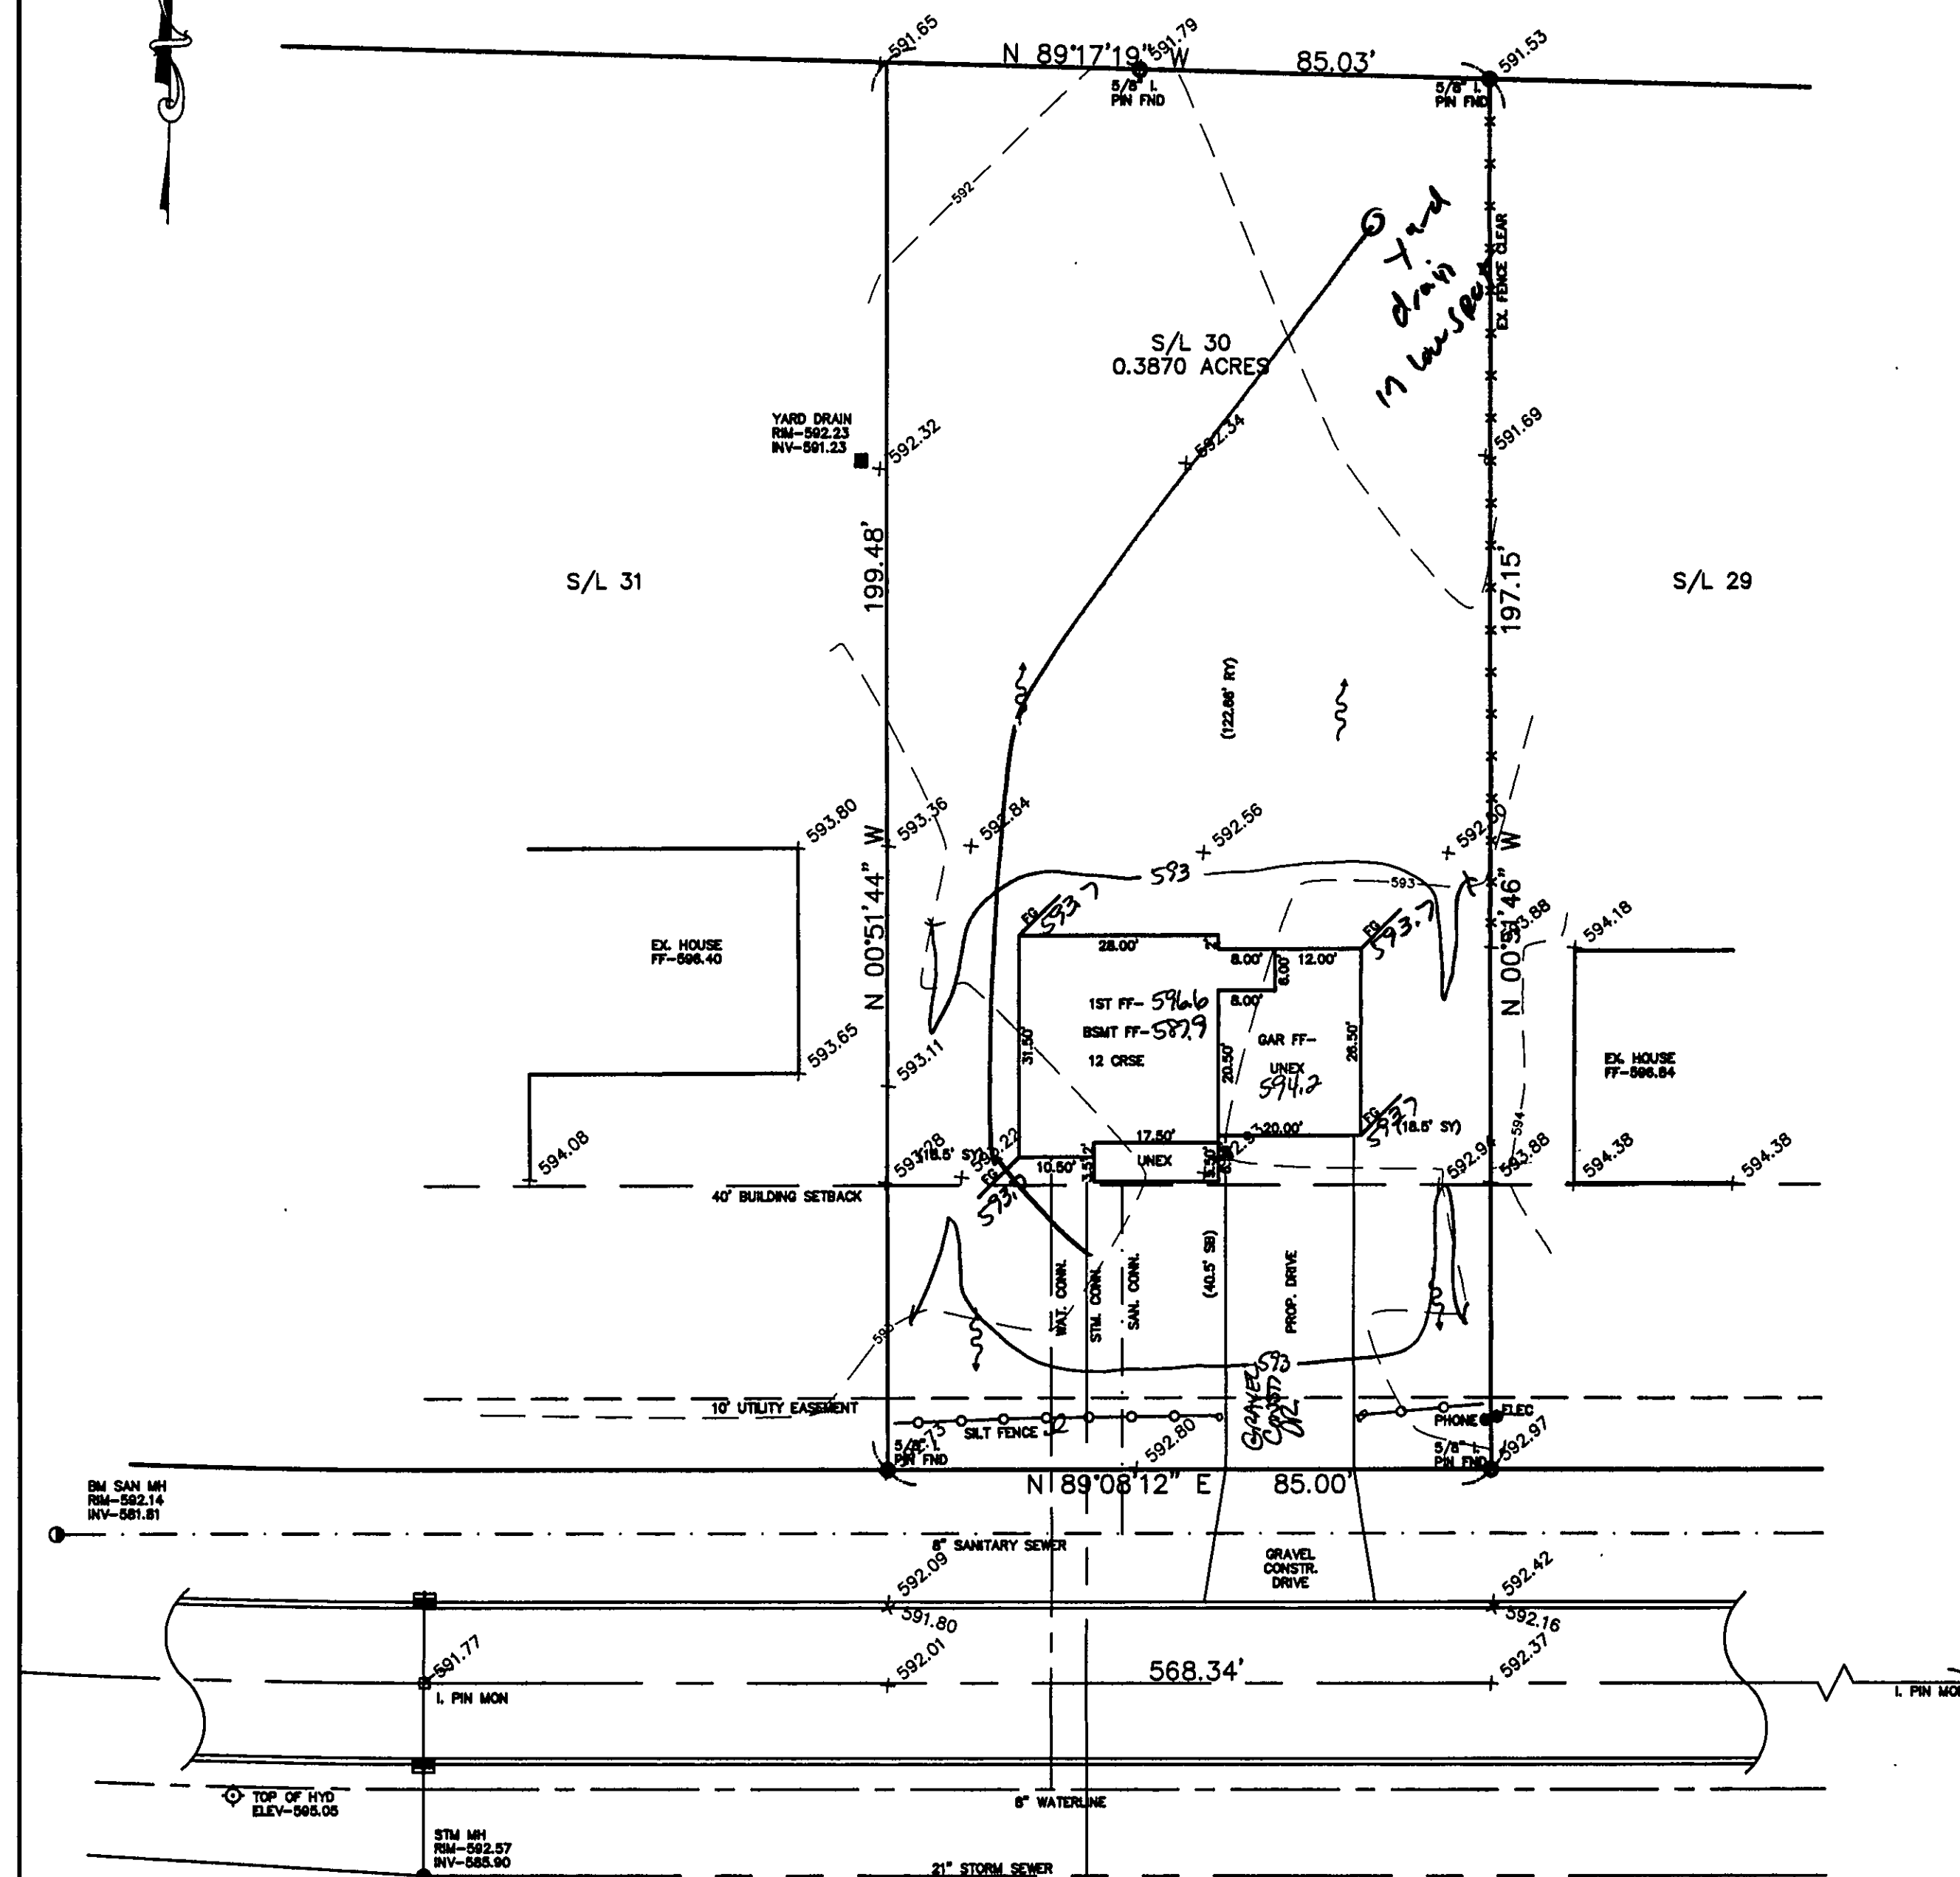

TRAVIS DRIVE - 60'