

SCALE: 1" = 20'

SITE PLAN

FOR

PKM DEVELOPER'S INC.
BEING KNOWN AS S/L 29 IN MOORE'S LANDING
SUBDIVISION IN MADISON TOWNSHIP, LAKE
COUNTY, OHIO.

EXIST.
PROP.

S/L 28

N 00° 51' 48" W 194.81'

N 89° 17' 19" W 85.03'

N 00° 51' 48" W 197.14'


S/L 30
(VACANT)

VILLAGE SURVEYING CO.

P.O. BOX 1096 FAIRPORT HARBOR, OHIO 44077

(440) 357-1359

I, the undersigned hereby certify that
this topography, indicated by 1' contours
and elevations shown hereon represent an
actual field survey made by me on May 1, 2001
and that the elevations were taken at
appropriate intervals and that as of that
date they existed as indicated hereon.

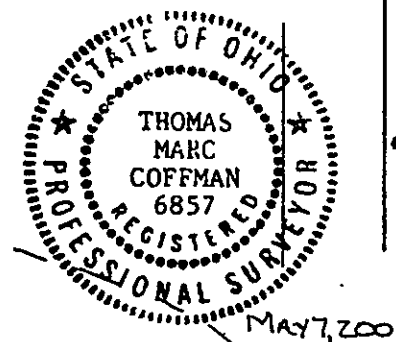

Thomas Marc Coffman
6857

6" SAN. CONN. @ 1% MIN.
6" STM. CONN. @ 1%
3/4" TYPE 'K'

16' CONC. P/W

6' CONC. APPROX.

8" SAN. 7

8" WATERLINE 7

21" STORM

TRAVIS DRIVE 60'

BENCHMARK - 593.08
N.R.M. SAN. MH - INV. 580.61

APPROVED TOWNSHIP ZONING
DATE 5/20/01
BY CLK 2048

Grading Plan Approved
as shown and/or noted
JAMES R. GILLS, P.E.
Lake County Engineer

By TAM Date 5-14-01
1. Install yard curb (example shown)
2. Basements not recommended for this
soil (See subdivision plans)