
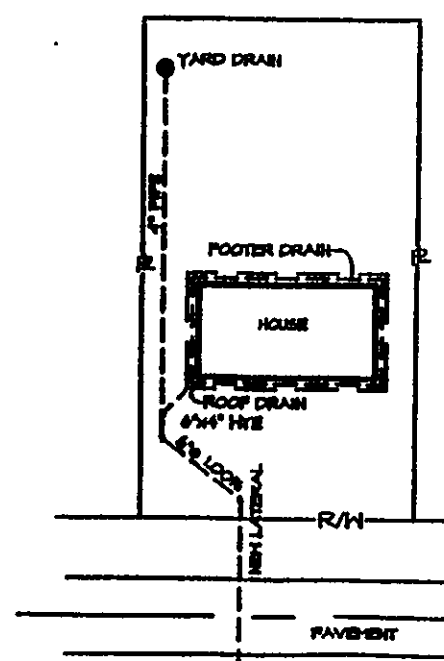


1. ~~PROPOSED~~
~~EXISTING~~ GROUND GRADES
2. ~~+~~ ~~mm~~ OVERLAND DRAINAGE FLOW
3. BENCH MARK TOP OF LAND FRONT OF
SUBLOT NO. 46 ELEV 596.64
4. ---590--- EXISTING CONTOURS
5. ---390--- PROPOSED CONTOURS
6. • I.P.S. = 5/8" IRON PIN SET WITH CAP. OR FOUND
7. ROOF DRAINS SHALL DISCHARGE TO
SLASH BLOCKS.
8. SUMP PUMP TO BE INSTALLED
FOR FOOTER DRAINS
9. CONTACT O.U.P.S. TWO WORKING DAYS
BEFORE DIGGING 1-800-362-2764

I CERTIFY THAT THE BOUNDARY SURVEY
IS IN ACCORDANCE WITH CURRENT MINIMUM
STANDARDS FOR BOUNDARY SURVEYS IN THE
STATE OF OHIO *David W. Kimmel D.S. 6297*

I HEREBY CERTIFY THAT ACTUAL FIELD
OBSERVATION OF ELEVATIONS HAVE BEEN
MADE BY ME ON THE
CIRCLED GRADES ACCURATELY DEPICT THE
AS-BUILT CONDITIONS OBSERVED BY ME
ON Sheet 13 of 16


Garage Floor	\$95.08
1st Floor	\$97.33
Basement Floor	\$88.67
Bottom of Footer	\$87.67

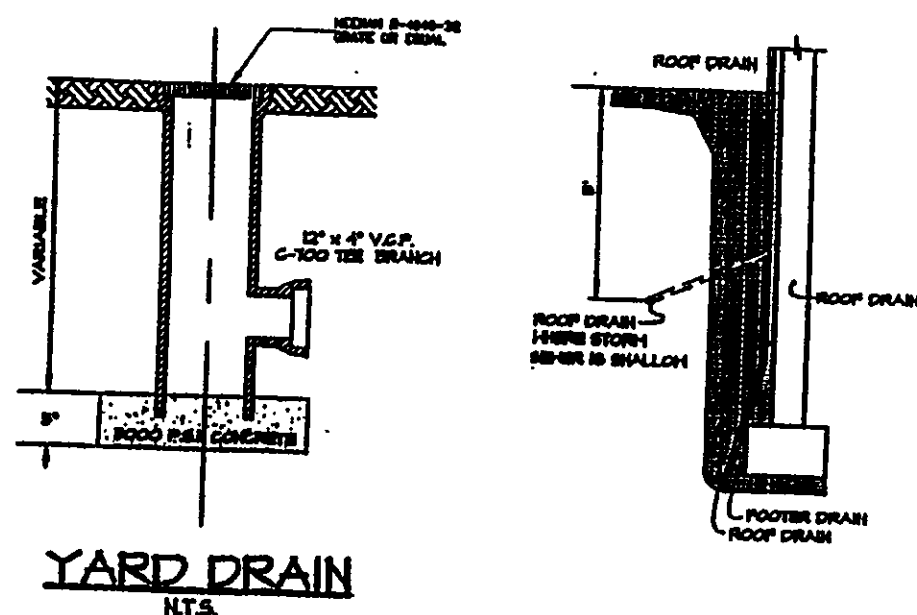

SILAS
FUG 594.8
PROPOSED
VACANT LOT





Graph W Temple

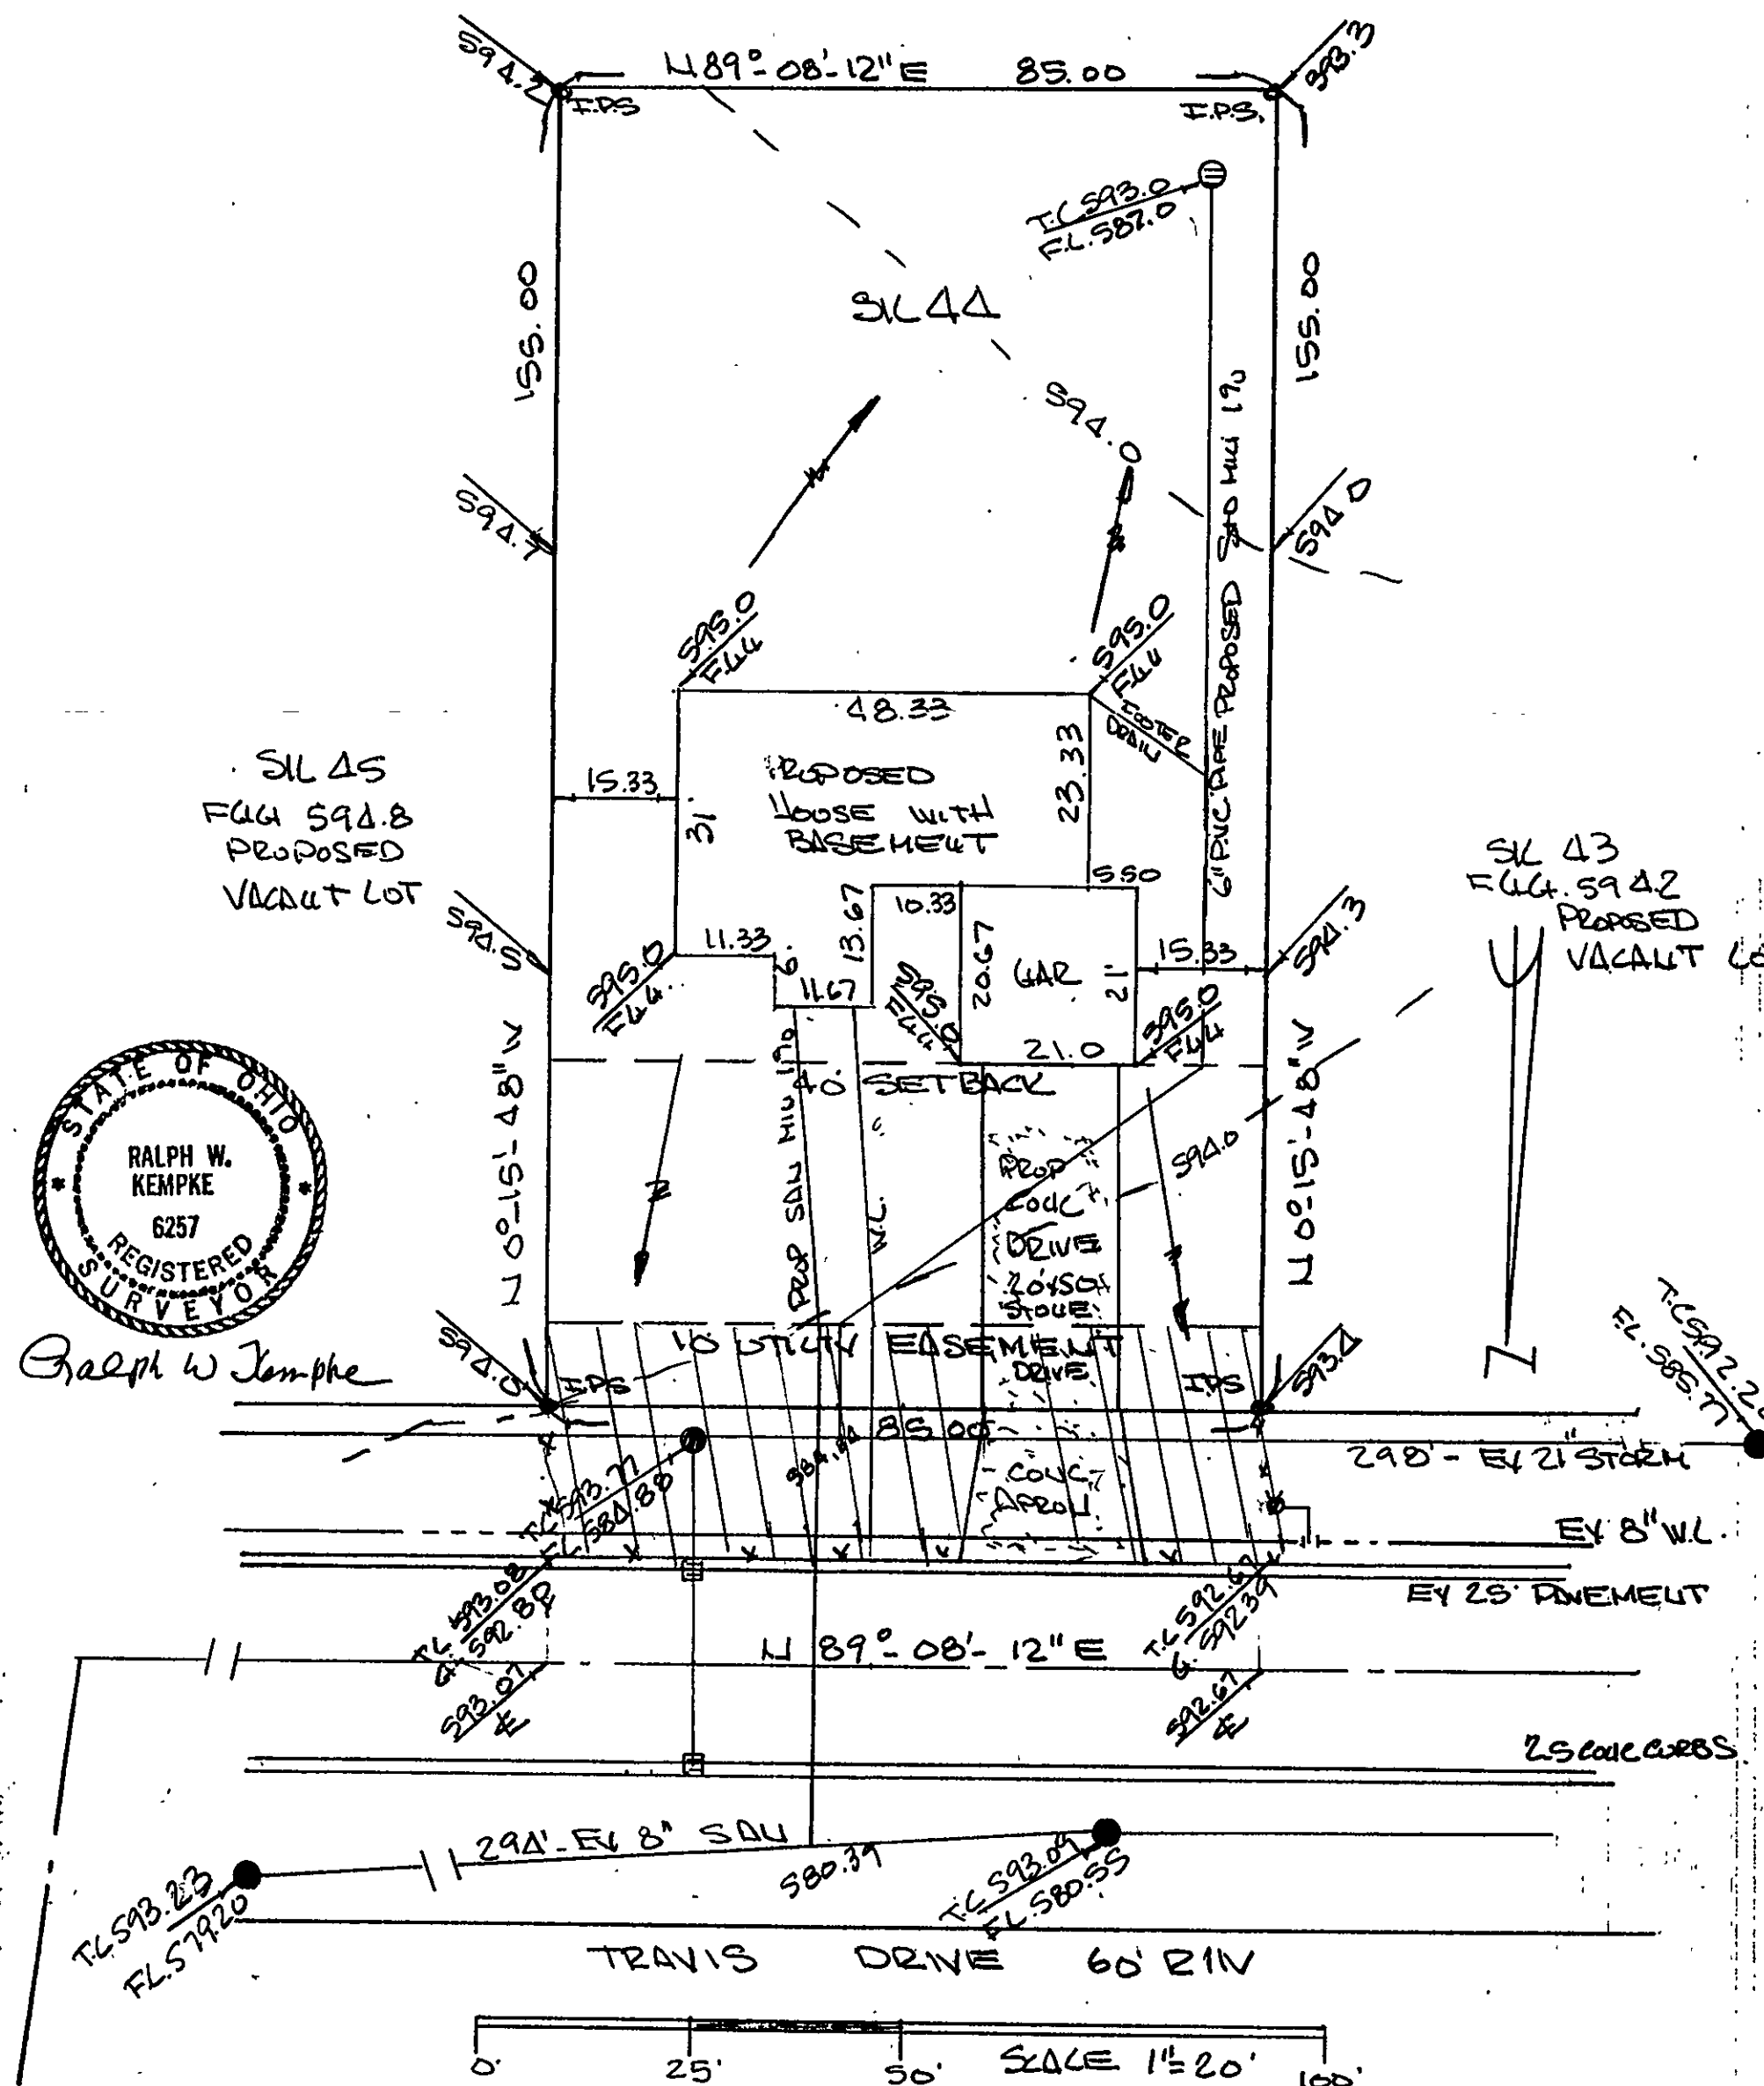

ROOF DRAINS
SHALL DISCHARGE
TO SPLASH BLOCKS.

Stoned construction entrance with underlain filter fabric
Temporary seeding and mulching of all disturbed areas (see details on sample sheets)
Storm sewer inlet protection for rear yard drains and catch basins
Temporary seeding within 50 feet of any stream or wetland (as necessary).
Silt fencing (where necessary)

WITH UNDERCLOTH FILTER FABRIC

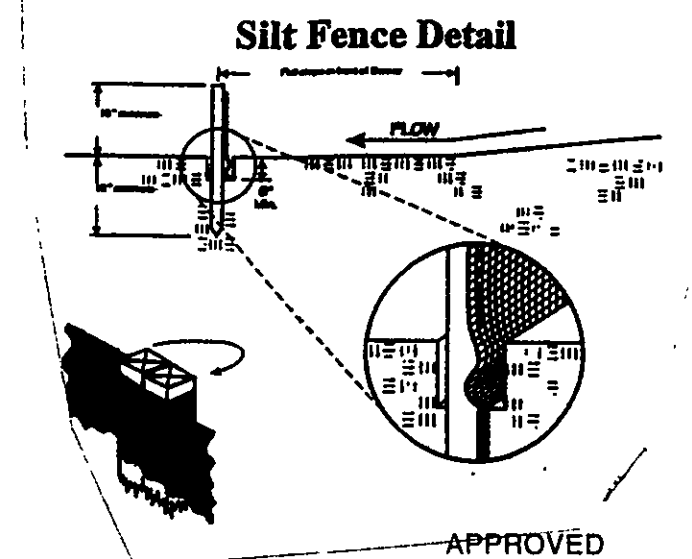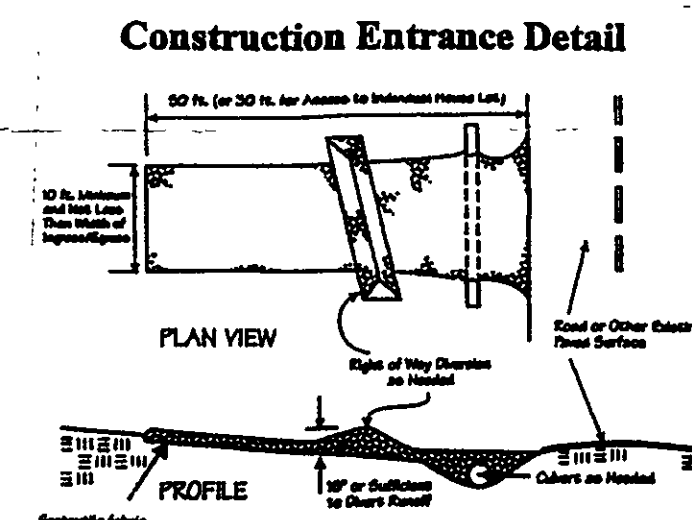

APPROVED
MADISON TOWNSHIP ZONING
DATE 3/27/04
BY du 21689

SITE PLAN FOR CUSTOM CRAFTED HOMES OF

SCALE: 1"=20'	APPROVED BY	DRAWN BY R.N.V
DATE: 2-20-04		
SUBLOT NO 44 W. MOORE'S LANDING SUBD. VOL 35 PAGE 16 OF L.C.M.R.		
		DRAWING NUMBER