
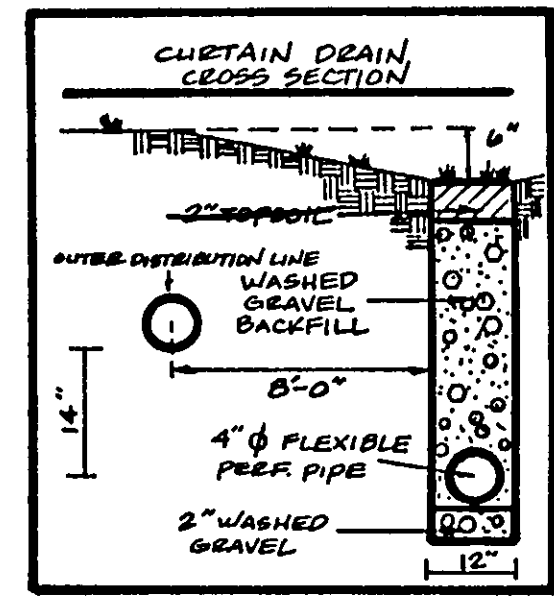


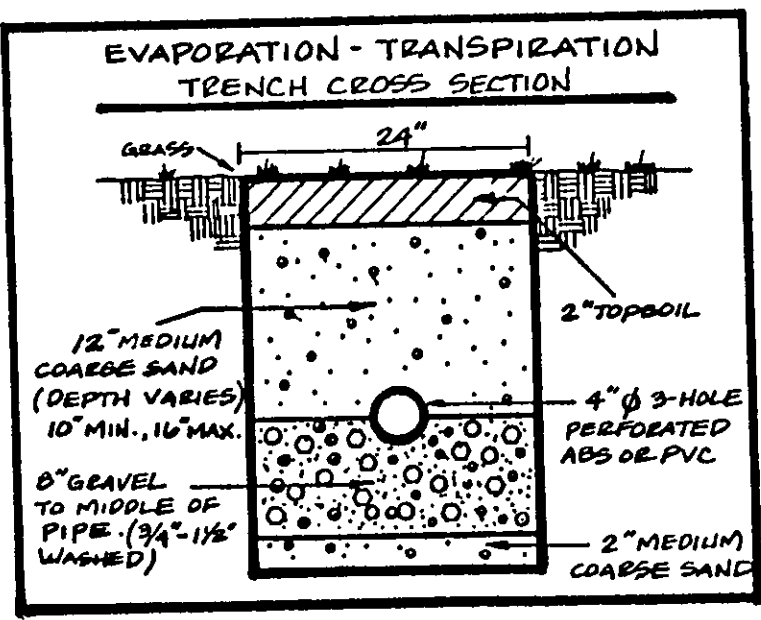

REVIEWED AND ACCEPTED
LAKE COUNTY GENERAL
HEALTH DISTRICT

Date 4/16/95 BY Daniel L. Loh

Sublot must be installed before
curtain drain is used

SEWAGE DISPOSAL PERMIT MUST BE
OBTAINED BY A LAKE COUNTY LICENSED
INSTALLER BEFORE INSTALLATION IS
STARTED

APPROVED
MADISON TOWNSHIP ZONING

DATE 6/2/98

BY JUL 15/98

SITE PLAN

MADISON TOWNSHIP, LAKE COUNTY, OHIO

for: SELAN CONSTRUCTION

CLIENT _____ OWNER _____

ADDRESS _____ STREET _____ CITY _____ ZIP _____

BEIGHLEY SUBDIVISION
SUBLOT NO. 11-20 NAME PT. 6 VOL. PG. 120 STREET _____

LOT 1002 TRACT 321
VOLUME 18-362-2 PAGE WARRIOR 42
PERM. PARCEL NO. _____ STREET _____

LEGEND

SANITARY MANHOLE	-----○	WATER VALVE (GAS)	-----+
STORM MANHOLE	-----●	WATER METER (GAS)	-----+ (100.0)
INLET OR CATCH BASIN	-----■	AS BUILT ELEVATION	
HYDRANT	-----○		
EXISTING CONTOURS	-----	INDICATES	
PROPOSED CONTOURS	-----	DIRECTION OF	
EXIST. ELEV. <u>100.0</u>		SURFACE DRAINAGE	
PROP. ELEV. <u>100.0</u>			

REMARKS

ALL BOUNDARY DATA SHOWN WAS OBTAINED FROM (DEEDS, RECORDED
SUBDIVISION PLAT OR OTHER PUBLIC RECORDS)

LOCATIONS AS SHOWN OF ADJACENT WELLS AND SEPTIC TANKS OBTAINED FROM
LAKE COUNTY HEALTH DEPARTMENT

DESIGN CERTIFICATION

THIS PLAT WAS PREPARED BY ME, AND IS CORRECT
TO THE BEST OF MY KNOWLEDGE AND BELIEF.

NAME _____ SURVEYOR REGISTRATION NO. 6343

CHECK LIST

NO. OF BEDROOMS	WATER MAIN SIZE, LOCATION
DIMENSIONS	SAN. SEWER SIZE % GR. LOC.
BEARINGS	SAN. MH. CAST. ELEV. INV. ELEV.
TIE TO NEAREST STREET	SAN. CONN. SIZE, LOC. DEPTH
SUBLOT NO. PARCEL NO.	STORM SEWER SIZE % GR. LOC.
SURROUNDING OWNERS	STORM MH. CAST. ELEV. INV. ELEV.
BLDG. DIMENSIONS FIN. GR.	PAVT TYPE GRADE CURBS
BLDG. TIES FLTR. GRADES	GAS LINE LOC. SIZE PRESSURE
APRON TYPE WIDTH THICKNESS	SEPTIC TANK LOCATION & DUPLICATION AREA
SIDEWALK TYPE WIDTH THICKNESS	WELL LOCATION
CULVERT TYPE DIA. LENGTH	ISOLATION RADIUS FROM WELL
ROCK OUTCROPPINGS	

REVISIONS

NO.	DATE	BY
1	7/27/94	HT
2	1/12/94	HT
3	6/18/96	HT
4		
5		

PLAN PREPARED BY:
BABCOCK • JONES & ASSOCIATES, INC.
PAINESVILLE, OHIO

DRAWN BY	SCALE	PHONE NO.
CHK'D.	DATE	357-1811
CREW CHIEF	APPD.	DRAWING NO.
		93-248-6

"AS BUILT" CERTIFICATION

I, HEREBY CERTIFY THAT THE CIRCLED GRADES ARE EXISTING
FINISH GRADES CHECKED IN THE FIELD ON _____, 19____
AND ARE CORRECT TO THE BEST OF MY KNOWLEDGE AND BELIEF.

REGISTERED SURVEYOR _____ REG. NO. _____

TBM - NAIL IN P.P. # 17MT034
ELEV. = 837.00



Grading Plan Approved
as shown and/or not
THOMAS P. GILLES, P.E.
Lake County Engineer

By GLH Date 6-9-98

000T permit
required.

"I, the undersigned hereby certify that
this topography indicated by 6", 1" or 2"
contours, and elevations shown hereon
represent an actual field survey made by
me on the 24th day of AUG., 1994
and that the elevations were taken at
appropriate intervals and that as of that
date the existing conditions as indicated hereon."

Frank Jones #6343
S.

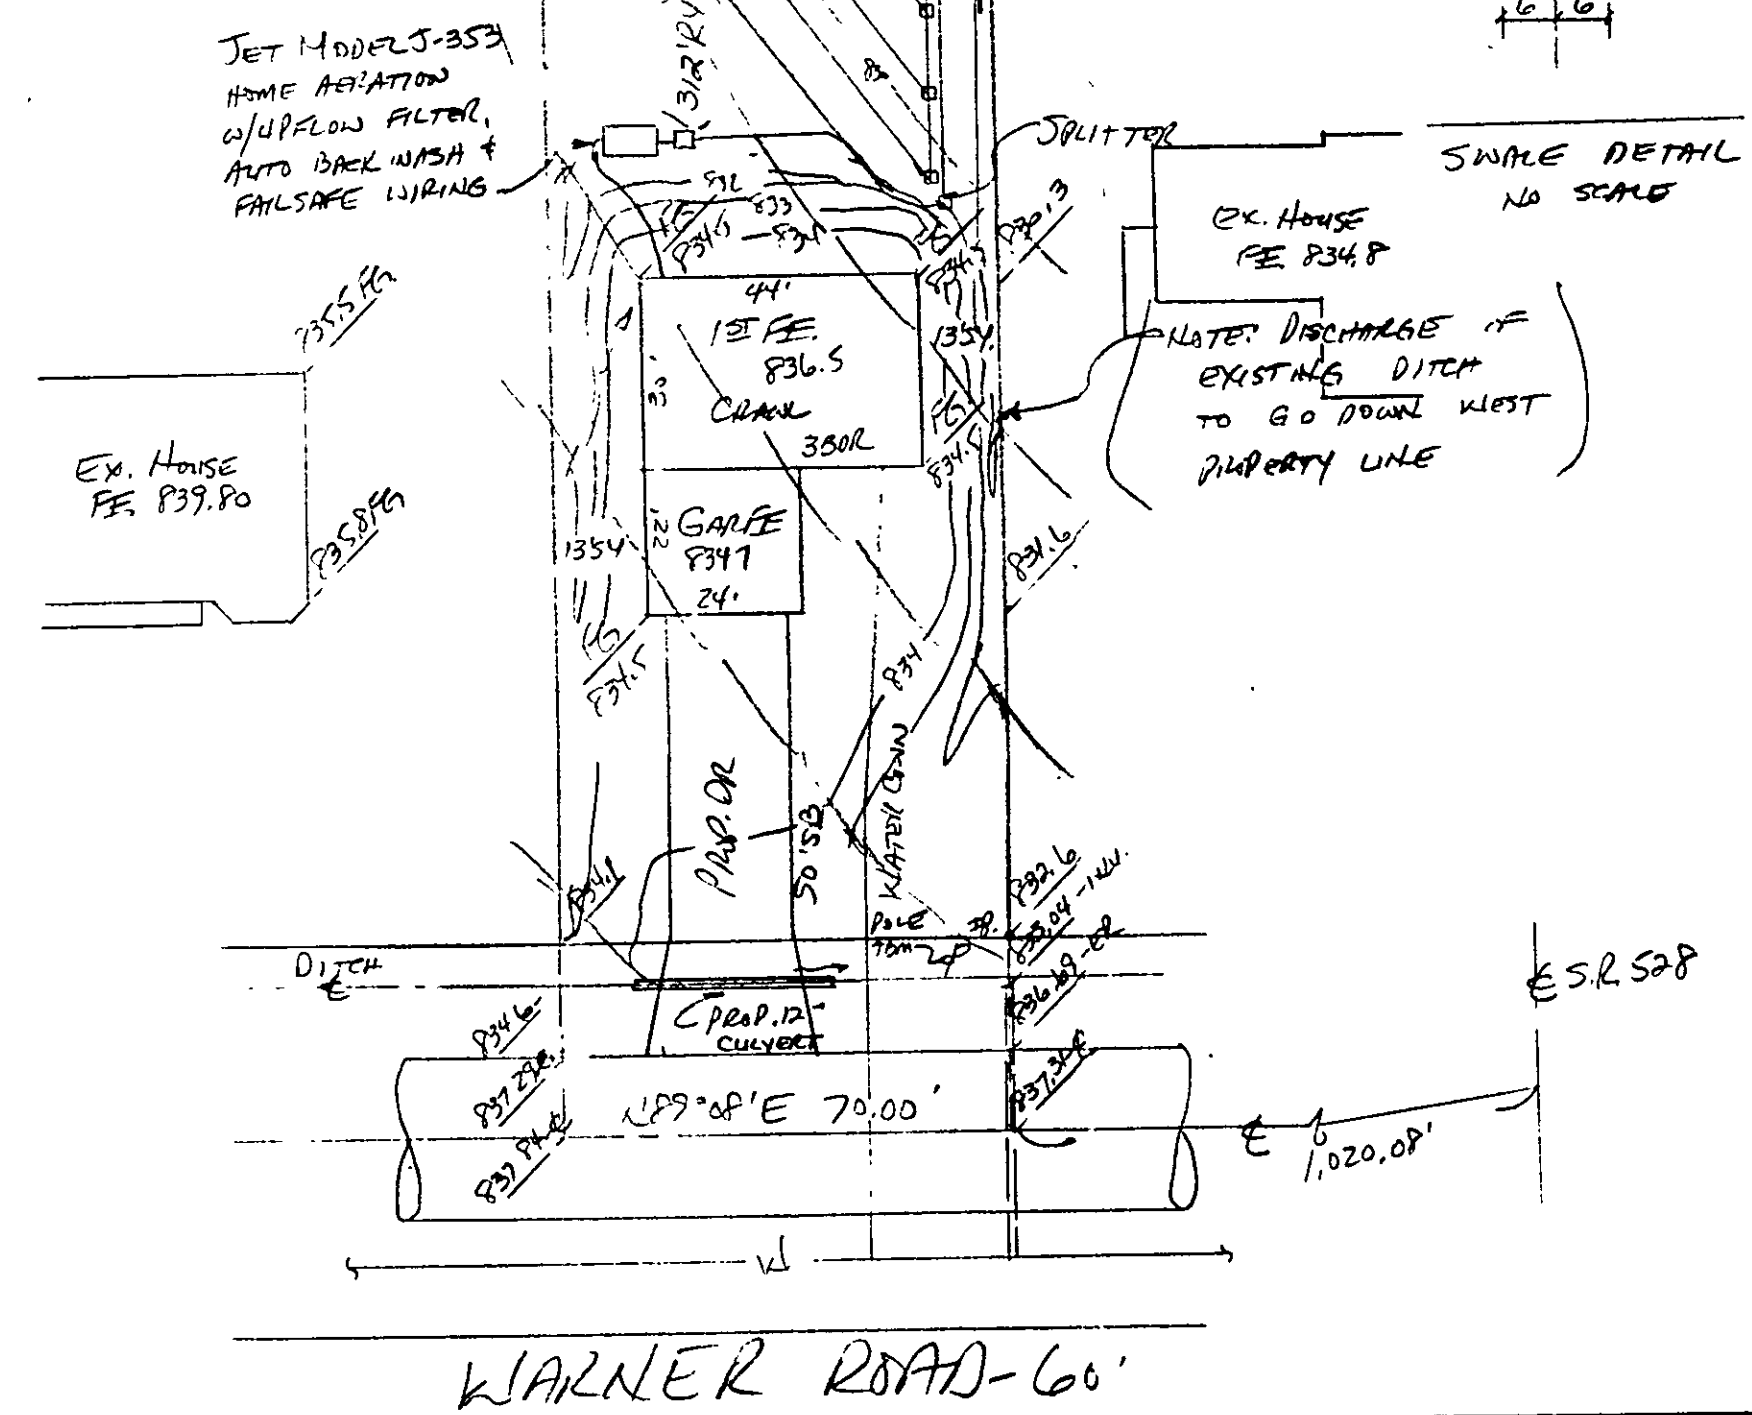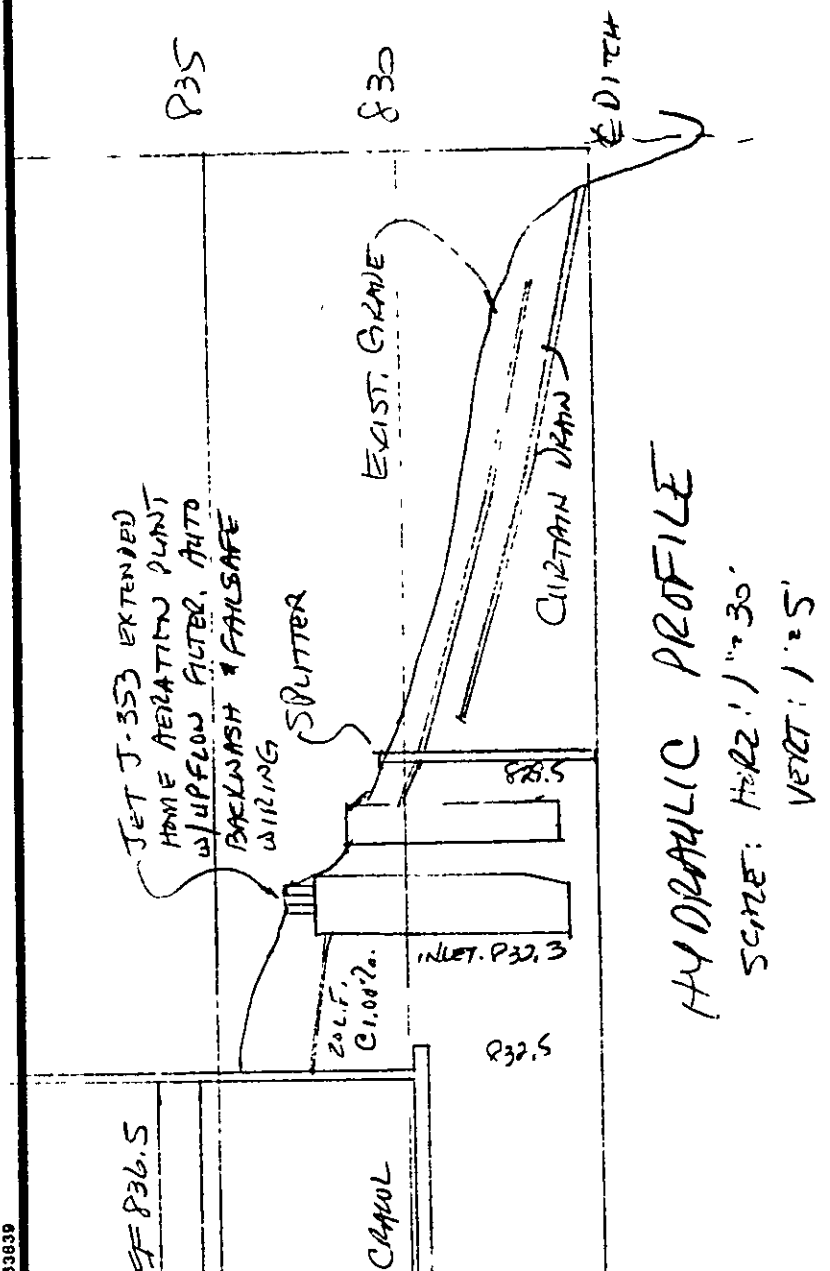

WARNER ROAD-60'