

Z
Zhang, J. 1999. *China's Foreign Trade*. Beijing: China Foreign Trade Press.

By 614 Date 7-8-93

N 3°43'52"E 233.56'

- A. To be brought to finished grade
1. Sloppe tank manhole covers
2. Sloppe box cover
3. Distribution box cover

- B. No further drains or downspouts
1. To be discharged into sloppe tanks

- C. All waste water to be discharged in sloppe tanks

Reviewed and Accepted

LANE COUNTY GENERAL HEALTH DISTRICT

Date 6-27-93

JOEL LUCIA, R.S., M.P.H.
Health Commissioner

N. N. N. N.

RECEIVED
APR 27 1965
13827
JL
RECEIVED
APR 27 1965
13827
JL
RECEIVED
APR 27 1965
13827
JL


SEWAGE DISPOSAL PERMIT MUST BE OBTAINED BY A LAKE COUNTY LICENSED INSTALLER BEFORE INSTALLATION IS STARTED.

**LOW YIELD WATER
FIXTURES REQUIRED
ON ALL:
Shower Head
Toilet**

Box INV 934
1st Box INV 950
SPLITTER
INV 956
1000 GRL TANK
INV 957
1000 GRL TANK
INV 958

VILLAGE SURVEYING CO.
FAIRPORT Harbor Ohio 44001
(216) 357-1354

7. The undersigned hereby certifies that this topography, indicated by 1, contours, and elevations shown herein represent an actual field survey made by me on 6-17-94 and that the elevations were taken at appropriate intervals and that as of that date

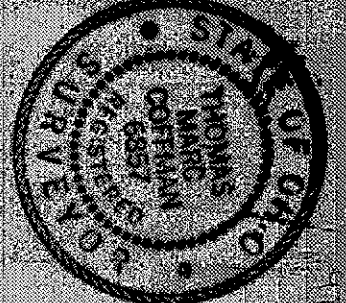

*Exercise may not exceed
780 dup.*

DATE

NO

REDA

— (6) —
CURTAIN DRAIN DETAIL

