



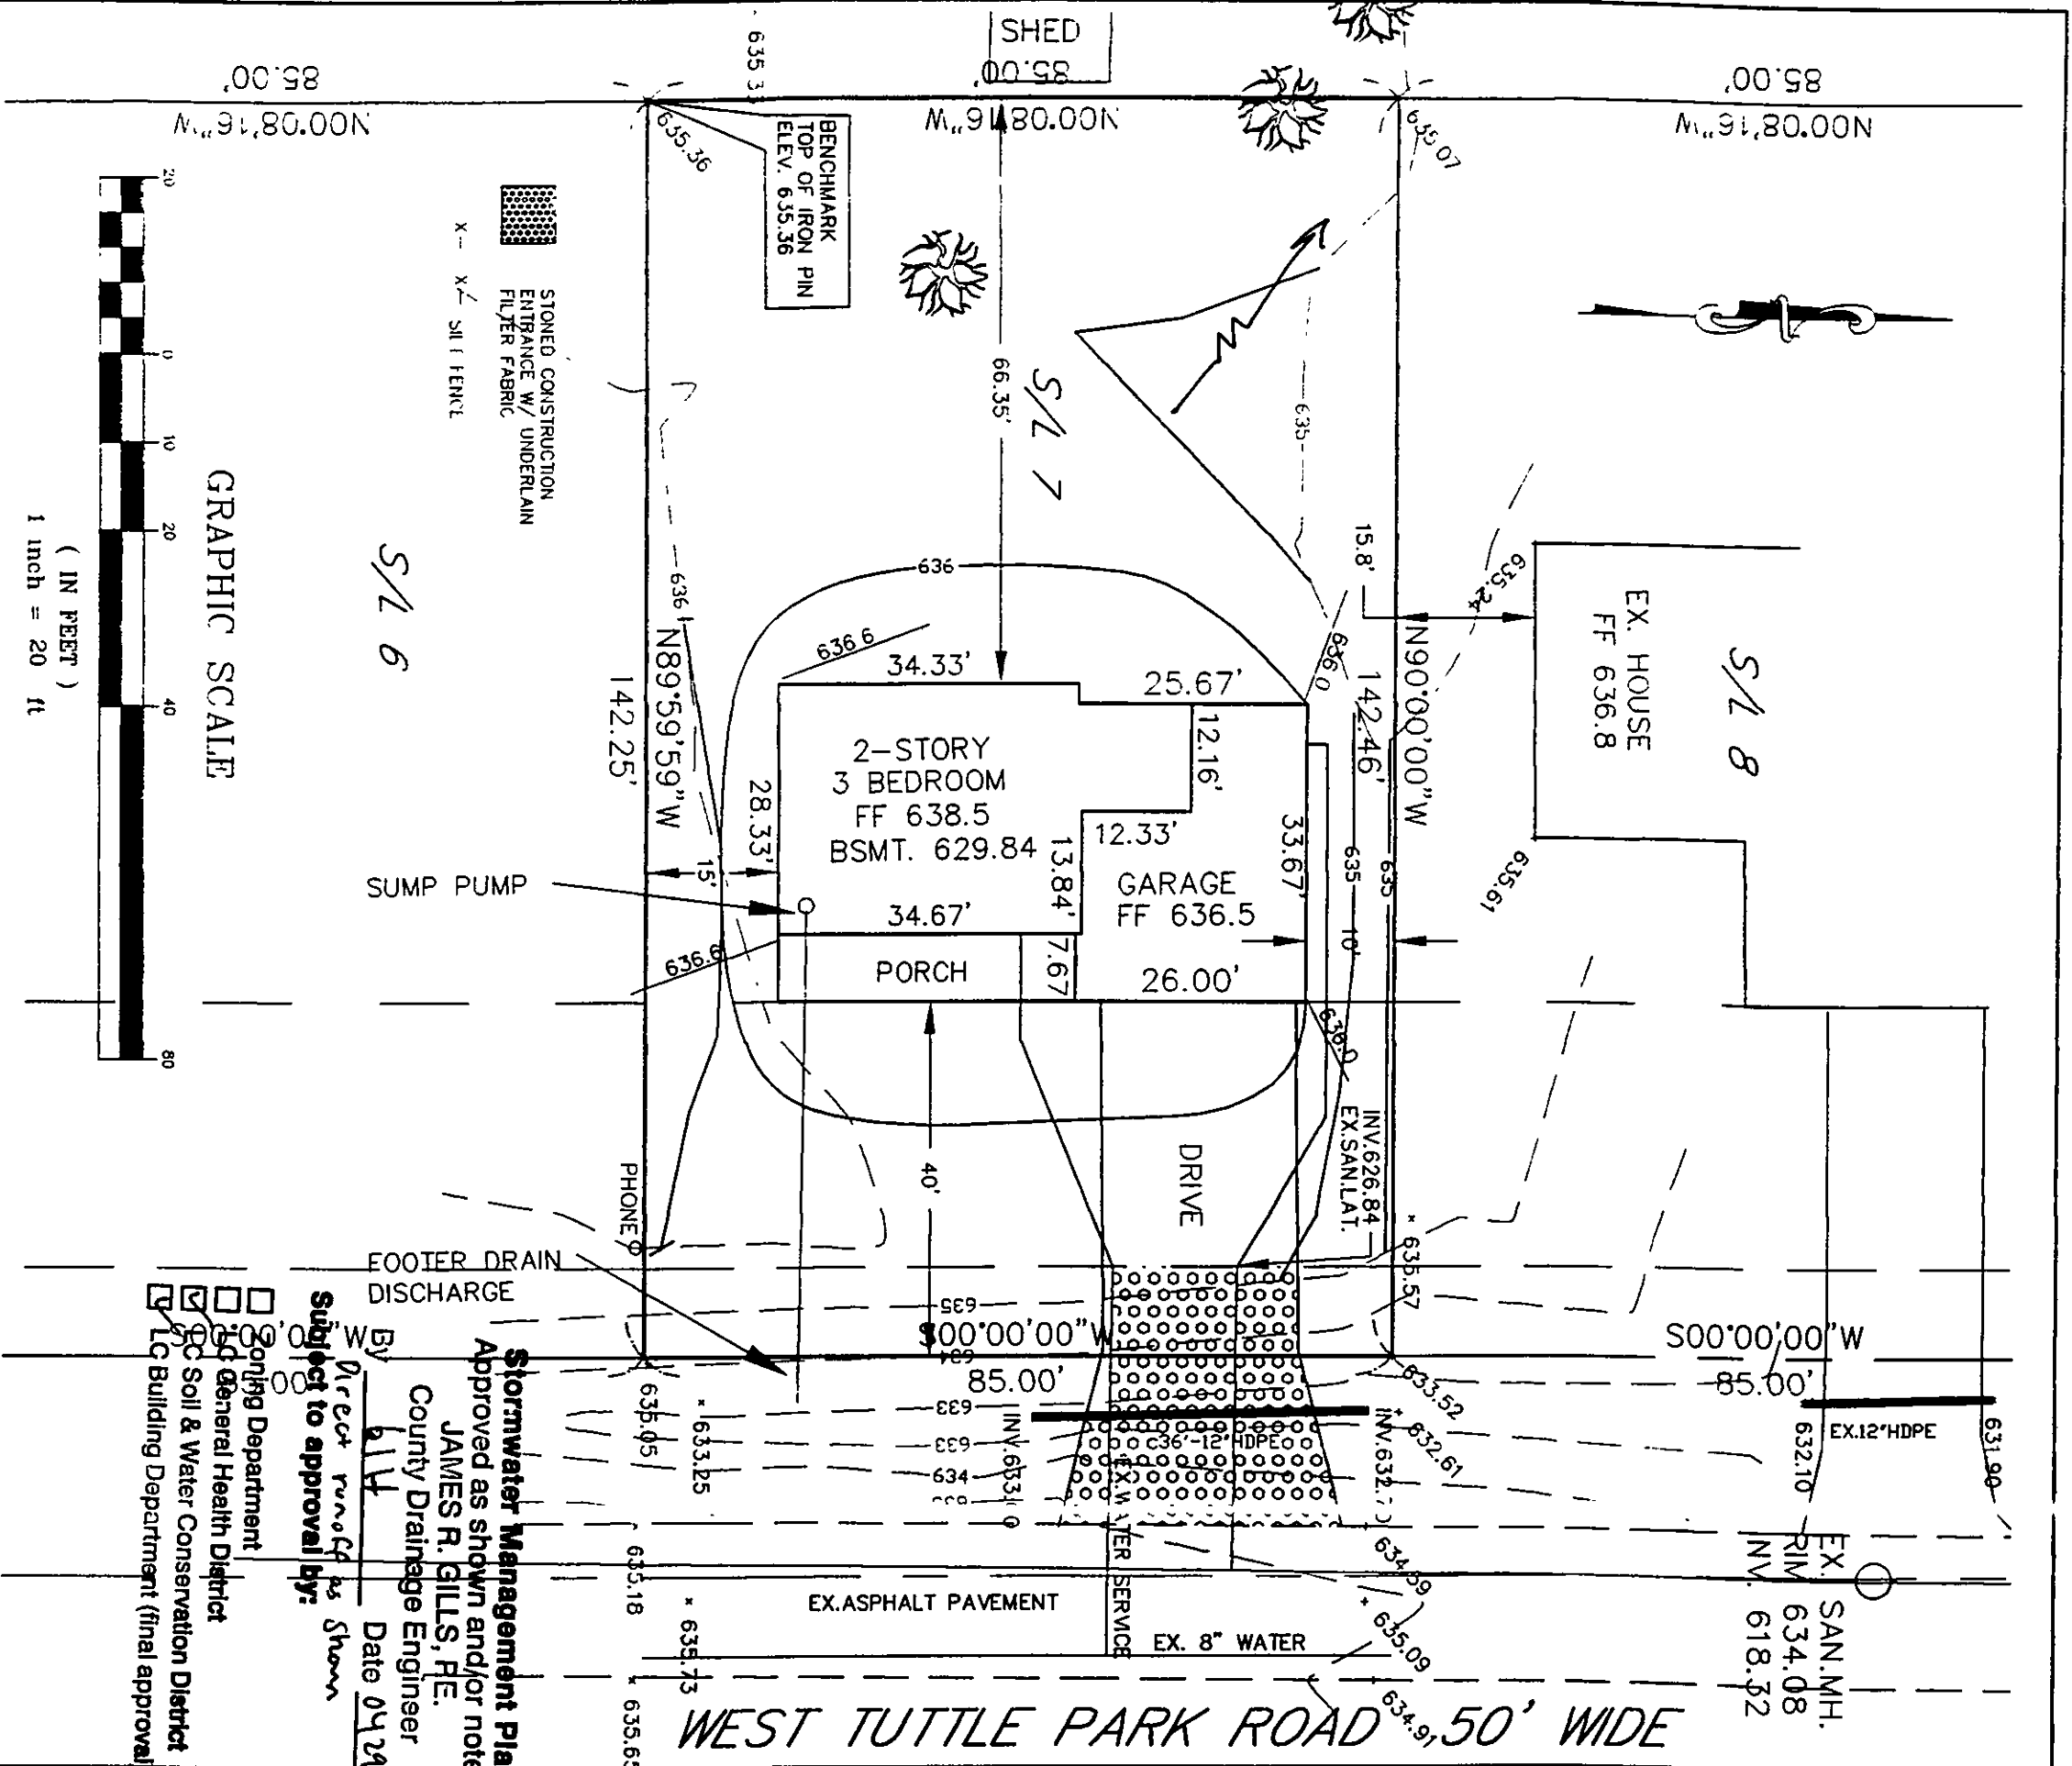


Erosion and Sediment Control Schedule

Ingress-Egress
A stone access drive complete with under lying geo-textile fabric (20 feet wide and 50 feet long) for ingress and egress at the site shall be installed. This drive shall be the only entrance and exit to the site.

Silt Fence
All silt fence shall be installed prior to any earthwork activities at the site in the locations shown on the site plan as well as along the front of any lot that slopes towards the street.

GRAPHIC SCALE

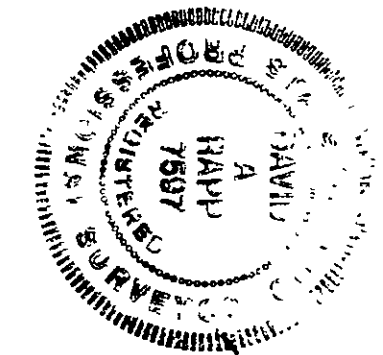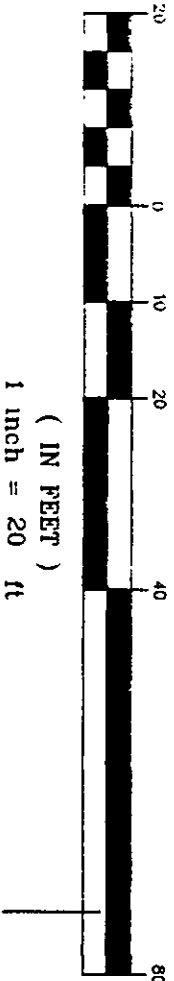

I, the undersigned hereby certify that this topography, indicated by 1' contours and elevations shown hereon represents an actual field survey made by me in APRIL, 2004 and that the elevations were taken at appropriate intervals and that as of that date they are as indicated hereon.

David A. Kopp 4/2/04

APPROVED
TOWNSHIP ZONING
MADISON TOWNSHIP
4/2/04

DATE: 4/2/04

CCR Consultants, Inc.
23 S. Forest Street
Geneva, Ohio 44041
440-466-8085

NOTES : 1. The Contractor Shall Verify the Following Before Starting:
Finish Floor Elevations and House Size.
Location and Elevation of existing utility connections.

2. Contractor Shall Contact OUPS at least 2 Working Days prior to construction, 1-800-362-2764.

- ☐ Engineering Department
- ☐ General Health District
- ☒ Soil & Water Conservation District
- ☐ Building Department (final approval)

Stormwater Management Plan
Approved as shown and/or noted
JAMES R. GILLS, P.E.
County Drainage Engineer
By: [Signature] Date: 04/20/04
Subject to approval by:

DATE: APRIL, 2004
DRAWN BY: DAR
CHECKED BY: BMO
APPROVED BY: DAR
P.S. No. 7597

David Welch
Windjammer Bay Sub. Phase 1
Site Plan For Sublot 7