


FILED

1964

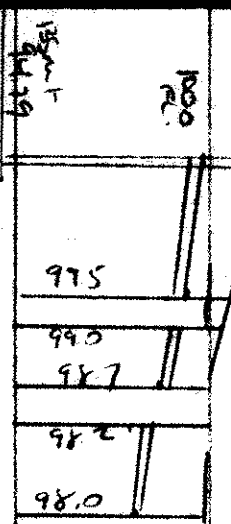

HYDRAULIC PROFILE
SCALE: 1" = 5' VERT
1" = 30' HORIZ

105


East Ground

K. HARRISON ET AL
Vol. 852 pg. 169

LOW FIELD WATER
FIXTURES REQUIRED
ON ALL:
Shower Head
Toilet

Reviewed and Accepted
LAKE COUNTY GENERAL HEALTH DISTRICT
Date: 10-21-89
JOEL LUCHA, R.S., M.P.H.
Health Commissioner
BY: *[Signature]*

- A. To be brought to finished grade
1. Septic tank manhole covers
 2. Splitter box cover
 3. Distribution box cover
- B. No footer drains or down outs
to be discharged into septic tanks
- C. All waste water to be discharged into
septic tanks
- SEWAGE DISPOSAL PERMIT MUST BE
OBTAINED BY A LAKE COUNTY LICENSED
INSTALLER BEFORE INSTALLATION IS
STARTED.

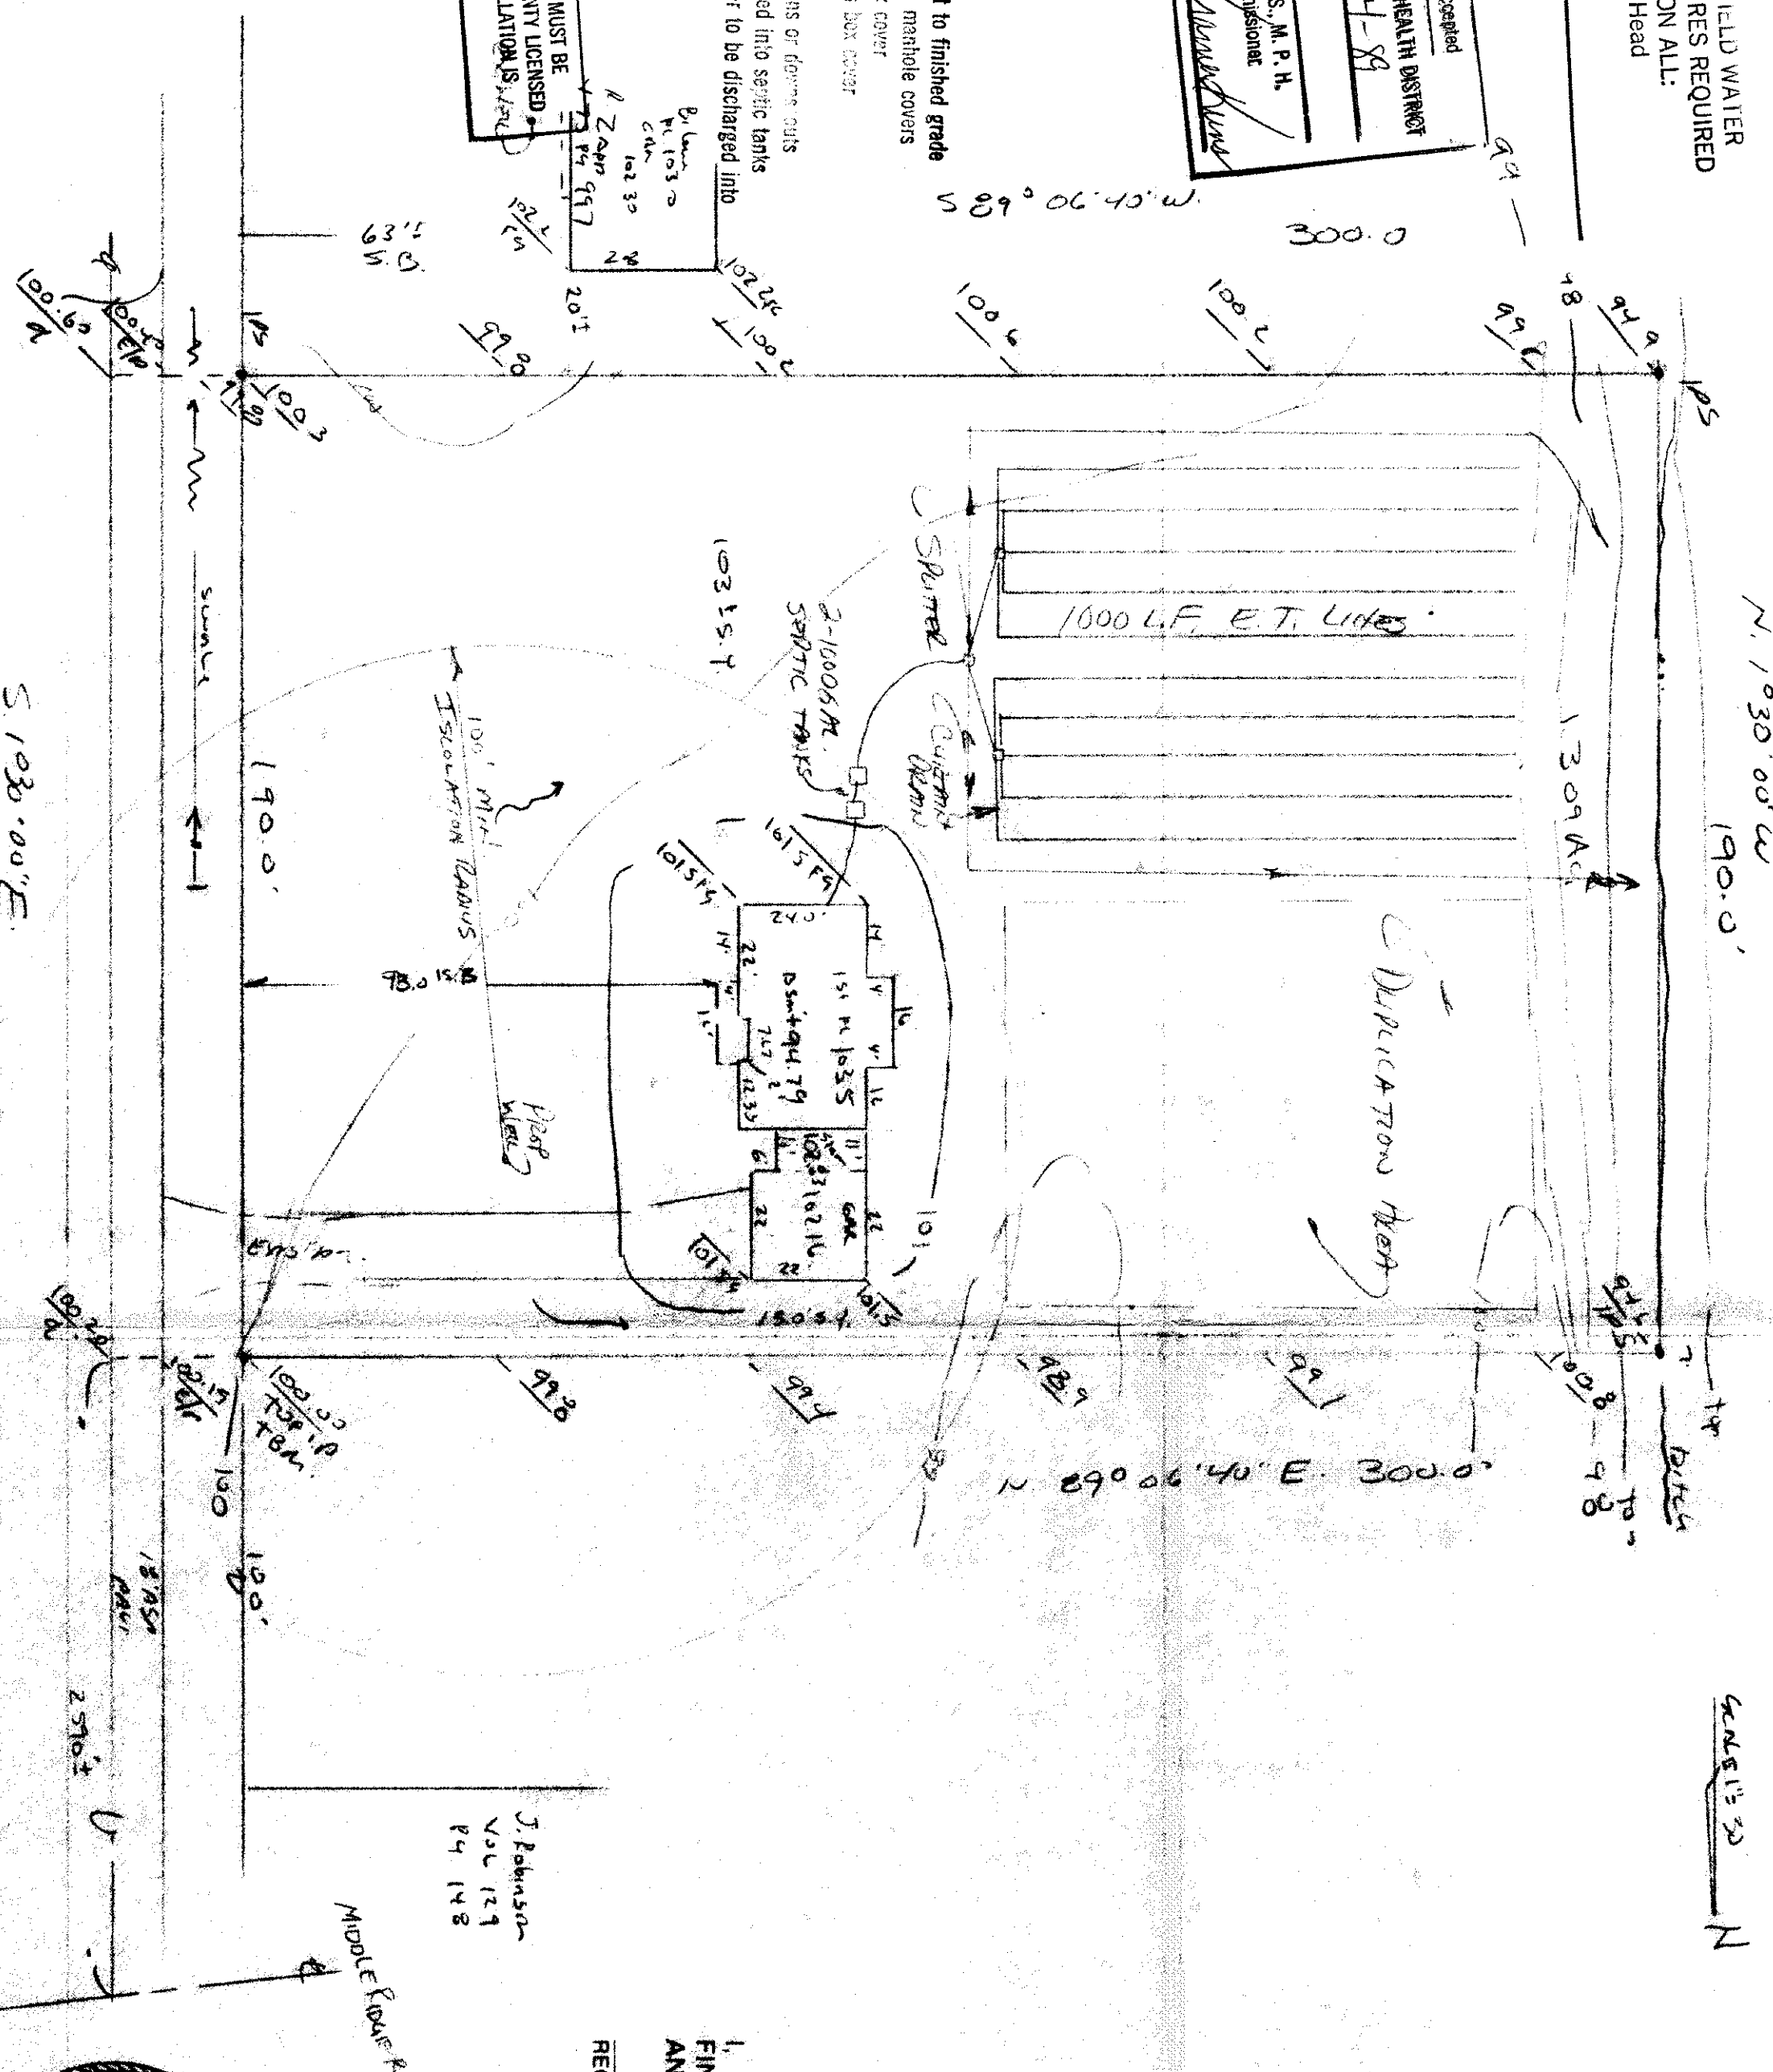

Permit # 12922

SITE PLAN

HARRISON Twp LAKE COUNTY, OHIO

For: *LARRY HARRISON* CLIENT

3234 *McMakin Rd* ADDRESS

CITY

SUBDIVISION VOL. NO. NAME LOT TRACT

SUBLOT NO. STREET

LEGEND

- SANITARY MANHOLE --- WATER VALVE (GAS)
- STORM MANHOLE --- WATER METER (GAS)
- INLET OR CATCH BASIN --- AS BUILT ELEVATION
- HYDRANT ---
- EXISTING CONTOURS ---
- PROPOSED CONTOURS ---
- EXIST. ELEV. --- PROP. ELEV. ---
- INDICATES DIRECTION OF SURFACE DRAINAGE

REMARKS

ALL BOUNDARY DATA SHOWN WAS OBTAINED FROM IDEAS, RECORDED
SUBDIVISION PLAT OR OTHER PUBLIC RECORDS.
LOCATIONS AS SHOWN OF ADJACENT WELLS AND SEPTIC TANKS OBTAINED FROM
LAKE COUNTY HEALTH DEPARTMENT

DESIGN CERTIFICATION

THIS PLAT WAS PREPARED BY ME, AND IS CORRECT
TO THE BEST OF MY KNOWLEDGE AND BELIEF.

NAME SURVEYOR REGISTRATION NO.

CHECK LIST

- NO. OF BEDROOMS
- WATER MAIN SIZE, LOCATION
- SAN. SEWER SIZE, OR LOC.
- BEARINGS
- TIE TO NEAREST STREET
- SUBLOT NO. PARCEL NO.
- SURROUNDING OWNERS
- BLOCK, TIES ELEV. INV. ELEV.
- BLOCK, TIES ELEV. GR.
- APPROX. TYPE WIDTH THICKNESS
- SEPTIC TANK LOCATION, DRAINAGE AREA
- CULVERT TYPE DIA. LENGTH
- NOCK OUTCHOPINGS
- ISOLATION RADII FROM WELL

PLAN PREPARED BY:

BABCOCK • JONES & ASSOCIATES, INC.

PAINEVILLE, OHIO

NO.	DATE	BY	SCALE	PHONE NO.
1	10/21/89	WJ	1" = 30'	357-1811
2				
3				
4				
5				


"AS BUILT" CERTIFICATION

I, HEREBY CERTIFY THAT THE CIRCLED GRADES ARE EXISTING
FINISH GRADES CHECKED IN THE FIELD ON 19__

REGISTERED SURVEYOR REG. NO.

T. Beach Wall Twp 110 N 1/2 Sec 10, 102.50

Finish Ground 1015.0
Fin. FL. 103.5 Top Buo. 102.50
Slope Fin. FL. 102.83
G.A. FL. 102.16
Bent FL. 94.79
Rte. 12 Gas Bsm. 4

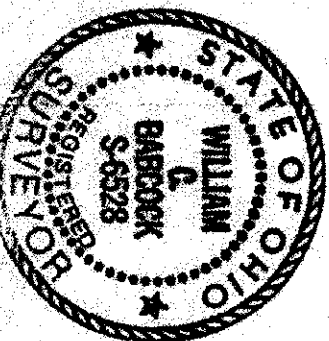

Grading Plan Approved

By: *GJH* Date: 11/1/89