

APPROVED ZONING  
JUL 26 1995  
MADISON TOWNSHIP ZONING



SCALE: 1"=50'  
0 25 50 100


TOPOGRAPHICAL SURVEY  
for:  
**DAVID & APRIL BOUCHER**  
KNOWN AS BEING PART OF ORIGINAL MADISON  
TOWNSHIP LOT NUMBER 7, TRACT NUMBER 4;  
NOW IN THE:

**TOWNSHIP OF MADISON**  
**COUNTY OF LAKE - STATE OF OHIO**

prepared by:  
**CAPITOL SURVEY COMPANY**  
6545 STRATHMORE DRIVE  
VALLEY VIEW, OHIO 44125  
PHONE: (216) 447-9227  
**JUNE 6, 1995**  
REV: 7-18-95

I HEREBY CERTIFY THAT THE TOPOGRAPHY SHOWN HEREON,  
INDICATED BY ONE FOOT CONTOURS AND ELEVATIONS,  
REPRESENTS AN ACTUAL FIELD TOPOGRAPHIC SURVEY MADE  
BY ME ON THE 6TH DAY OF JUNE, 1995, AND THAT THE  
ELEVATIONS WERE TAKEN AT APPROPRIATE INTERVALS AND  
THAT AS OF THAT DATE THEY EXISTED AS INDICATED HEREON.



*James A. Zemba*  
JAMES A. ZEMBA - PROFESSIONAL SURVEYOR # 7094

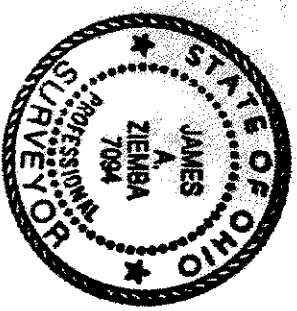


Grading Plan Approved  
by Town and/or noted  
**THOMAS P. GILLES, P.E.**  
Lake County Engineer  
By G/H Date 8/25

Reviewed and Accepted  
**LANE COUNTY GENERAL HEALTH DISTRICT**  
Date 7-27-95  
*4-5000 exten. dnm*  
*Stiller et Trider*  
**JOEL LUCIA, R.S., M.P.H.**  
Health Commissioner  
BY J. Lucia


P.P. # **1A-13-22**  
3.0762 ACRES TO E

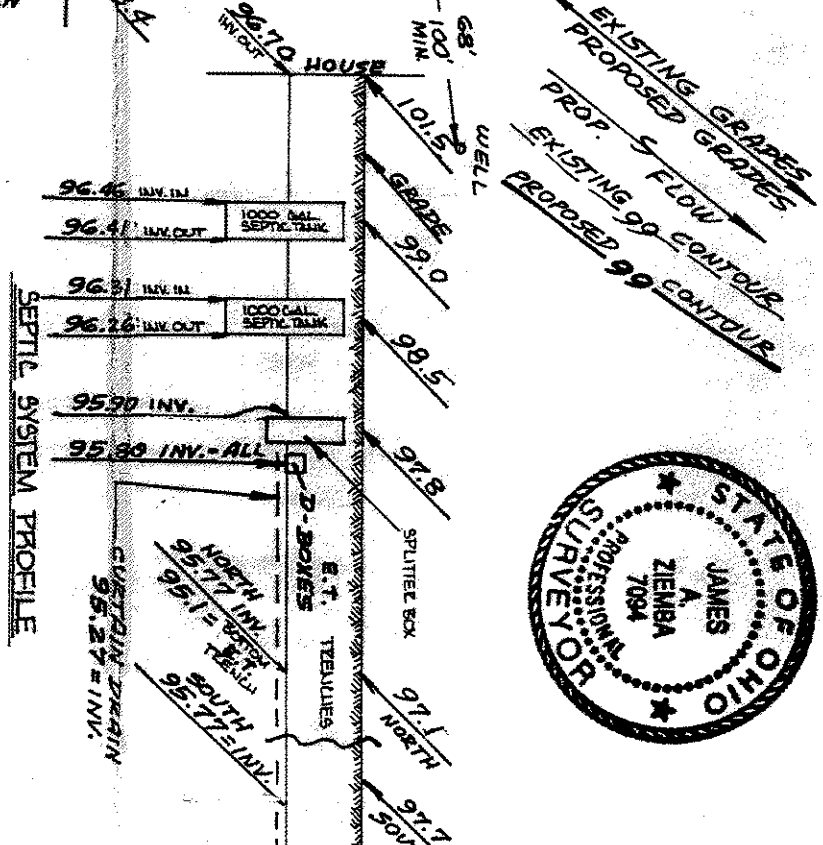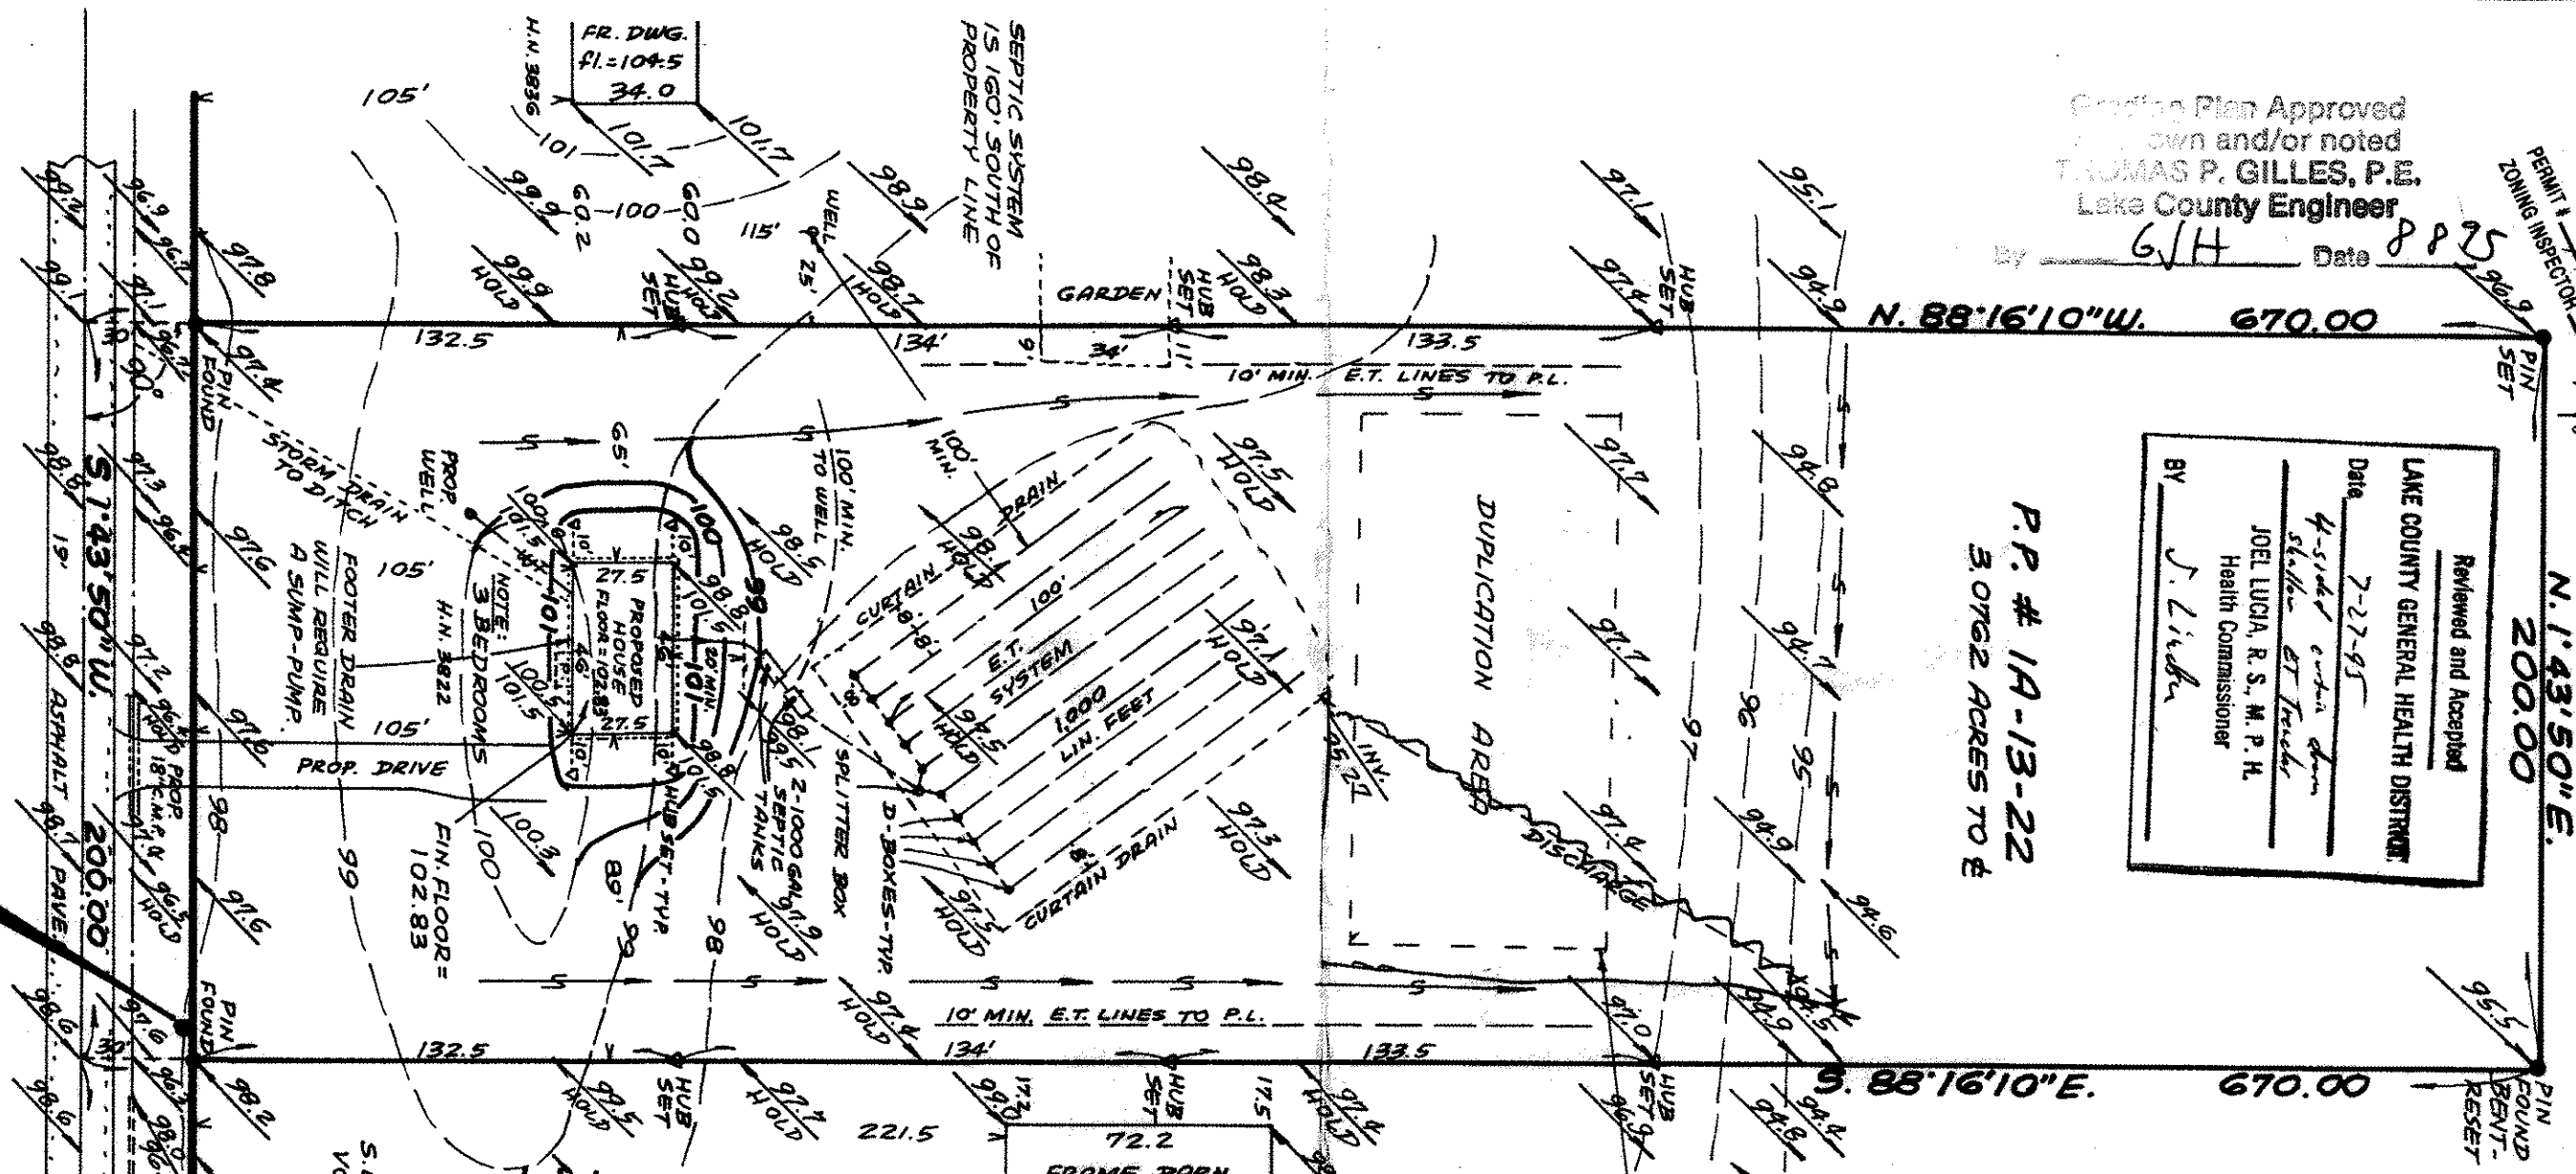

- A. To be brought to finished grade
- 1. Septic tank manhole covers
- 2. Splitter box cover (SEE NOTE BELOW)
- 3. Distribution box cover
- B. No footer drains or downspouts to be discharged into septic tanks
- C. All waste water to be discharged into septic tanks

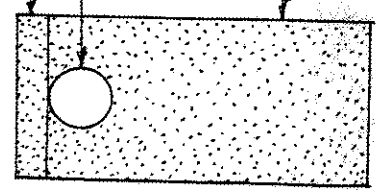

**LOW YIELD WATER CURTAIN DRAIN CROSS-SECTION**  
FIXTURES REQUIRED ON ALL:  
Shower Head  
Toilet  
NOTE: THE CURTAIN DRAIN MUST BE 6 INCHES DEEPER THAN DEEPEST E.T. LEACHING TRENCH BOTTOM.

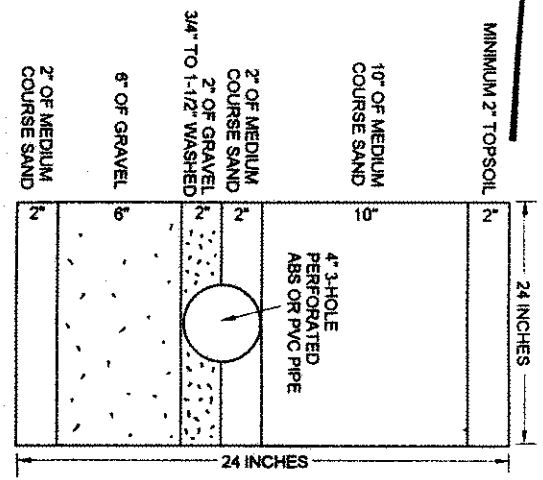

SEWAGE DISPOSAL PERMIT MUST BE OBTAINED BY A LAKE COUNTY LICENSED INSTALLER BEFORE INSTALLATION IS STARTED.

**EVAPOTRANSPIRATION TRENCH CROSS SECTION**  
THE STANDARD E.T. TRENCH IS 24 INCHES HOWEVER, THE TRENCH CAN VARY BETWEEN 18 INCHES TO 30 INCHES DEEP IF NECESSARY, WHEN TRENCH DEPTH VARIES, THE SAND AT THE TOP OF TRENCH WILL VARY FROM 10 TO 18 INCHES DEEP.

**WOOD ROAD 60'**  
BENCH MARK  
NAIL IN POLE  
ELEV.=100.00 ASSUMED