


BEING A PART OF LOT NO. 7, TRACT NO. 4,
IN THE TOWNSHIP OF MADISON, COUNTY OF
LAKE, STATE OF OHIO.



N 87° 27.50' W
L 70.00'

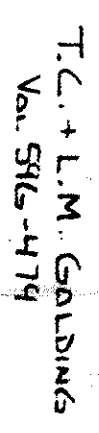


387° 21.50"E 670.00'

S 1°43'50"W 200.00'

1. the undersigned hereby certify that this topography, indicated by 1° contours, and elevations, shown between nearest Chul field survey made by me on July 9, 1902 and that the elevations were taken at appropriate intervals and that all of the



FF-101.8

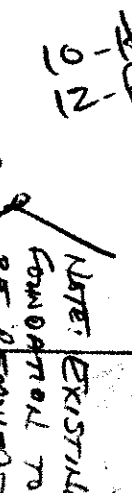

SPINTER
INV 98.2

Received and Accepted
LAKE COUNTY GENERAL HEALTH DISTRICT
 Date 9/16/92
 JOEL LUCIA, R. S., M. P. H.
 Health Commissioner
 BY N. Nicklas

SEWAGE DISPOSAL PERMIT MUST BE OBTAINED BY A LAKE COUNTY LICENSED INSTALLER BEFORE INSTALLATION IS STARTED.

Citing This Approved
 as Approved for
 Release by CIA on 08-22-2013
 GJH 11676