
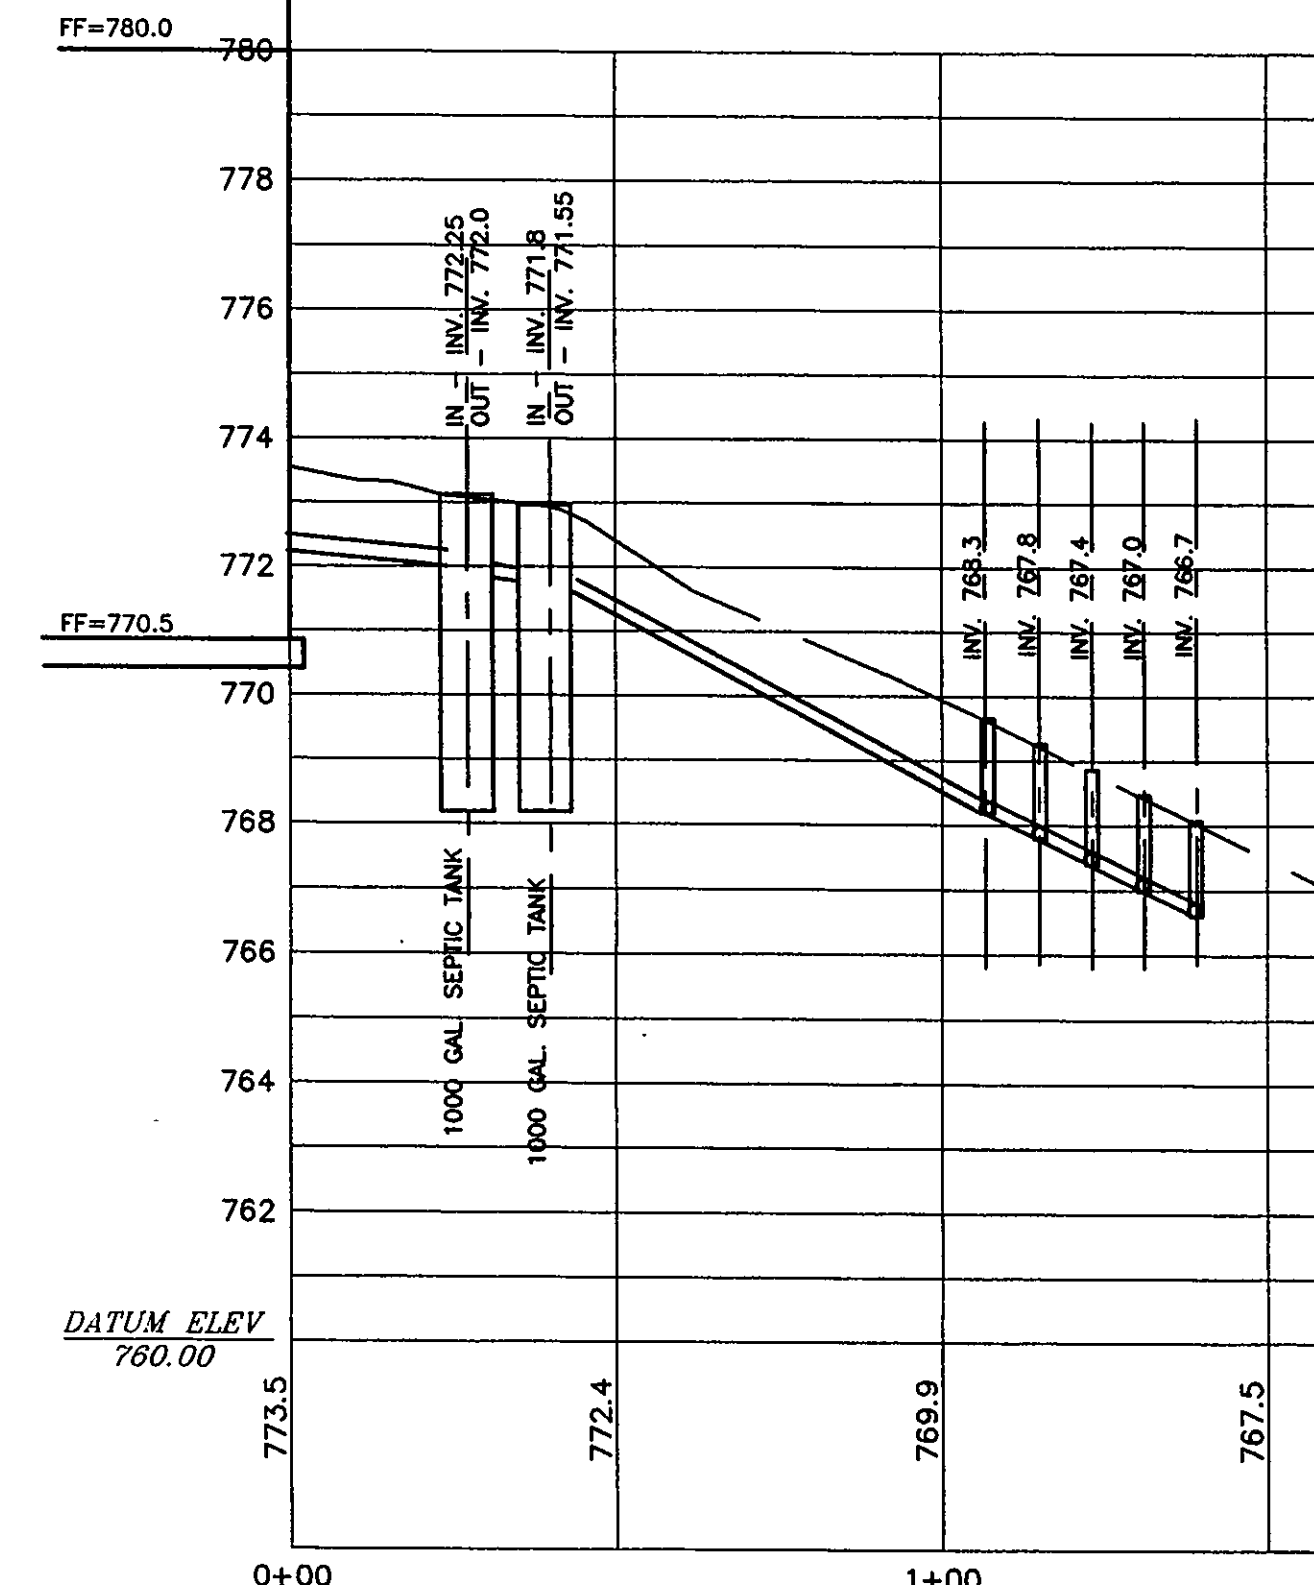


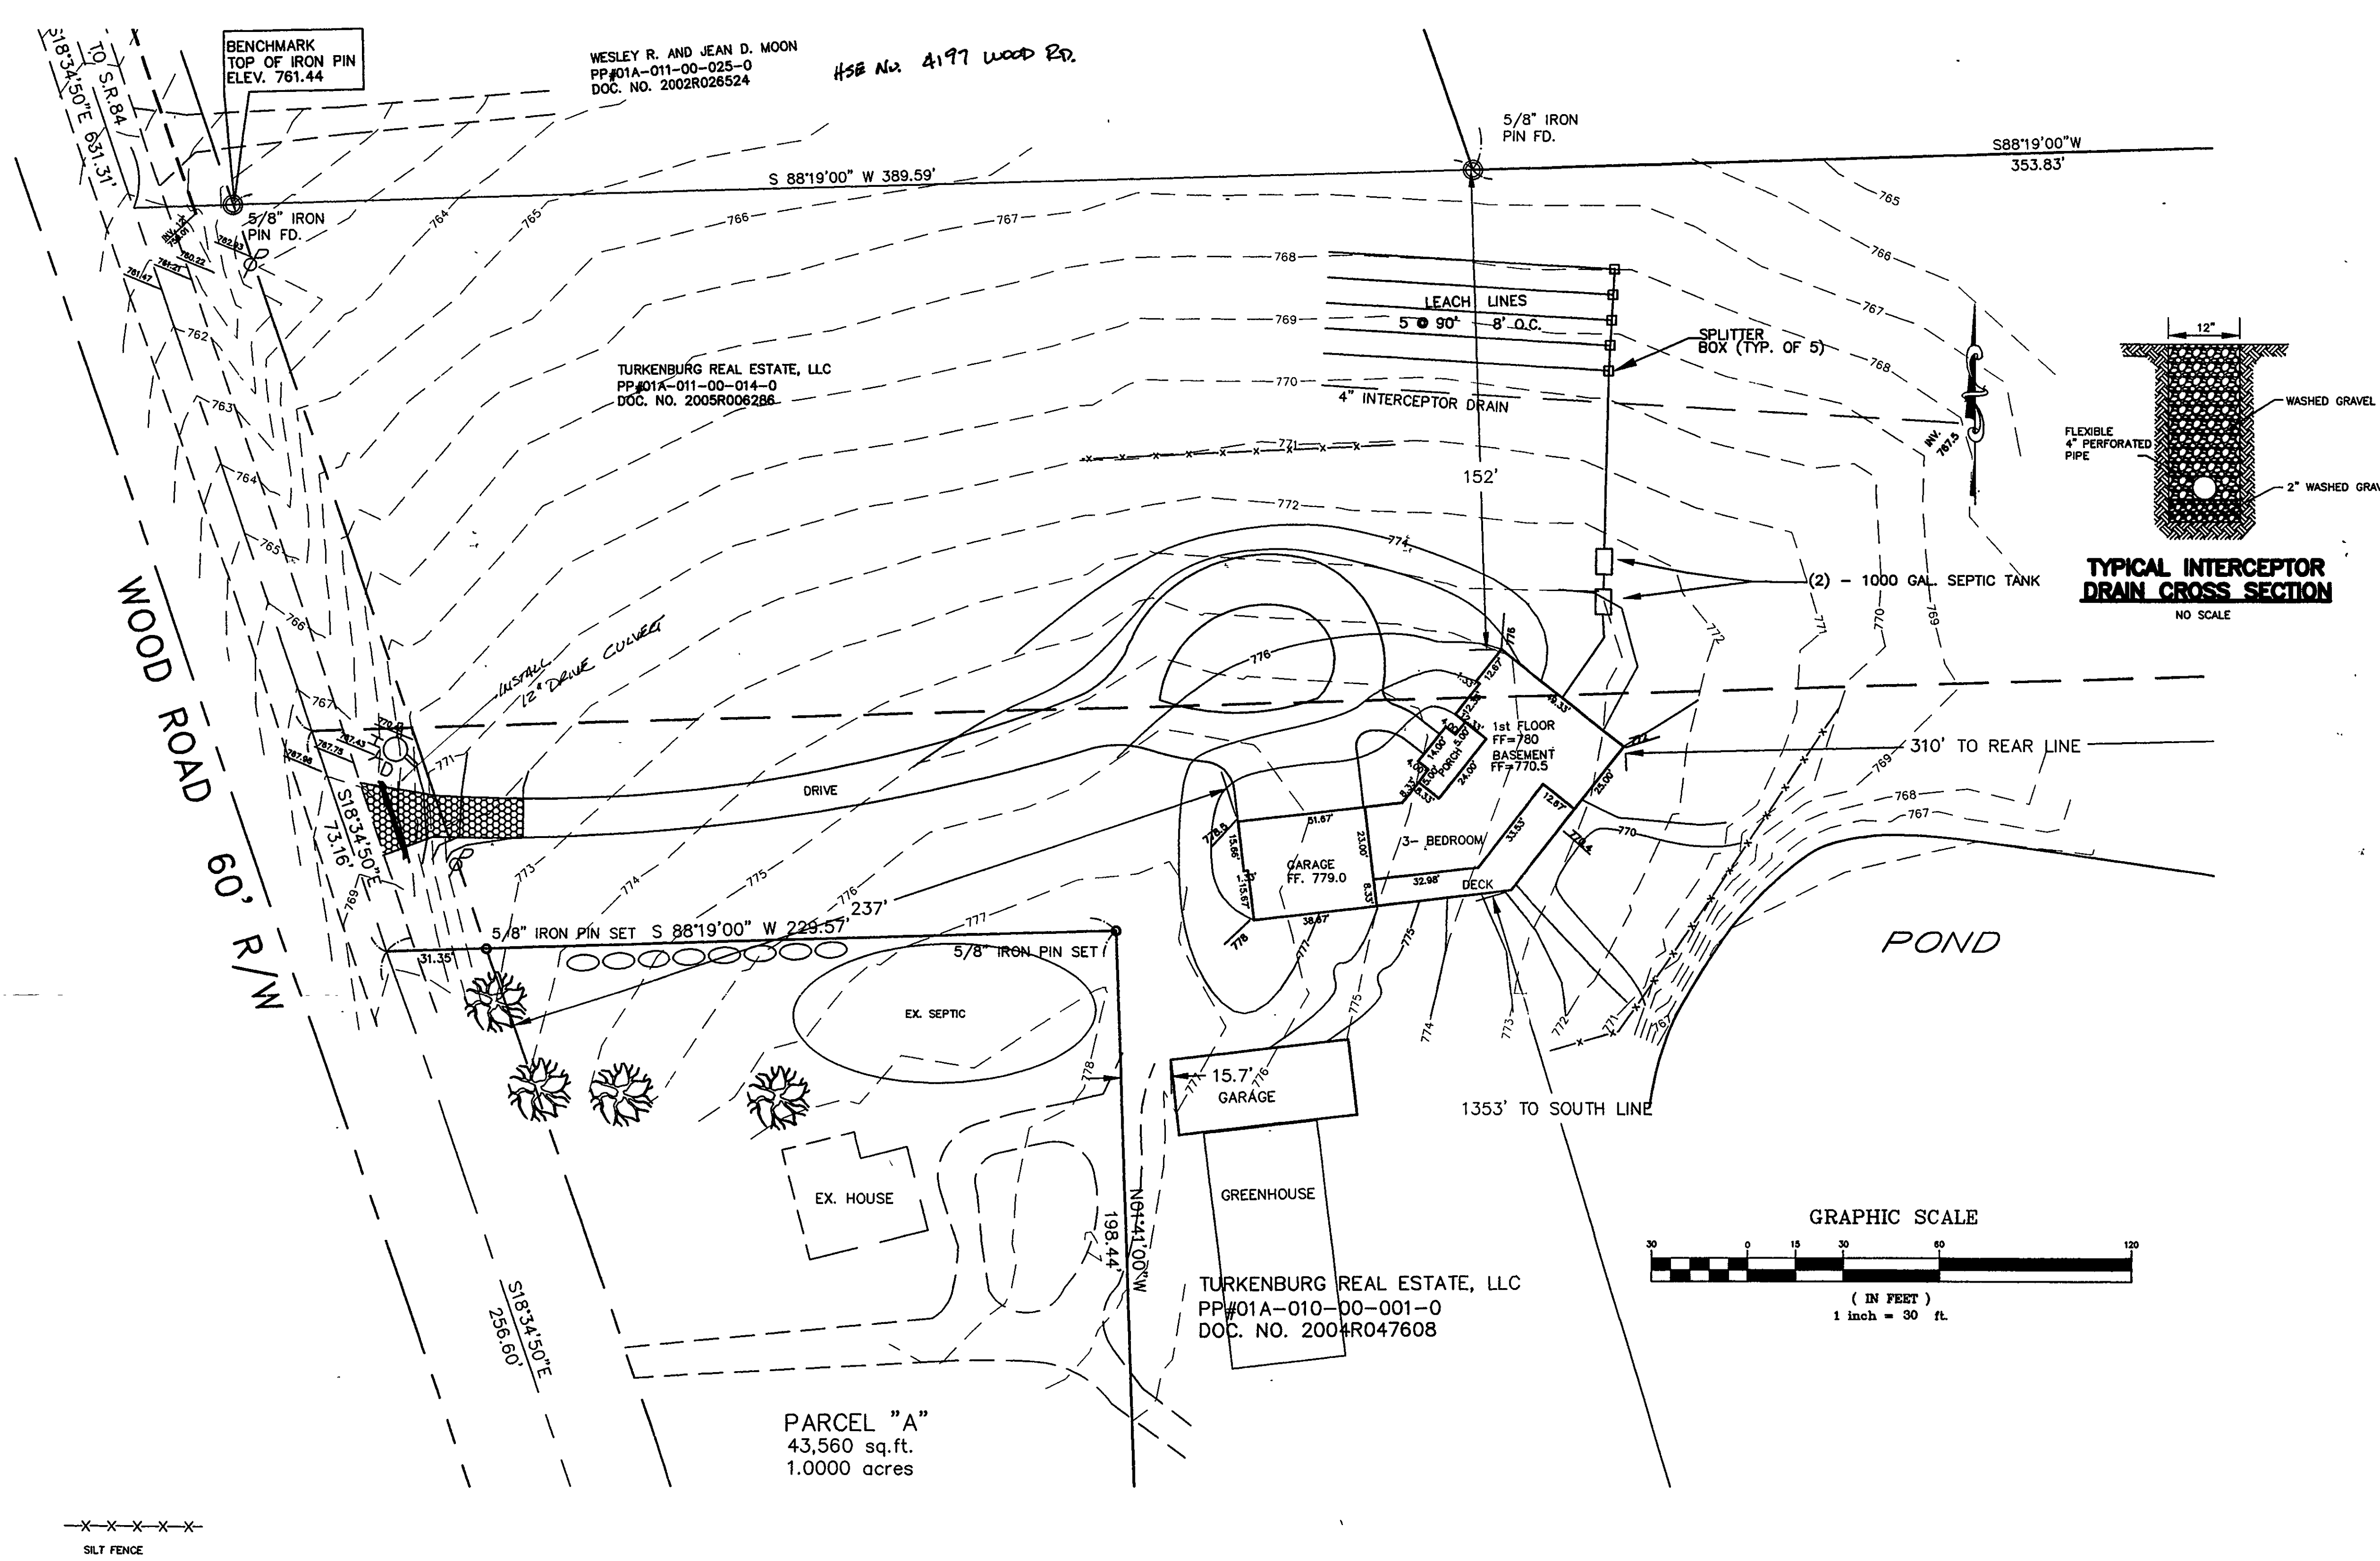


I, the undersigned, hereby certify that the topography shown thereon, indicated by one foot contours and elevations represents an actual field topographic survey made by me in March, 2008 and that the elevations date they existed as indicated thereon.

DAVID A. RAPP REGISTRATION NO.

Stormwater Management Plan
Approved as shown and/or noted
JAL. S. E. P.E.
County Engineer
By L.S. Date 4/4/08

APPROVED
MADISON TOWNSHIP ZONING
DATE 4/4/08
BY JK 2-3246

DAVID RAPP SERVICES
3406 DAYTON ROAD MADISON, OHIO 44057
440-983-1607

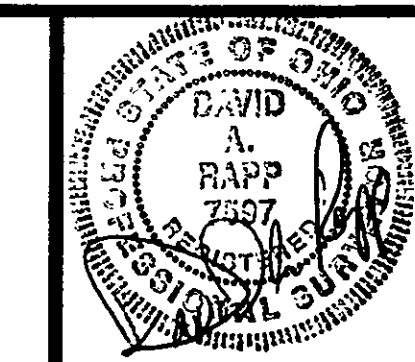

DATE: March, 2008
DRAWN BY: DAR
CHECKED BY: _____
APPROVED BY: _____
PE No. P.E. NO. 62081

TURKENBURG REAL ESTATE, LLC.
PP# 01A-011-0-00-014-0
WOOD ROAD, MADISON TOWNSHIP, OHIO

SITE PLAN

Hor. Scale 1" = 30'	Vert. Scale 1" = 4'
CONTRACT No. 28010	
SHEET No. 1	OF 1