


SITE PLAN

FOR
R.C. REED CONST.
BEING KNOWN AS 1/15 OF THE MADISON RIVER OAKS
SUBDIVISION PHASE I, PART OF LOT 3, TRACT 8 AND
LOT 4, TRACT 4 IN MADISON TOWNSHIP, LAKE COUNTY,
OHIO.

SCALE: 1"=20'

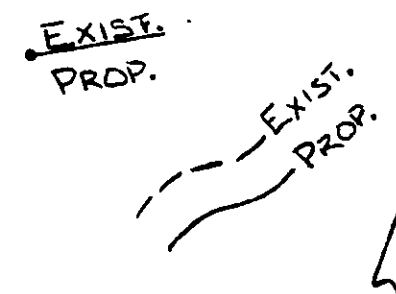

PROP. 1/16 < VACANT >

N 71°57'01"E 435.60'

1/15 - 1.2500 AC.

PUMP TO DUPLICATION
W/ AERATION


S 71°57'01"W 435.60'

1/14 < VACANT >

S 18°02'53"E 125.00'

BENCHMARK - 219.59
TOP BOLT HYDRANT

Continue ditch
or provide drainage
for roadside ditch

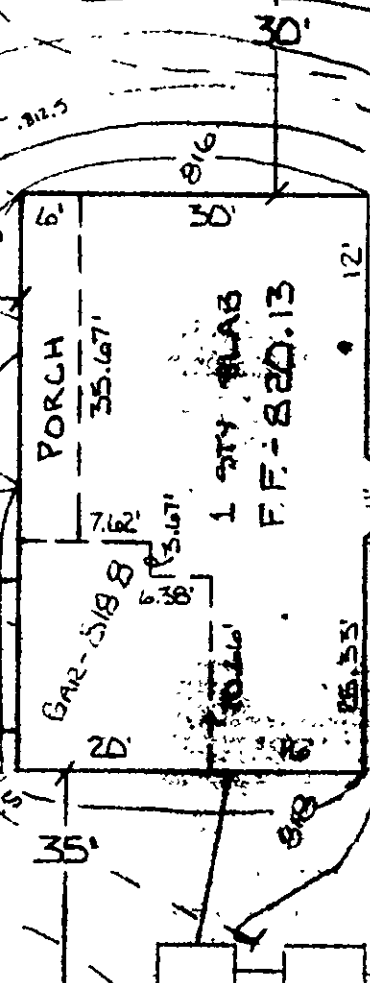

REVIEWED AND ACCEPTED
LAKE COUNTY GENERAL
HEALTH DISTRICT

Date 6-98 BY Daniella
Keep trenches shallow

SEWAGE DISPOSAL PERMIT MUST BE
OBTAINED BY A LAKE COUNTY LICENSED
INSTALLER BEFORE INSTALLATION IS
STARTED

FF-820.13

HYDRAULIC PROFILE
VERT - 1"=3' HORIZ 1"=30'

1000 GAL TANK
INV 815.5



1000 GAL TANK
INV 815.0

SPREADER
INV 813.7
DIST. BOX
INV 813.0

DIST. BOX
INV 808.7

Grading Plan Approved
shown and/or noted
THOMAS P. GILLES, P.E.
Lake County Engineer

By 6/14 Date 1-13-98

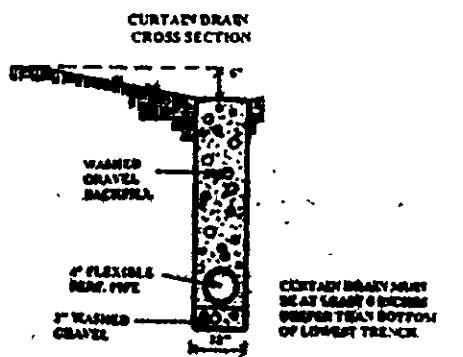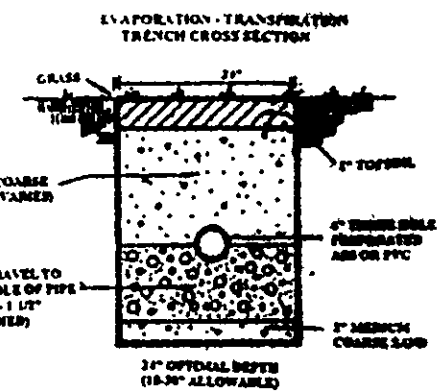

APPROVED
MADISON TOWNSHIP ZONING

DATE 7/8/98
BY 15635 JH

VILLAGE SURVEYING CO.
P.O. BOX 1096, FAIRPORT HARBOR, OHIO 44077
(216) 357-1359

I, the undersigned hereby certify that
this topography, indicated by 1' contour
and elevations shown herein represent an
actual field survey made by me on FEB 19, 1997
and that the elevations were taken at
appropriate intervals and that as of the
date they existed as indicated herein.

J.M. Coffey
No 6057

WOOD ROAD 60'

N 18°02'59"W 125.00'

21' ASPHALT