

SITE PLAN FOR R.C. REED CONST. BEING SPLIT NO. 3 OF THE PAPARIZO SPLIT IN LOT NO. 3, TRACT NO. 8 IN THE TOWNSHIP OF MADISON, LAKE COUNTY, OHIO.

REVIEWED AND ACCEPTED
LAKE COUNTY GENERAL
HEALTH DISTRICT

Date 1-16-97 BY J. Lindsey

SEWAGE DISPOSAL PERMIT MUST BE
OBTAINED BY A LAKE COUNTY LICENSED
INSTALLER BEFORE INSTALLATION IS
STARTED.

SCALE: 1" = 20'



Keep footer discharge
away from ET field & curtain
drain
- curtain drain discharge
to back corner ditch.


BENCHMARK - 100.00 ASSUMED
TOP BOLT HYDRANT - (USGS = ELEV + 747.0 ± 1)

3' Minimum
Asphalt Apron

SPLIT 4 - 1.0000 AC
(VACANT)

S 71° 40' 01" W 435.60'

SPLIT 5 - 1.0000 AC


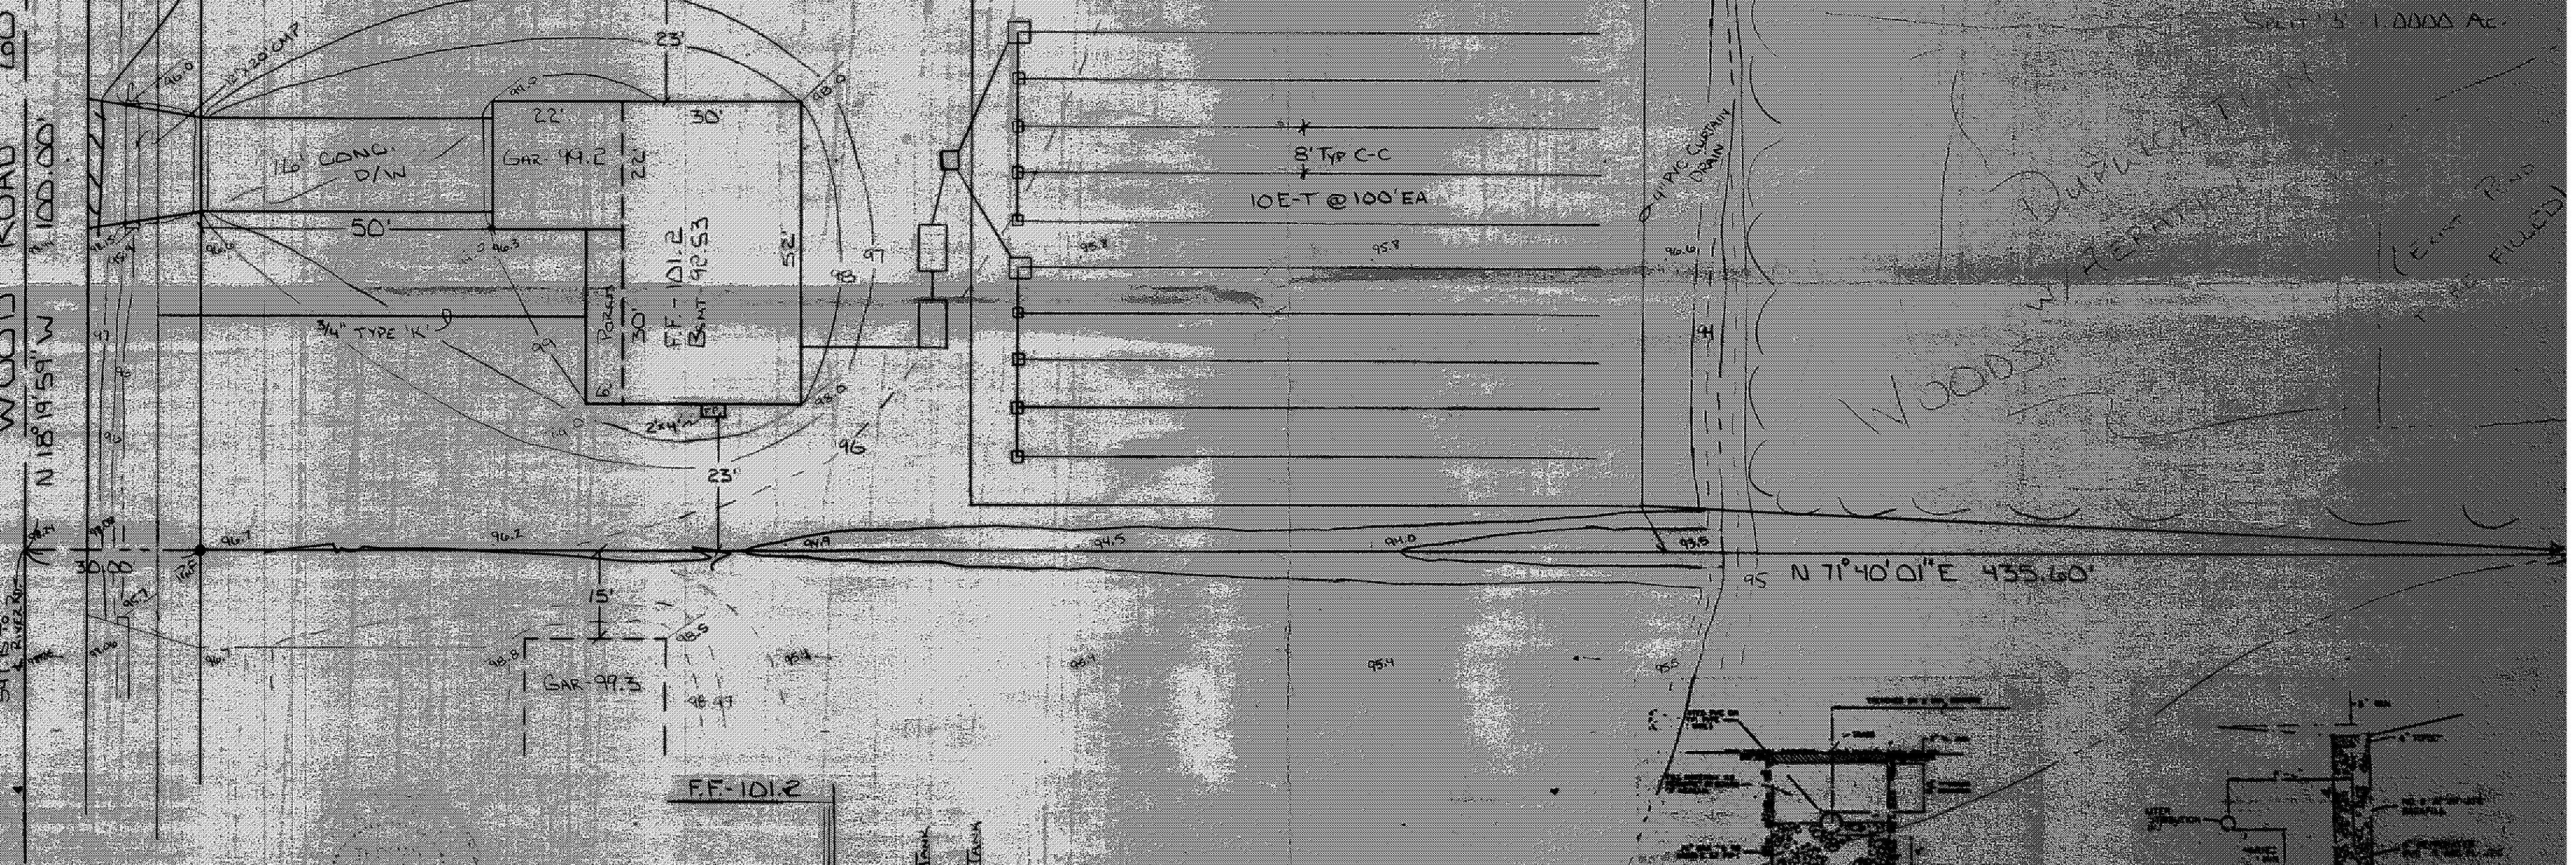


FF-101.2

*Gravel Ramp Ready
for Pumping in Bmnt

Bmnt-92.53

1000 Gall Tank
120 95.0
1000 Gall Tank
120 94.5
SPLITTER
120 94.7
Dist Box (2)
120 94.6

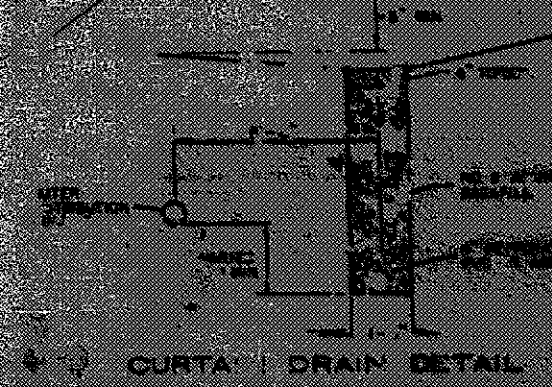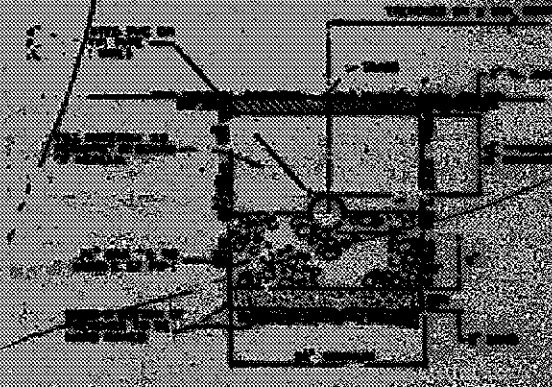

Grading Plan Approved
as shown and/or noted
THOMAS P. GILLES, P.E.
Lake County Engineer

By 6514 Date 1-27-97
- 3' Minimum Asphalt Apron
- Shale as shown

I, the undersigned hereby certify that
this mapwork, indicated by 1" contours,
and elevations shown herein represent an
actual field survey made by me on DEC. 20, 1996
and that the elevations were taken at
appropriate intervals and that as of that
date they existed as indicated herein.

APPROVED
MADISON TOWNSHIP ZONING
JAN 23 1997
15602
ZONING SPECTOR

VILLAGE SURVEYING CO.
P.O. BOX 1096, FAIRPORT HARBOR, OHIO
(216) 357-1339