


"I, the undersigned hereby certify that this topography indicated by 6", 1", or 2' contours, and elevations shown hereon represent an actual field survey made by me on the 12th day of July, 2003 and that the elevations were taken at appropriate intervals and that as of that date they existed as indicated hereon."

James R. Gills 46343
Name Reg. No.

- 591.5 1st Floor F.F. Per Approved Site Plan
- "As-built" Top of Block/Slab
- 1st Floor F.F. Per "As-built" Site Plan

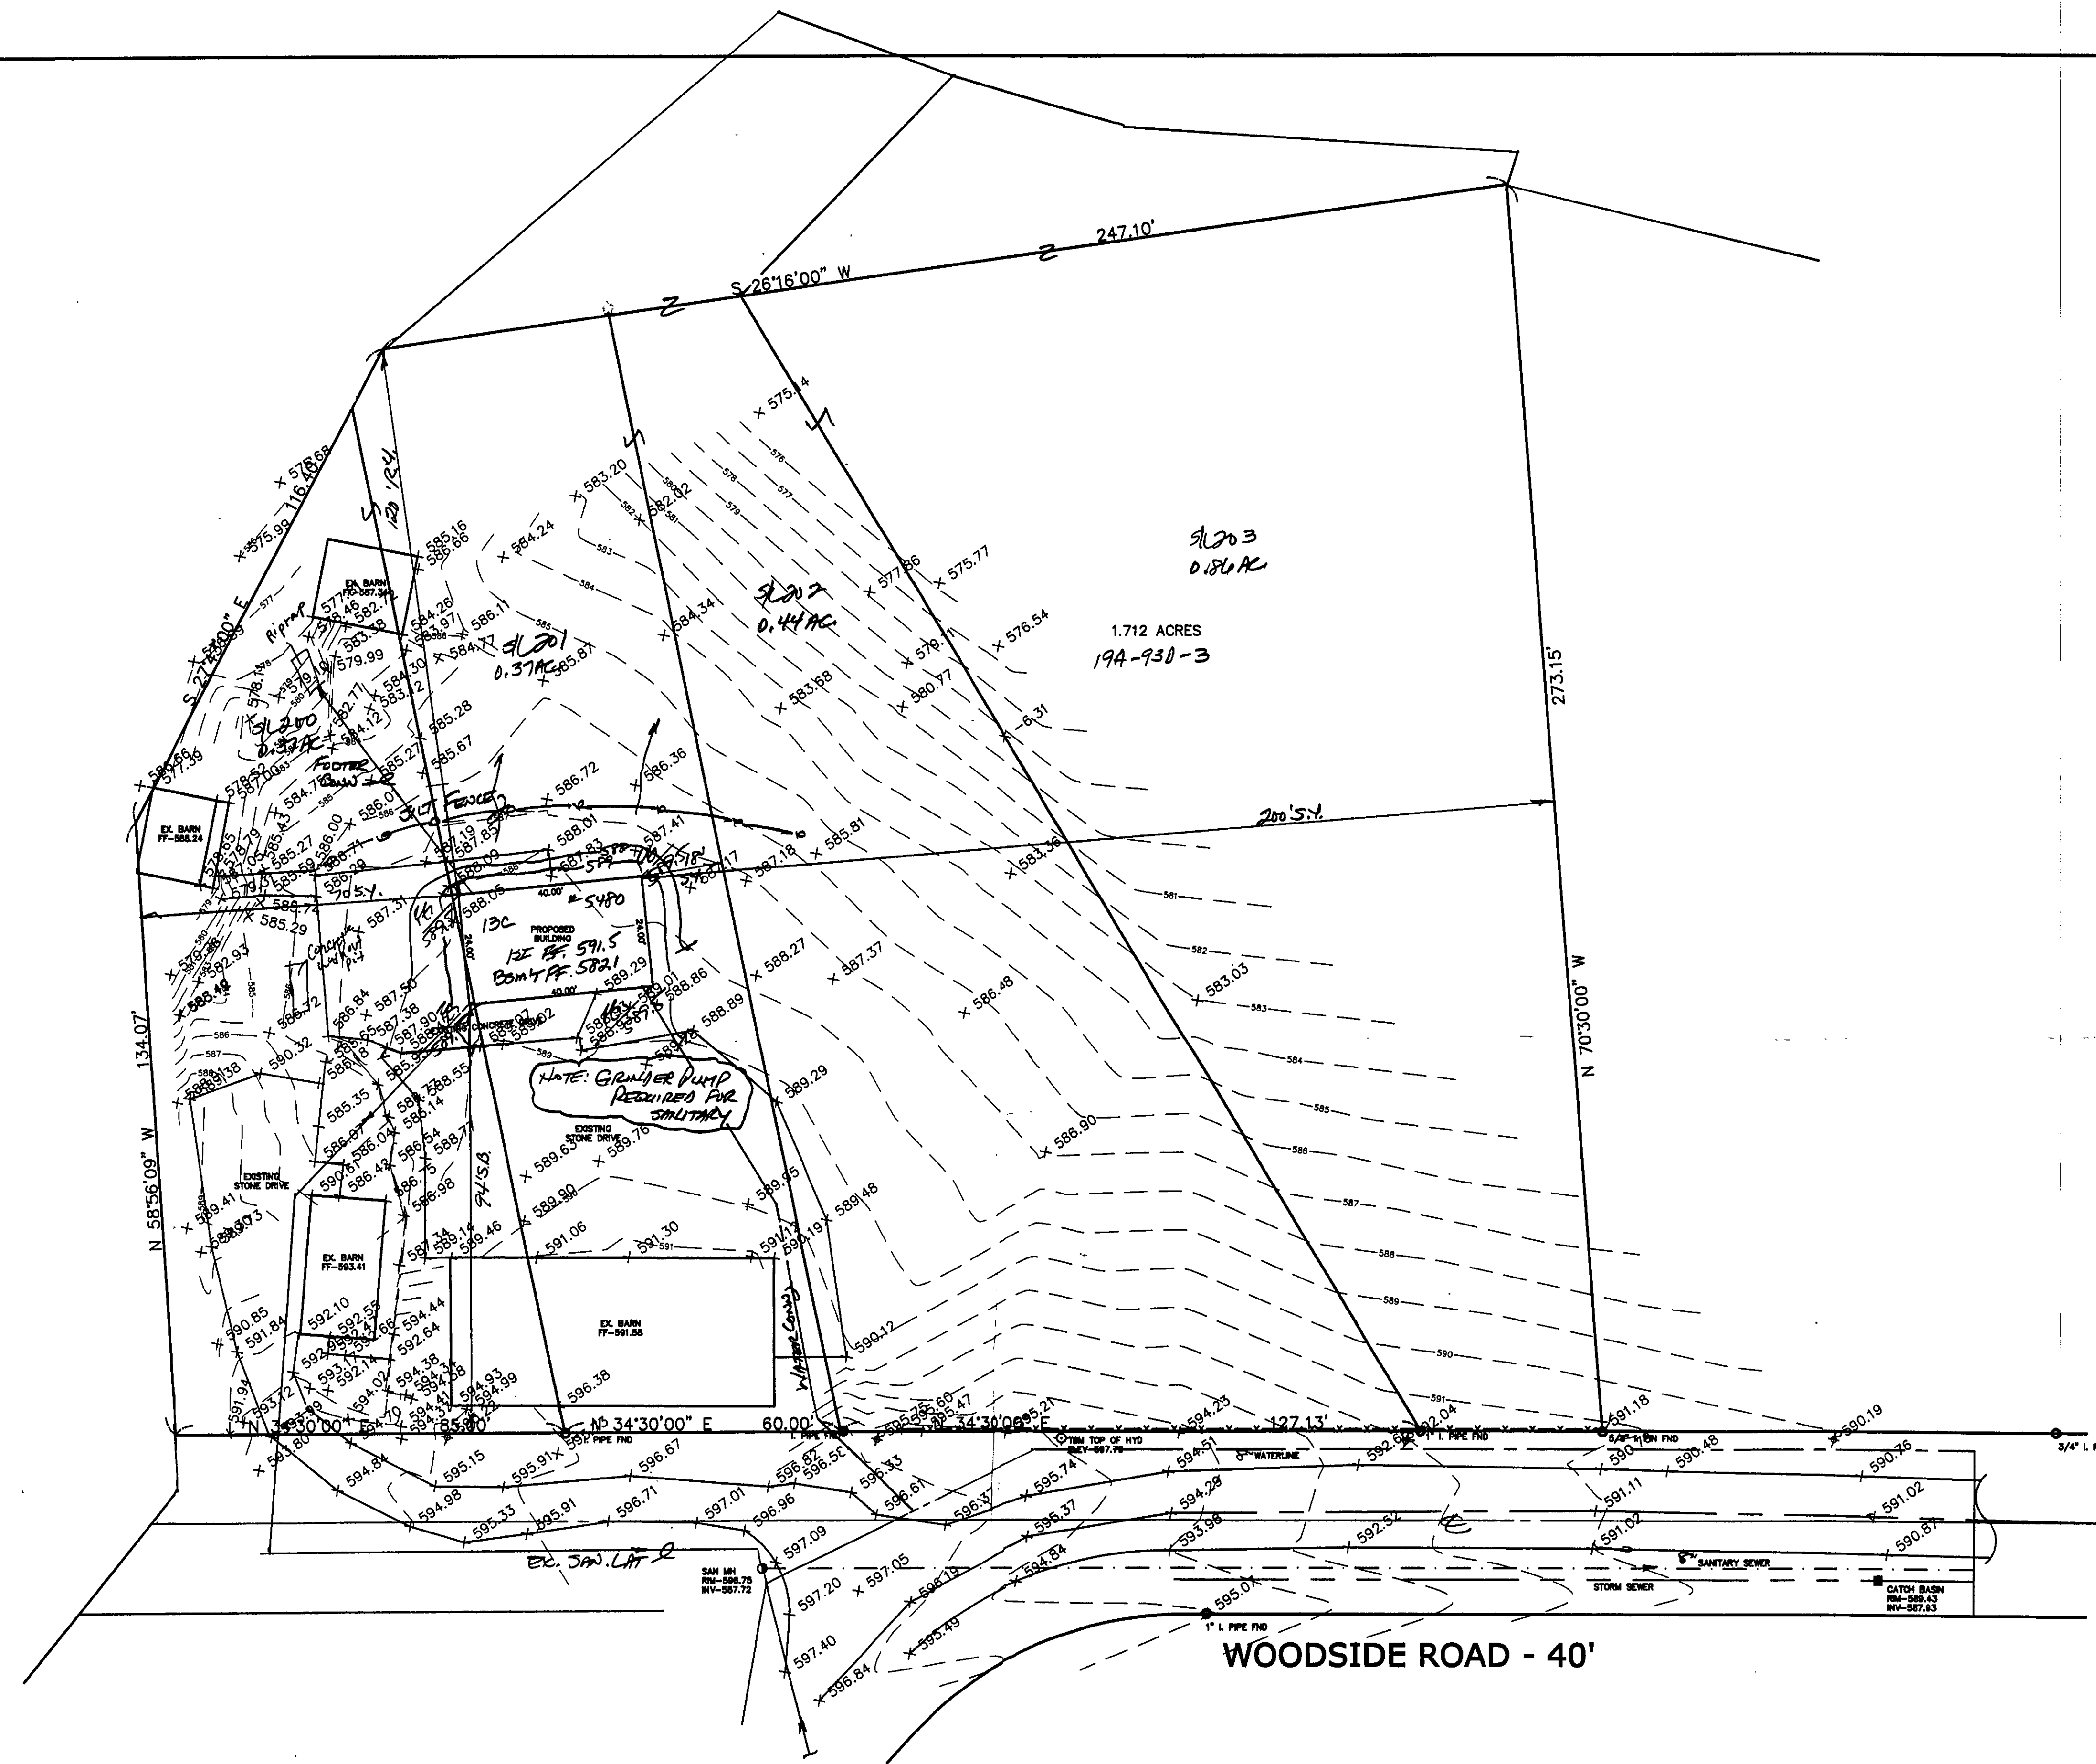

Stormwater Management Plan
Approved as shown and/or noted
JAMES R. GILLS, P.E.
County Drainage Engineer
By *6/17* Date *11/24/03*


Subject to approval by:

- ☒ Zoning Department
- ☐ LC General Health District
- ☐ LC Soil & Water Conservation District
- ☒ LC Building Department (Final approval)

ROOF DRAINS
SHALL DISCHARGE
TO SPLASH BLOCKS.

TBM TOP OF FIRE HYDRANT
ELEV=597.79

EXISTING UTILITIES NOTE:
THE SIZE AND LOCATION, BOTH HORIZONTAL AND VERTICAL
OF THE UNDERGROUND UTILITIES SHOWN HEREON, HAVE BEEN
OBTAINED BY A SEARCH OF AVAILABLE RECORDS.
VERIFICATION BY FIELD OBSERVATION HAS BEEN CONDUCTED
WHERE PRACTICAL, HOWEVER, BABCOCK, JONES AND ASSOCIATES
INC. DOES NOT GUARANTEE THE COMPLETENESS NOR ACCURACY
THEREOF.

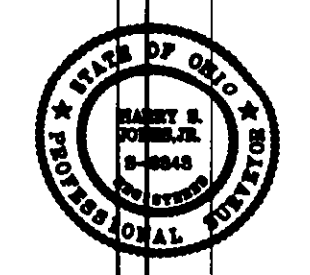

REV. NO.	DESCRIPTION	DATE	BY	CHK'D

bj BABCOCK, JONES AND ASSOCIATES, INC
CIVIL ENGINEERS - SURVEYORS - LAND PLANNERS
PAINESVILLE OHIO 44077

DATE 11/17/03
DESIGN BY HJ
DRAWN BY NS
APPROVED BY HJ

SITE PLAN
FOR
DON JACOBSON
5480 WOODSIDE ROAD PARCEL 19A-93D-3
MENTOR ON THE LAKE LAKE COUNTY STATE OF OHIO

SCALE 1"=20'
JOB NO 03-270
SHEET 1 OF 1