

Grading Plan Approved
as shown and/or noted
THOMAS P. GILLES, P.E.
Lake County Engineer
By 6/14 Date 11.22.93



SCALE: 1"=20'

EXIST
PROP


EXIST
PROP

SITE PLAN

FOR

BILL BARBIS

BEING 9/1723 IN THE LAKE BREEZE PARK CO.'s
MADISON SUBDIVISION No. 2 MADISON TWP.
LAKE COUNTY OHIO

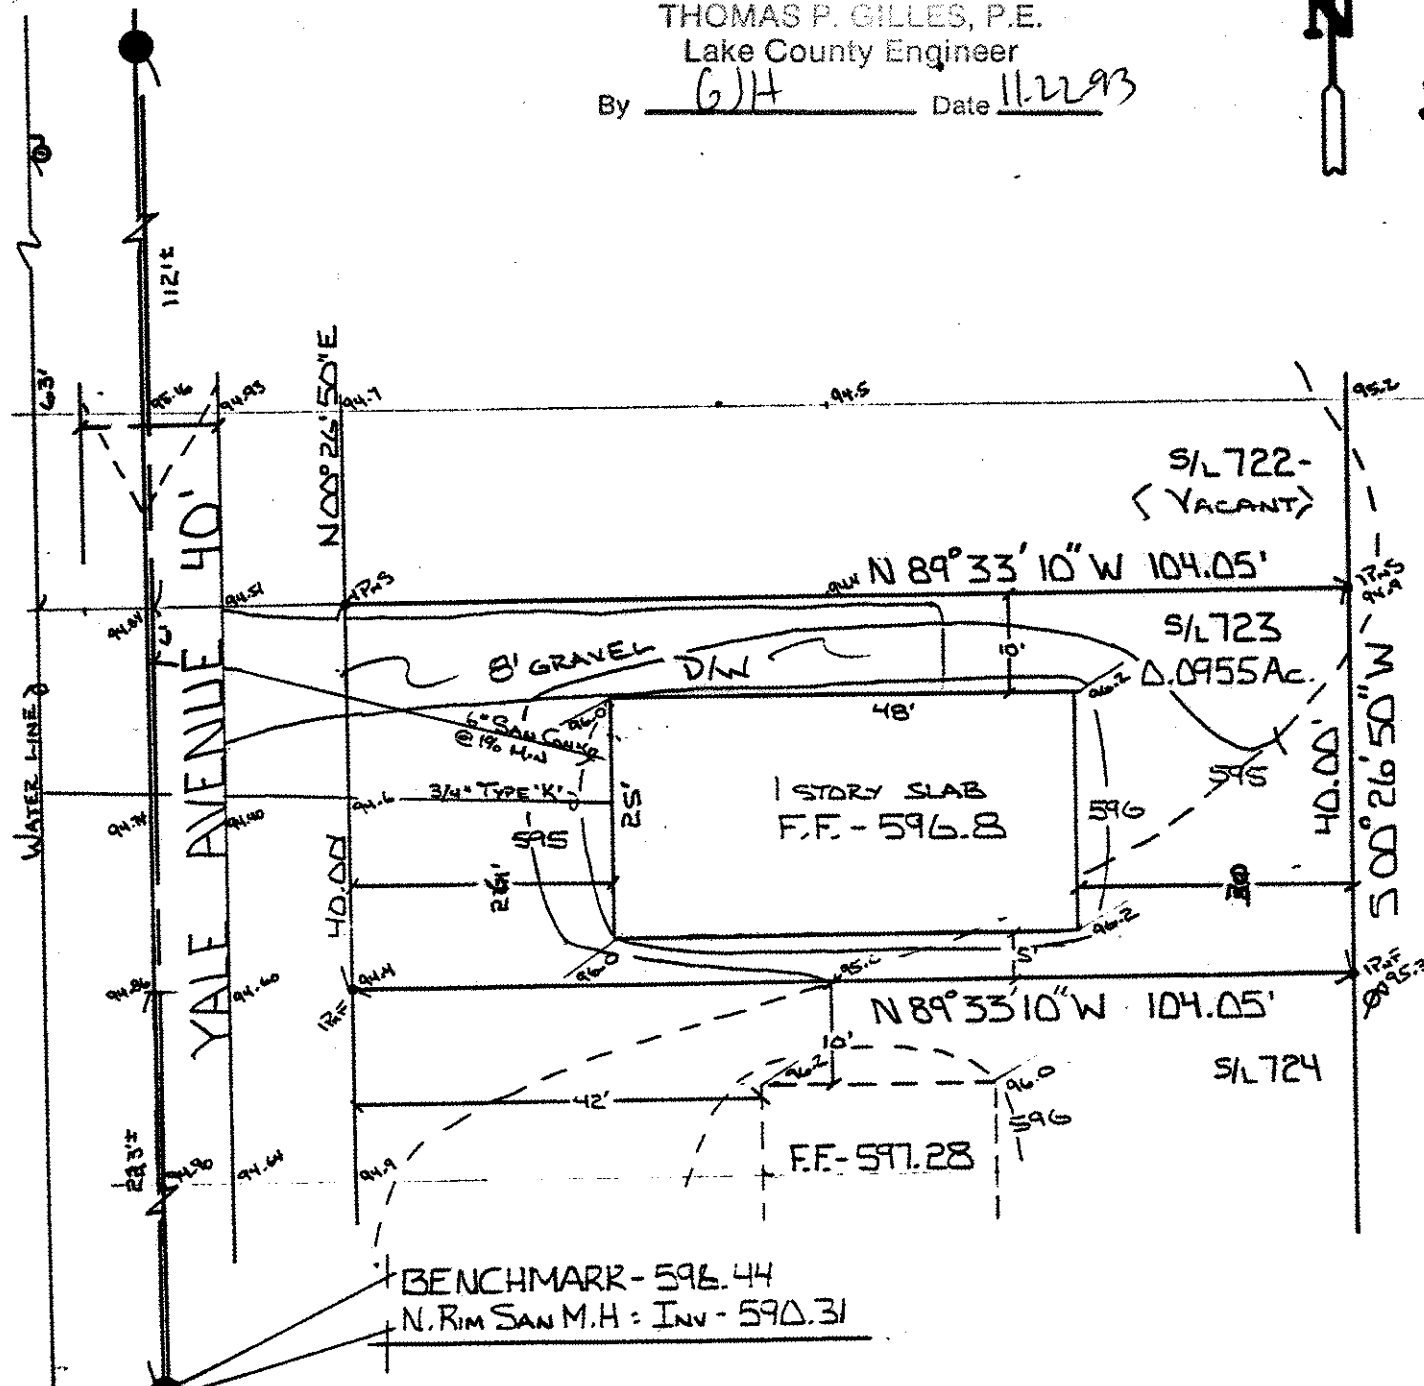


APPROVED
MADISON TWP. ZONING
PERMIT 13969
Issued 11/22/93
NOV. 12 1993

SUBLOT No.	
720	
724	
726	
728	
Ave	

SETBACK
24.7'
48.0'
35.7'
26.4'
32.2'

I, the undersigned hereby certify that
this topography, indicated by 1' contours,
and elevations shown herein represent an
actual field survey made by me on Oct 1, 1993
and that the elevations were taken at
appropriate intervals and that as of that
date they existed as indicated herein.

J.M. Coffman P.S.
No. 6857

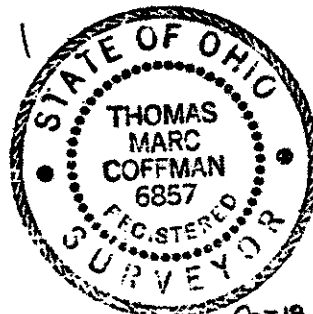

Oct. 18, 1993

VILLAGE SURVEYING CO.
FAIRPORT HARBOR, OHIO 44077
(216) 357-1359