


SALIDA ROAD 60'

ANNA COURT 25'


(DED. PLAT VOL. Z, PG. 7)

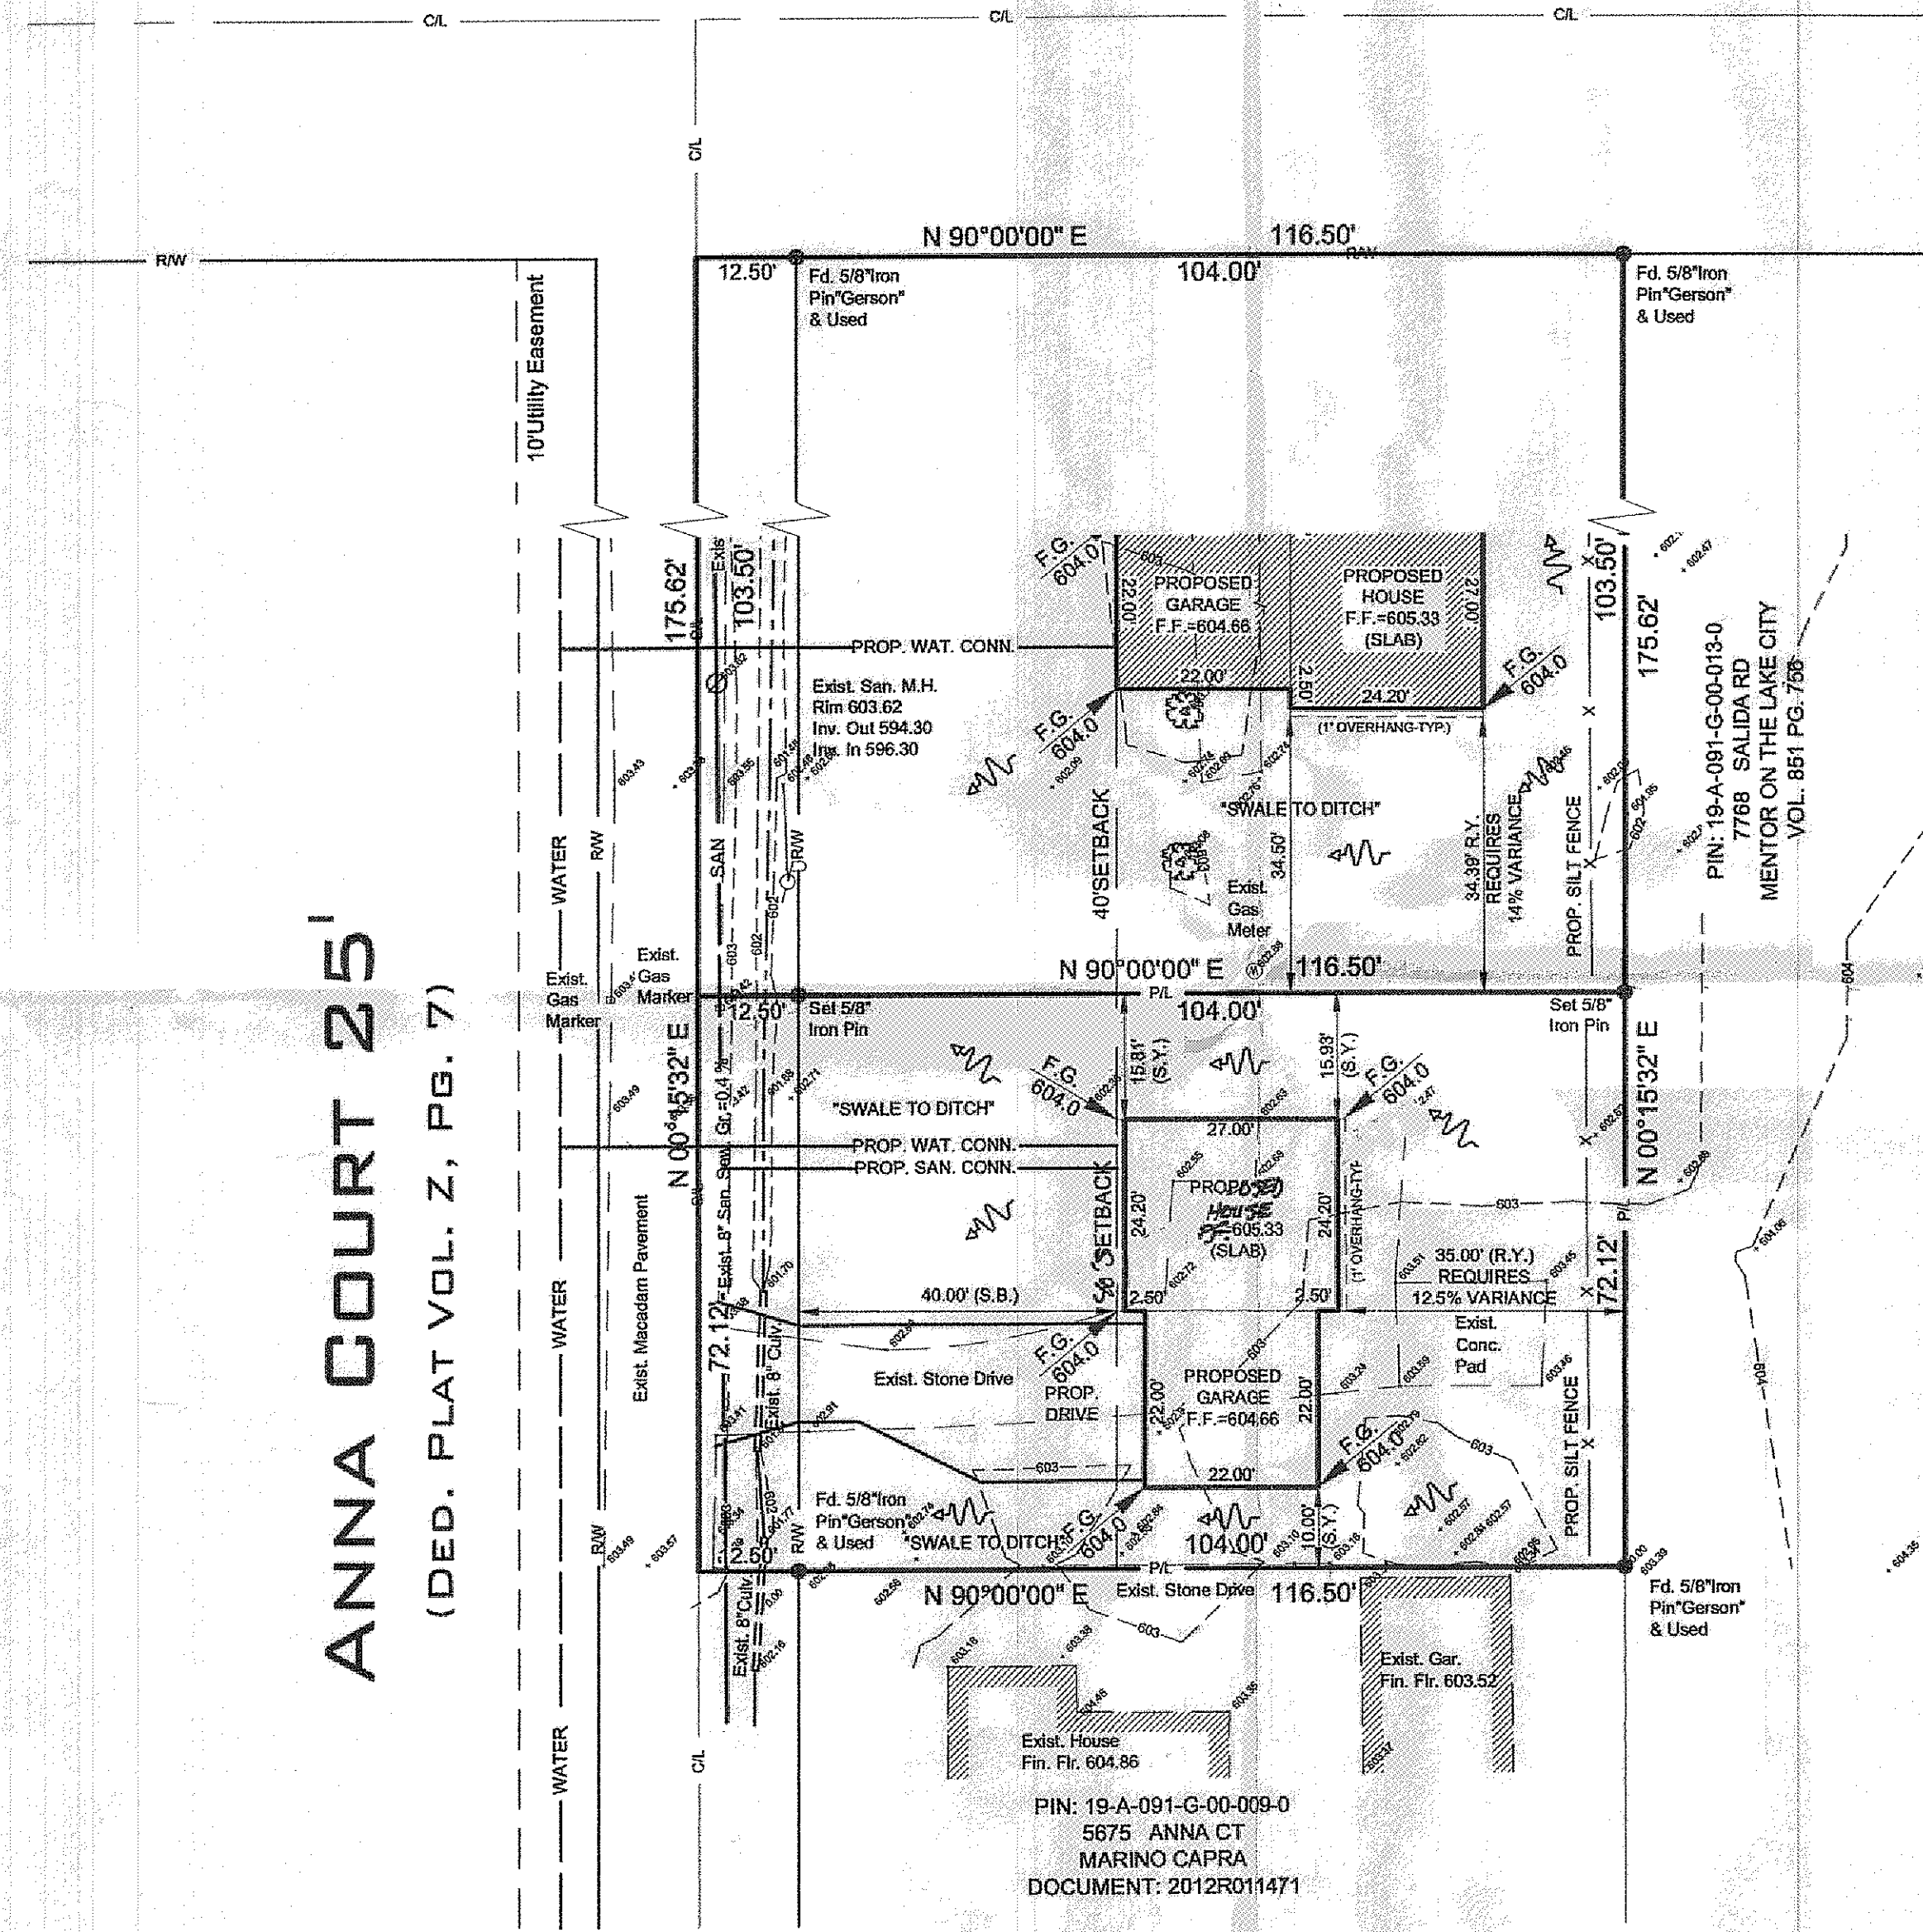


Site Plan
M-O-L, Lake County, Ohio
for: **A@R ENTERPRISES**
CLIENT: _____ OWNER: _____
ADDRESS: _____ STREET: _____ CITY: _____ ZIP: _____
SUBDIVISION: _____ NAME: _____ TRACT: _____ STREET: _____
VOL.-PG. _____ LOT: _____ 19-A-091-G-00-03
SUBLOT NO. _____ STREET: _____ VOL.-PG. _____ PERM. PARCEL NO. _____

DESIGN CERTIFICATION
THIS PLAT WAS PREPARED BY ME, AND IS CORRECT TO THE BEST OF MY KNOWLEDGE AND BELIEF.
Harry S. Jones Jr. #6343
HARRY S. JONES JR. SURVEYOR REGISTRATION NO. 6343

I, the undersigned, hereby certify that this topography, indicated by 1' contours, and elevations shown hereon, represent an actual field survey made by me on the 9TH day of AUG., 2011, and that the elevations were taken at appropriate intervals and that as of that date they existed as indicated hereon.
Harry S. Jones Jr. #6343
Harry S. Jones Jr. P.S. #6343

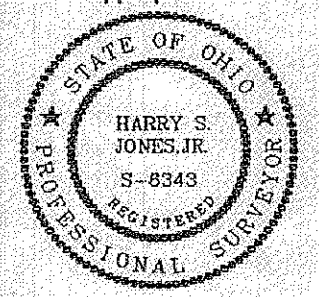

Stormwater Management Plan
Approved as shown and noted
JAMES R. GILL, P.E.
County Drainage Engineer
By *L.S.* Date 10/24/12

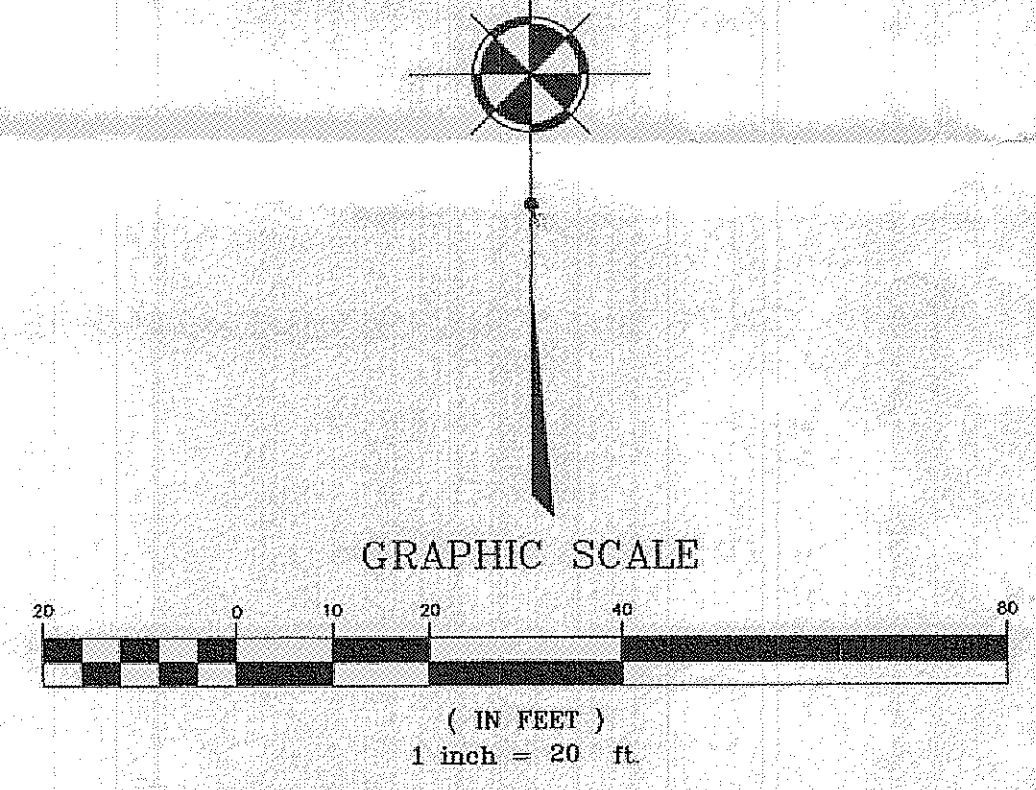

"AS BUILT" CERTIFICATION
I, hereby certify that the circled grades are existing finish grades checked in the field on 10/24/12, and are correct to the best of my knowledge and belief.
HARRY S. JONES JR. - P.S. 6343

EXIST. ELEV. 100.0 PROP. ELEV. 100.0
AS BUILT ELEVATION 100.0
INDICATES DIRECTION OF SURFACE DRAINAGE
2 WORKING DAYS BEFORE YOU DIG
CALL TOLL FREE 800-362-2764
OHIO UTILITIES PROTECTION SERVICE

"This plan has been prepared solely for the purpose of establishing grading, drainage, location of utility connections, and compliance with local zoning regulations and is based upon plans approved by agencies having jurisdiction. Jones Surveying, LLC does not warrant or guarantee structural components of the structure or the underlying soils".
BENCHMARK: RIM OF SAN. M.H. AT INTERSECTION OF SALIDA RD. & ANNA COURT ELEV.=602.91

EXISTING UNDERGROUND UTILITIES NOTE:
"The size and location, both horizontal and vertical, of the underground utilities shown hereon, have been obtained by a diligent and comprehensive search of available records. Verification by field observation has been conducted where practical. However, Jones Surveying, LLC does not guarantee the completeness nor accuracy thereof."

REVISIONS			Jones Surveying, LLC		
NO.	DATE	BY	ENGINEERS - SURVEYORS - PLANNERS	1924 MENTOR AVE., PAINESVILLE, OHIO 440-357-1811	440-357-9173 (FAX) hjonessurveying@yahoo.com
1			DRAWN BY	rt	SCALE 1"=20'
2			CHCKD.	rt	DATE 6/22/12
3			CREW CHIEF	wb	APPD HJ
4					PHONE NO. 440-357-1811
5					DRAWING NO. 11-112