


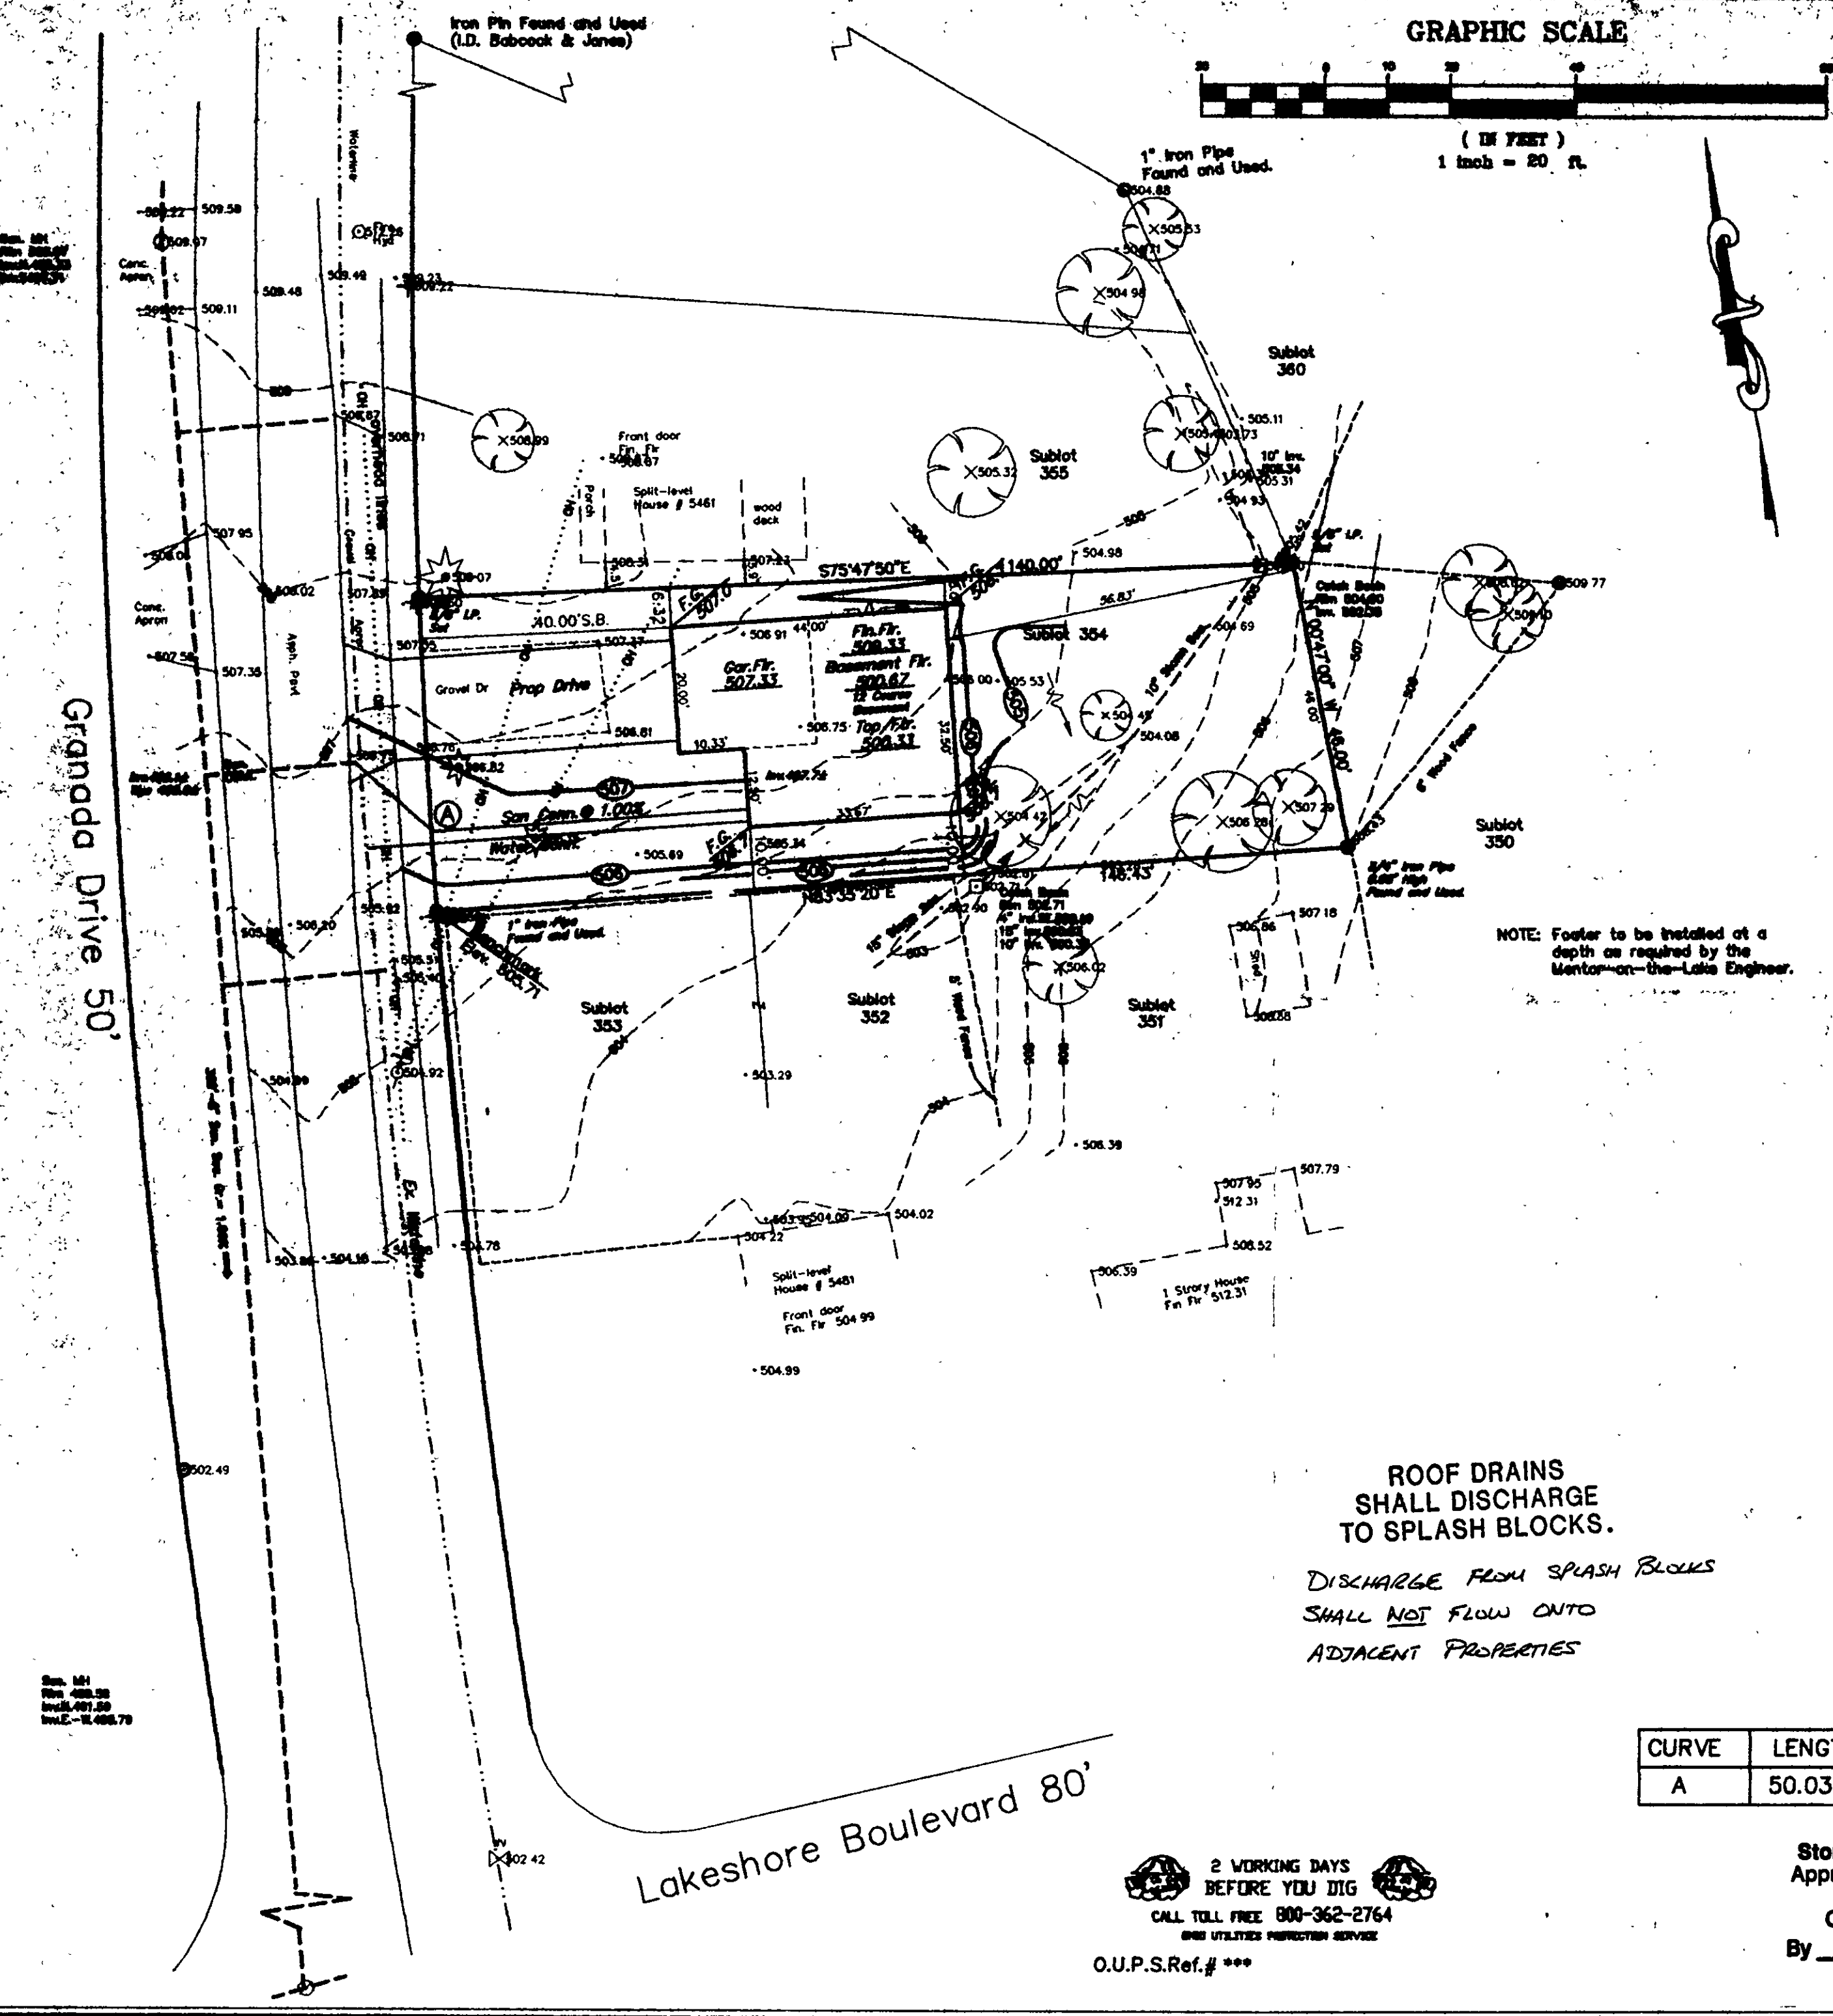

SITE PLAN

for : Marcellino Construction
CLIENT

2748 Rockefeller Road Willoughby Hills
ADDRESS STREET CITY

354 Mentor Harbor Re-Subdivision H 51
SUBLOT No. SUBDIVISION NAME VOL PAGE

Mentor on the Lake Ohio
LOT TRACT

DESIGN CERTIFICATION

THIS PLAT WAS PREPARED BY ME, AND IS CORRECT TO THE BEST OF MY KNOWLEDGE AND BELIEF.

[Signature]

NAME	DATE
DRAWN BY Sus	SCALE 1" = 20'
CHECK'D BY	DATE March/2004

BENCHMARK Top of 1" Iron Pipe at Southwest Property Corner
Elev. 505.71

I, THE UNDERSIGNED, HEREBY CERTIFY THAT THIS TOPOGRAPHY, INDICATED BY 6", 1", OR 2" CONTOURS AND ELEVATIONS SHOWN HEREON, REPRESENT AN ACTUAL FIELD SURVEY MADE BY ME ON THE 17th DAY OF JUNE, 2004 AND THAT THE ELEVATIONS WERE TAKEN AT PROPER INTERVALS AND THAT AS OF DATE THEY EXISTED AS INDICATED HEREON.

[Signature] 5/10/04
RICHARD A. THOMPSON, JR. P.S. No. 7388



**ROOF DRAINS
SHALL DISCHARGE
TO SPLASH BLOCKS.**

DISCHARGE FROM SPLASH BLOCKS
SHALL NOT FLOW ONTO
ADJACENT PROPERTIES

CURVE TABLE

CURVE	LENGTH	RADIUS	DELTA	TANGENT
A	50.03'	1483.67'	01°55'55"	25.02'

2 WORKING DAYS
BEFORE YOU DIG
CALL TOLL FREE 800-362-2764
OHIO UTILITIES PROTECTION SERVICE
O.U.P.S. Ref. # ***

Stormwater Management Plan
Approved as shown and/or noted
JAMES R. GILLS, P.E.
County Drainage Engineer
By L.S. Date 5/18/04

MARCC1-0401