

SITE PLAN

for **TOM REED**
 CLIENT OWNER
CHESTNUT ST., RAINESVILLE
 ADDRESS STREET CITY
 SUBLOT NO. SUBDIVISION NAME VOL. PAGE
12~4 PAINESVILLE TWP OHIO
 LOT, TRACT

REMARKS

ALL BOUNDARY DATA SHOWN WAS OBTAINED FROM (DEEDS, RECORDED SUBDIVISION PLAT OR OTHER PUBLIC RECORDS). LOCATIONS AS SHOWN OF ADJACENT WELLS AND SEPTIC TANKS OBTAINED FROM LAKE COUNTY HEALTH DEPARTMENT.

LEGEND

SANITARY MANHOLE ————
 PROPOSED CONTOURS ————
 EXIST. ELEV. ————
 100.0 ———— PROP. ELEV.
 WATER VALVE (GAS) ————
 DIRECTION OF SURFACE DRAINAGE

CHECK LIST

NO. OF BEDROOMS	WATER MAIN SIZE, LOCATION
DIMENSIONS	SAN. SEWER SIZE, GR. LOC.
BEARINGS	SAN. MH. CAST. ELEV. IN. ELEV.
TIE TO NEAREST STREET	SAN. CONN. SIZE, LOC. DEPTH
SUBLOT NO. PARCEL NO.	STORM SEWER SIZE, GR. LOC.
SURROUNDING OWNERS	STORM MH. CAST. ELEV. INV. ELEV.
BLDG. DIMENSIONS FIN. GR.	PAV'T TYPE GRADE CURBS
BLDG. TIES FL'R. GRADES	GAS LINE LOC. SIZE PRESSURE
APRON TYPE WIDTH THICKNESS	SEPTIC TANK LOCATION & DIRECTION
SEWAGE TYPE WIDTH THICKNESS	ISOLATION AREA
CULVERT TYPE DIA. LENGTH	WELL LOCATION
ROCK OUTCROPPINGS	ISOLATION RADIUS FROM WELL

DESIGN CERTIFICATION

THIS PLAT WAS PREPARED BY ME, AND IS CORRECT TO THE BEST OF MY KNOWLEDGE AND BELIEF.

NAME SURVEYOR REGISTRATION NO.

"AS BUILT" CERTIFICATION


I HEREBY CERTIFY THAT THE CIRCLED GRADES ARE EXISTING GRADES OBTAINED ON THE SITE ON 19 AND ARE CORRECT TO THE BEST OF MY ACKNOWLEDGMENT AND BELIEF.



LAND DESIGN consultants, inc.

9613 JACKSON STREET MENTOR, OHIO 44060
 TELEPHONE (216) 951-6872 or 354-6646

1	DRAWN BY	SCALE	DRAWING NO.
2	CHK'D. <td>DATE <td rowspan="2">237</td> </td>	DATE <td rowspan="2">237</td>	237
3	CREW CHIEF <td>APP'D. </td>	APP'D.	

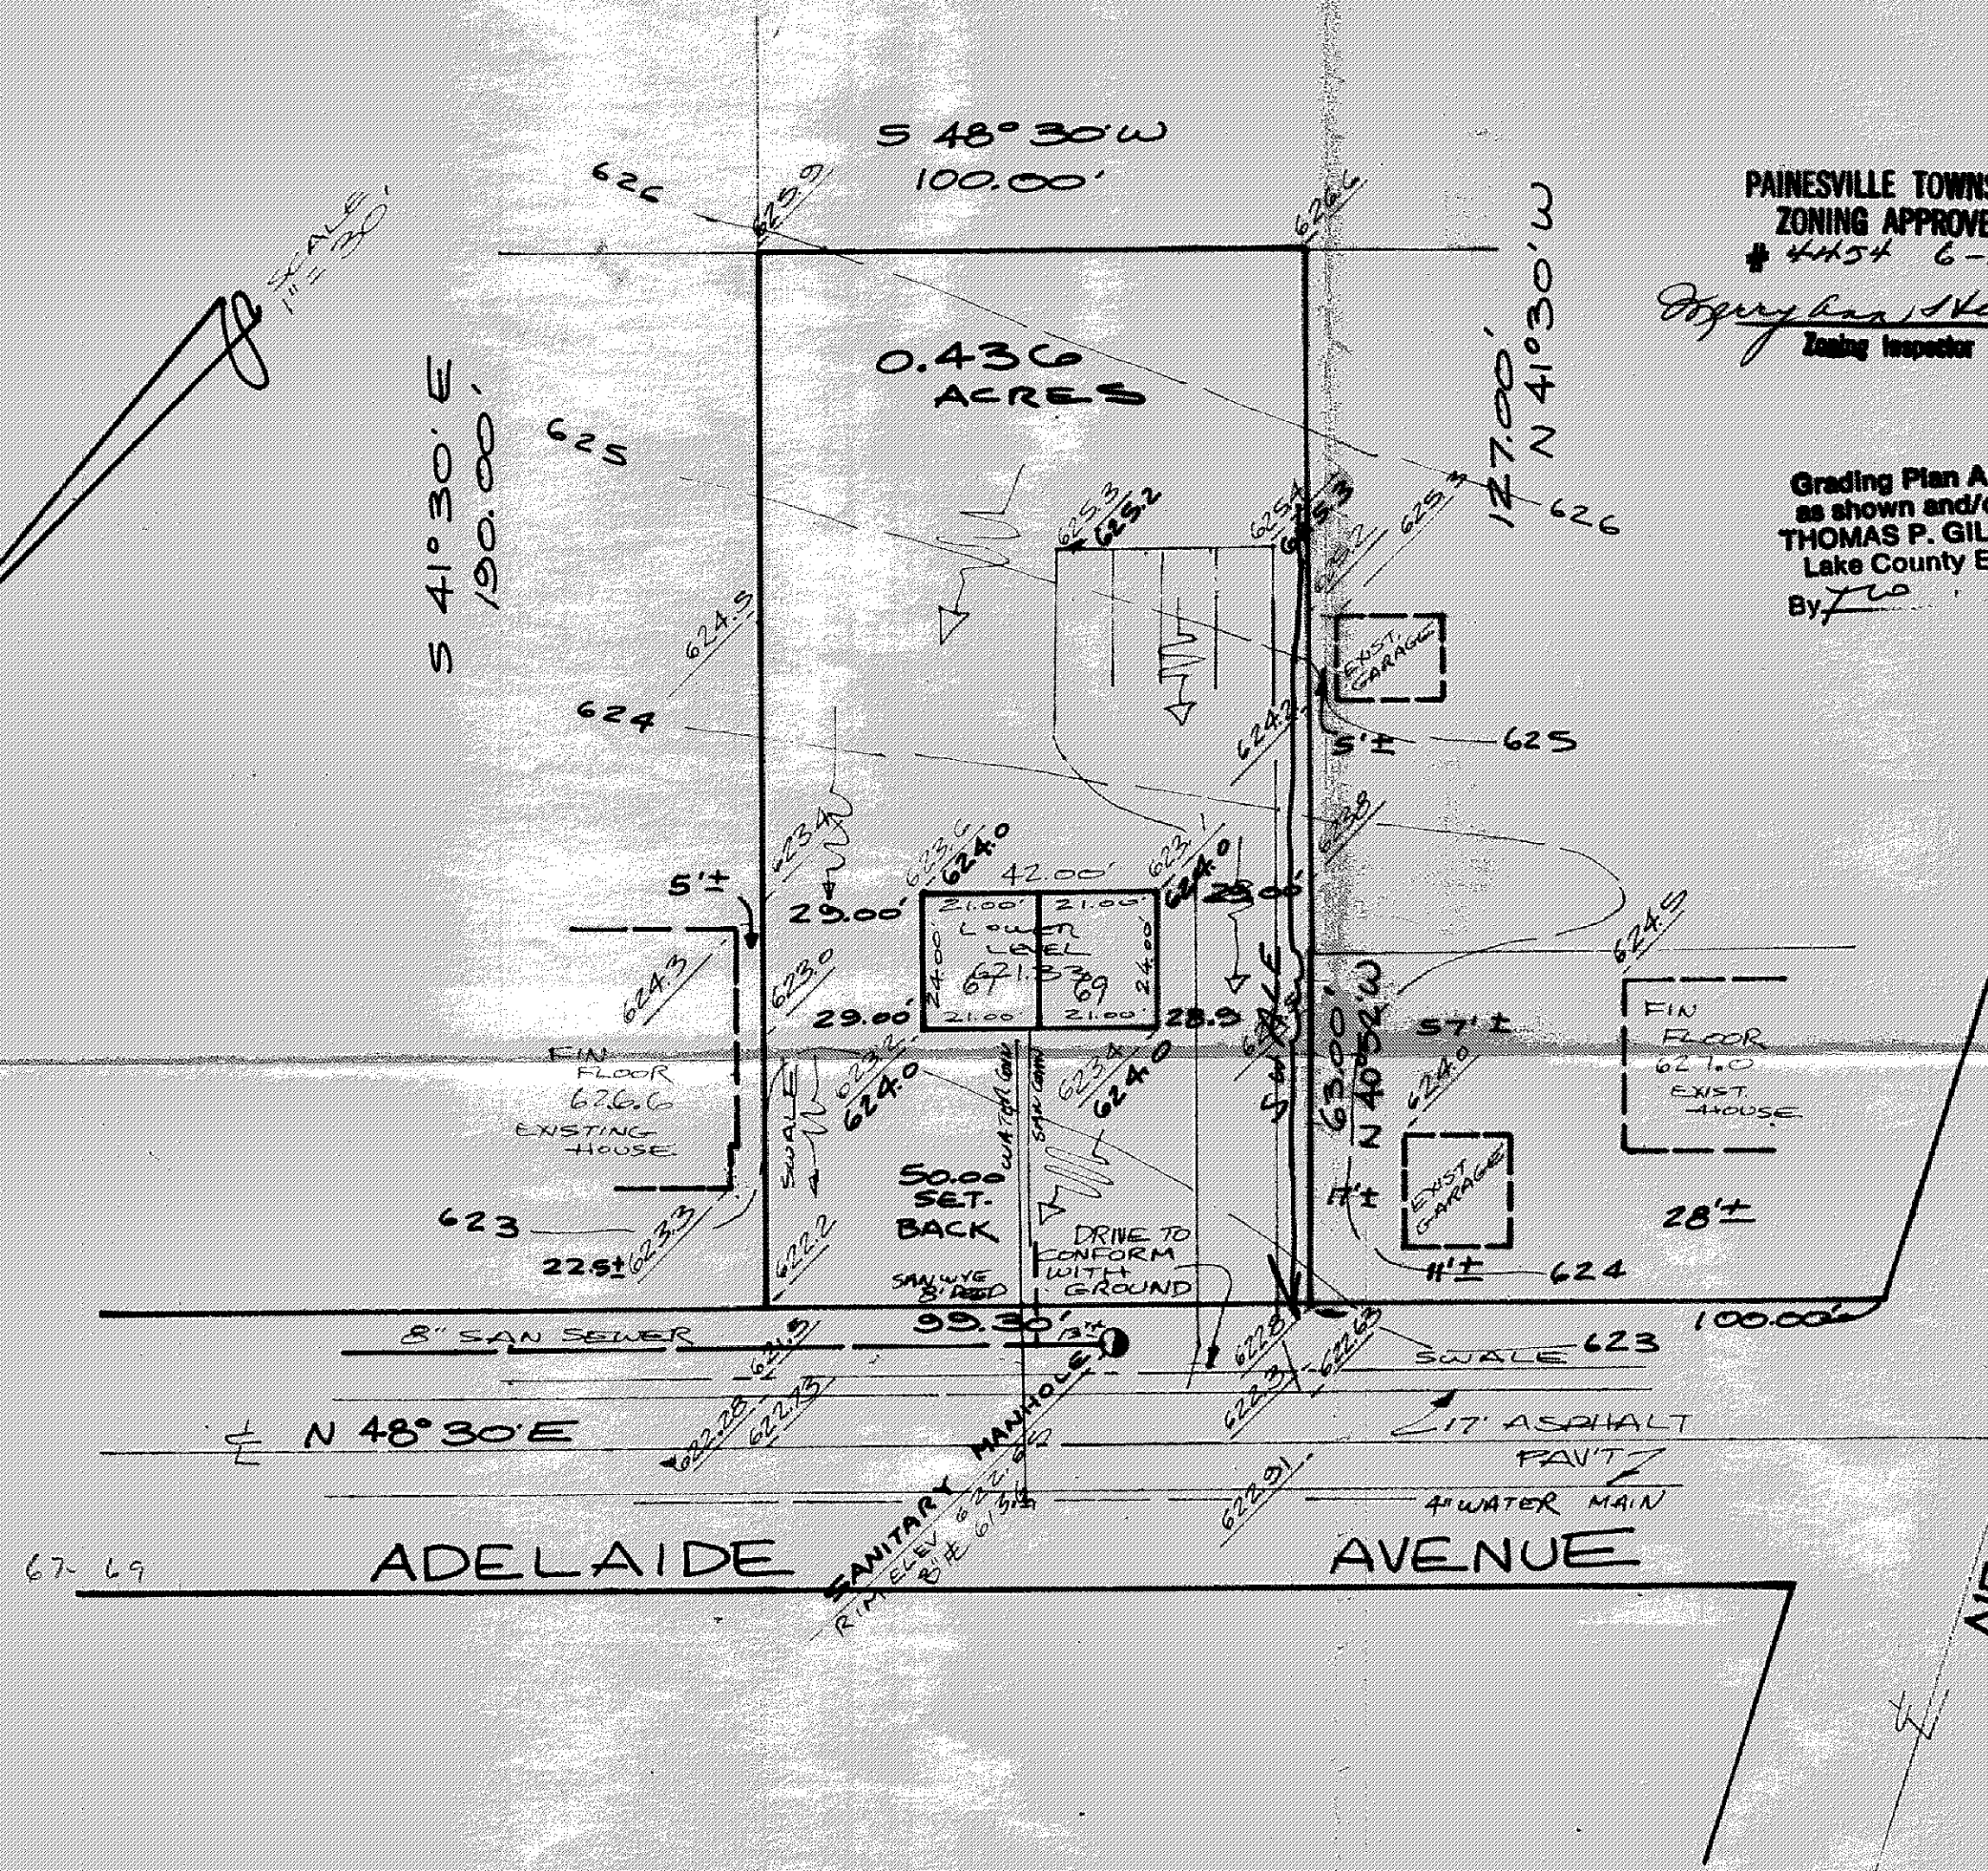

PAINESVILLE TOWNSHIP
 ZONING APPROVED
 4454 6-12-78

Gregory R. Henderson
 Zoning Inspector

Grading Plan Approved
 as shown and/or noted
 THOMAS P. GILLES, P.E.
 Lake County Engineer
 By *T.P.G.* 12 Jun 79

NEWELL STREET

ADELAIDE AVENUE

#5000 2000