

SITE PLAN

PAINESVILLE TWP., LAKE COUNTY, OHIO

for: **EL MOORE HOMES INC.**

1435 **Amberwood Lane** ZIP

DETAILED SUBDIVISION
SUBDIVISION 16-37 NAME
VOL. NO. 45
SUBLOT NO. 45

LOT
VOLUME
PAGE
TRACT
FED. PARCEL NO.
STREET

LEGEND

SANITARY MANHOLE
STORM MANHOLE
INLET OR CATCH BASIN
HYDRANT
EXISTING CONTOURS
PROPOSED CONTOURS
EXIST. ELEV.
100.0
100.0
PROP. ELEV.
100.0
100.0
SURFACE DRAINAGE

REMARKS

ALL BOUNDARY DATA SHOWN WAS OBTAINED FROM IDEEDS, RECORDED
SUBDIVISION PLAT OR OTHER PUBLIC RECORDS
LOCATIONS AS SHOWN OF ADJACENT WELLS AND SEPTIC TANKS OBTAINED FROM
LAKE COUNTY HEALTH DEPARTMENT

DESIGN CERTIFICATION

THIS PLAT WAS PREPARED BY ME, AND IS CORRECT
TO THE BEST OF MY KNOWLEDGE AND BELIEF.

NAME
SURVEYOR REGISTRATION NO.

CHECK LIST

NO. OF BEDROOMS
DIMENSIONS
BEARINGS
TIE TO NEAREST STREET
SUBLOT NO. PARCEL NO.
SURROUNDING OWNERS
BLDG. DIMENSIONS FIN. GR.
BLDG. TIES ELEV. GRADERS
PERSON TYPE WIDTH THICKNESS
SIDEWALK TYPE DIA. LENGTH
CULVERT TYPE DIA. LENGTH
ROCK OUTCROPPINGS

PLAN PREPARED BY:

BABCOCK • JONES & ASSOCIATES, INC.
PAINESVILLE, OHIO

NO.	DATE	BY	SCALE	PHONE NO.
1			1" = 20'	357-1811
2				
3				
4				
5				

"AS BUILT" CERTIFICATION

I, HEREBY CERTIFY THAT THE CIRCLED GRADES ARE EXISTING
FINISH GRADES CHECKED IN THE FIELD ON 19
AND ARE CORRECT TO THE BEST OF MY KNOWLEDGE AND BELIEF.


REGISTERED SURVEYOR

REG. NO.

BENCHMARK: ELM SAND MH #17 (SL 35), 700.15

Grading Plan Approved
as shown and/or
THOMAS P. GILL
Lake County Eng.
By UA Date 6/16/92

AMBERWOOD LANE - 140'

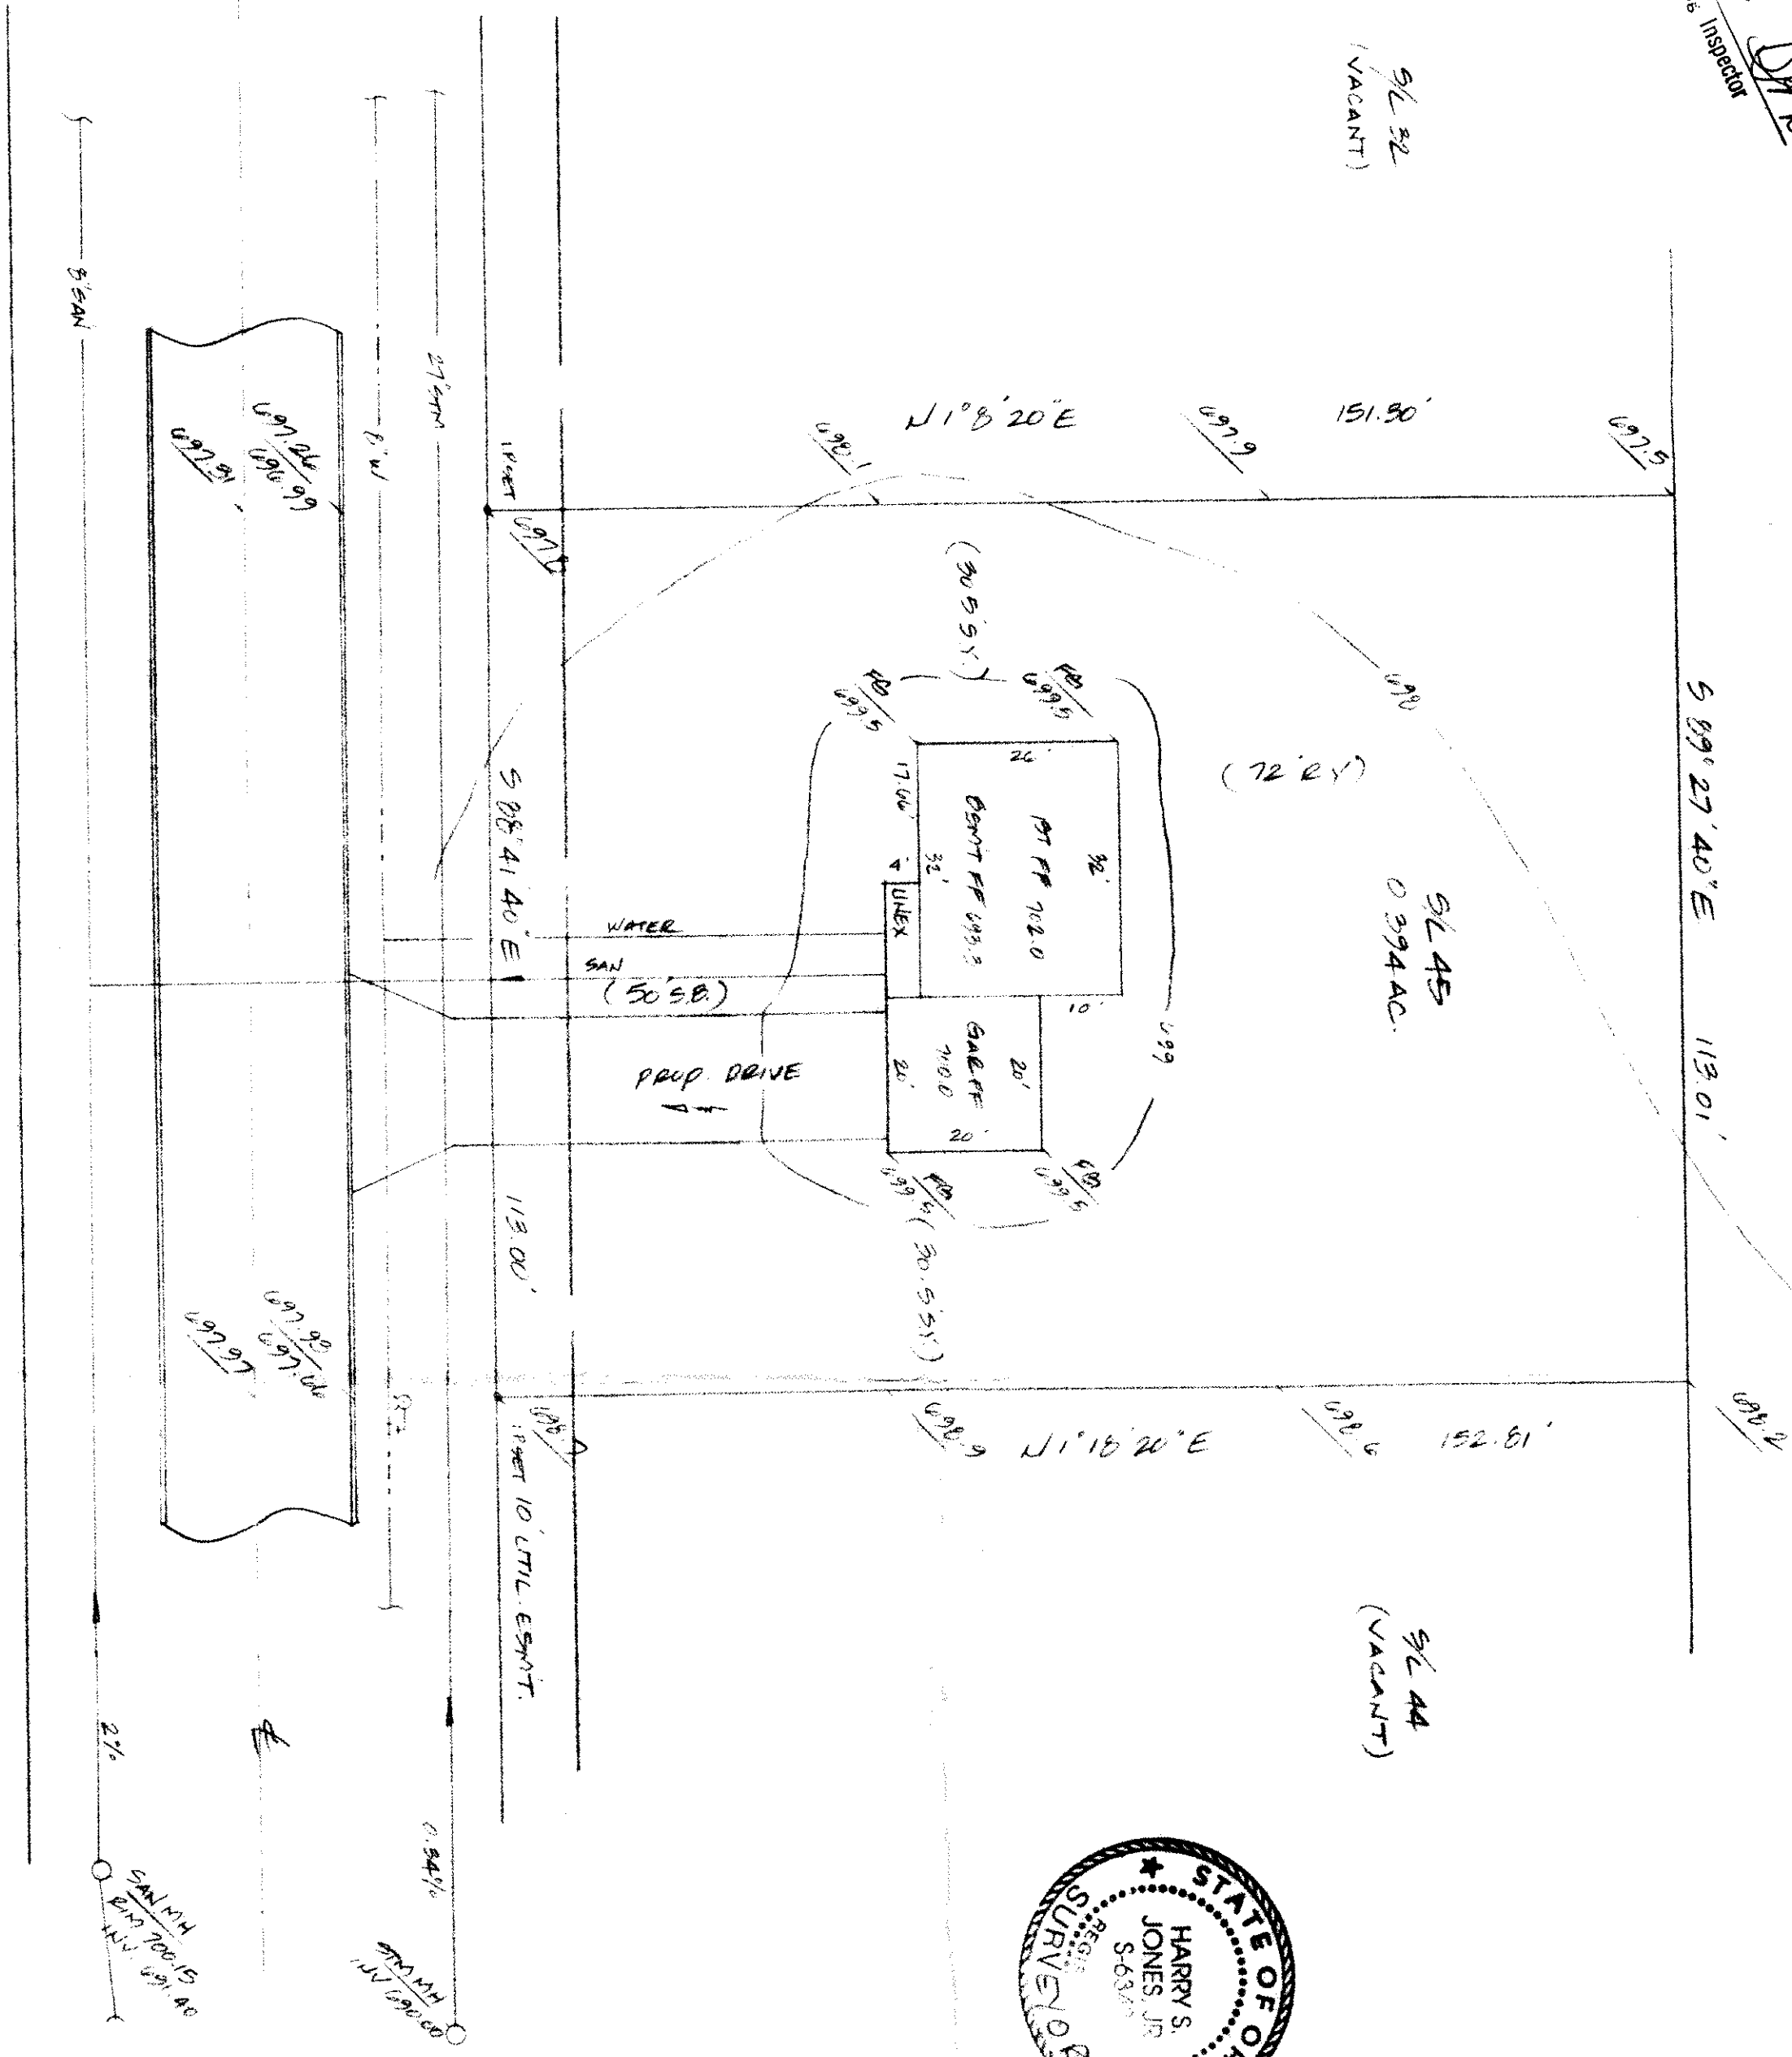

This Permit Expires
PAINESVILLE TOWNSHIP
ENGINEER APPROVED
#0477
Inspector

SL 32
(VACANT)

SL 45
0.994 AC.

SL 44
(VACANT)