

SITE PLAN

Radcliffe Township, Lake County, Ohio

for: WILSHIRE HOMES

CLIENT _____ **OWNER** _____

ADDRESS	STREET	CITY	ZIP
---------	--------	------	-----

Cedar Glen Sub

SUBDIVISION 16-39 N/A

SUBLOT NO. 41122000
STREET CHINA

LOT	TRACT
VOLUME	PAGE
PERM. PARCEL NO.	STREET

LEGEND

SANITARY	MANHOLE	WATER VALVE (GAS)	
STORM	MANHOLE	WATER METER (GAS)	
INLET ON CATCH BASIN		AS BUILT ELEVATION	
HYDRANT			
EXISTING CONTOURS			
PROPOSED CONTOURS			
EXIST. ELEV.	100.0		
	100.0		
	100.0		
	PROP. ELEV.		

INDICATES
DIRECTION OF
SURFACE DRAINAGE

100.0

REMARKS

ALL BOUNDARY DATA SHOWN WAS OBTAINED FROM (DEEDS, RECORDED
SUBDIVISION PLAT OR OTHER PUBLIC RECORDS)

LOCATIONS AS SHOWN OF ADJACENT WELLS AND SEPTIC TANKS OBTAINED FROM
LAKE COUNTY HEALTH DEPARTMENT

DESIGN CERTIFICATION

THIS PLAT WAS PREPARED BY ME, AND IS CORRECT TO THE BEST OF MY KNOWLEDGE AND BELIEF.

NAME	DATE	REMARKS	NO.
✓	10/10/10	10/10/10	10/10/10

CHECK LIST

NO. OF BEDROOMS	WATER MAIN SIZE	LOCATION
DIMENSIONS	5AN. SEWER SIZE	% GR. LOC.
BEARINGS	5AN. C&T. ELEV.	INV. ELEV.
TIE TO NEAREST STREET	5AN. CONN. SIZE	LOC. DEPTH
PLU LOT NO. PARCEL NO.	STORM SEWER SIZE	% GR. LOC.
ADJOINING OWNERS	STORM IN. C&T. ELEV.	INV. ELEV.
BLOOD DIMENSIONS FIN. GR.	PAV'T TYPE	GRADE CORRS.
BLDG. TYPE	4AS LINE	LOC. SIZE
THICKNESS	LOC. SIZE	PRESSURE
ADJACENT TYPE	SEPTIC TANK	LOCATION & DUPPLICATION AREA
WIDHTH THICKNESS	WELL	LOCATION
DELIVER TYPE	RADIUS FROM	WELL
LOC. OUTCROPPINGS		

PLAN PREPARED BY:

BABCOCK • JONES & ASSOCIATES, INC.

PAINESVILLE, OHIO

7	1" = 20'	357-1811
---	----------	----------

CHKD.	#7	DATE	11/13/55	DRAWING NO.
-------	----	------	----------	-------------

APPROVED	92-078-43
CHIEF	WAB

"AS BUILT" CERTIFICATION

I, HEREBY CERTIFY THAT THE CIRCLED GRADES ARE EXISTING
FINISH GRADES CHECKED IN THE FIELD ON _____, 19____
AND ARE CORRECT TO THE BEST OF MY KNOWLEDGE AND BELIEF.

REGISTERED SURVEYOR


REG. NO

TBM-TSFH-S/L 44

ETED. = 100.14

6414 12795

**ROOF DRAINS
SHALL DISCHARGE
TO SPLASH BLOCKS.**

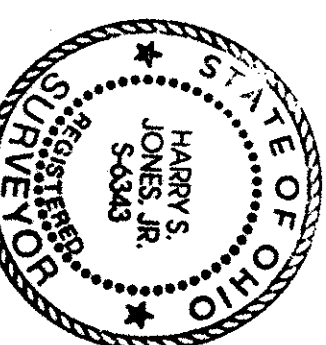

APPROVED
PAINESVILLE TOWNSHIP
ZONING DEPARTMENT
#96-12-02 DFR