


CURVE DATA

A = 48.28'	A = 182.95'***
R = 2742.63'	R = 924.93'
C = 48.28'	C = 182.66'
Δ = 1° 00' 31"	Δ = 11° 20' 00"
N 7° 01' 45" W	S 76° 48' 00" W
A = 47.12'***	
R = 30.00'	
C = 42.43'	
Δ = 90° 00' 00"	
N 52° 32' 00" W	

Grading Plan Approved
as shown and/or noted
THOMAS P. GILLES, P.E.
Leica County Engineer
By GH Date 2/24/92

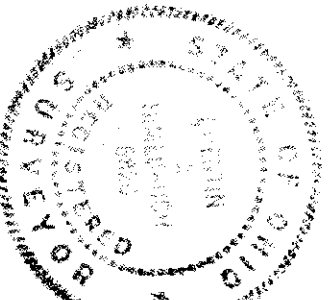

GENERAL NOTES:

1. DRIVEWAY APRON TO BE 6" THICK
2. BENCHMARK - TOP STEM OF FIRE HYDRANT LOCATED IN FRONT OF SUBLT NO. 107, ELEV. = 718.54

LEGEND

EXISTING CONTOUR
PROPOSED CONTOUR
EXISTING ELEVATION
PROPOSED ELEVATION

CERTIFICATION

"I THE UNDERSIGNED HEREBY CERTIFY THAT THIS TOPOGRAPHY INDICATED BY 'I' CONTOURS AND ELEVATIONS SHOWN HEREON REPRESENTS AN ACTUAL SURVEY MADE BY ME ON THE 6th DAY OF FEB. 1992 AND THE ELEVATIONS WERE TAKEN AT APPROPRIATE INTERVALS AND AS OF THAT DAY THEY EXISTED AS INDICATED HEREON.

"I HEREBY CERTIFY THAT THIS PLAN WAS PREPARED BY ME AND IS CORRECT TO THE BEST OF MY KNOWLEDGE"

Quentin S. Himebaugh
QUENTIN S. HIMEBAUGH, P.S. No. 6820


PREPARED BY:

Himebaugh and Associates
Surveyors and Site Consultants
38083 West Spaulding St.
Willoughby, Ohio 44094
(216) 946-1761

SITE PLAN:

SUBLT NO. 85 APPLETREE COURT 60', PAINESVILLE TWP.
HEATHERSTONE SUBDIVISION, VOL. Z, PG. 35

PREPARED FOR:
SCALE: 1" = 20'
DATE: FEBRUARY 10, 1992
DRAWN BY: DAVID W. NOVAK

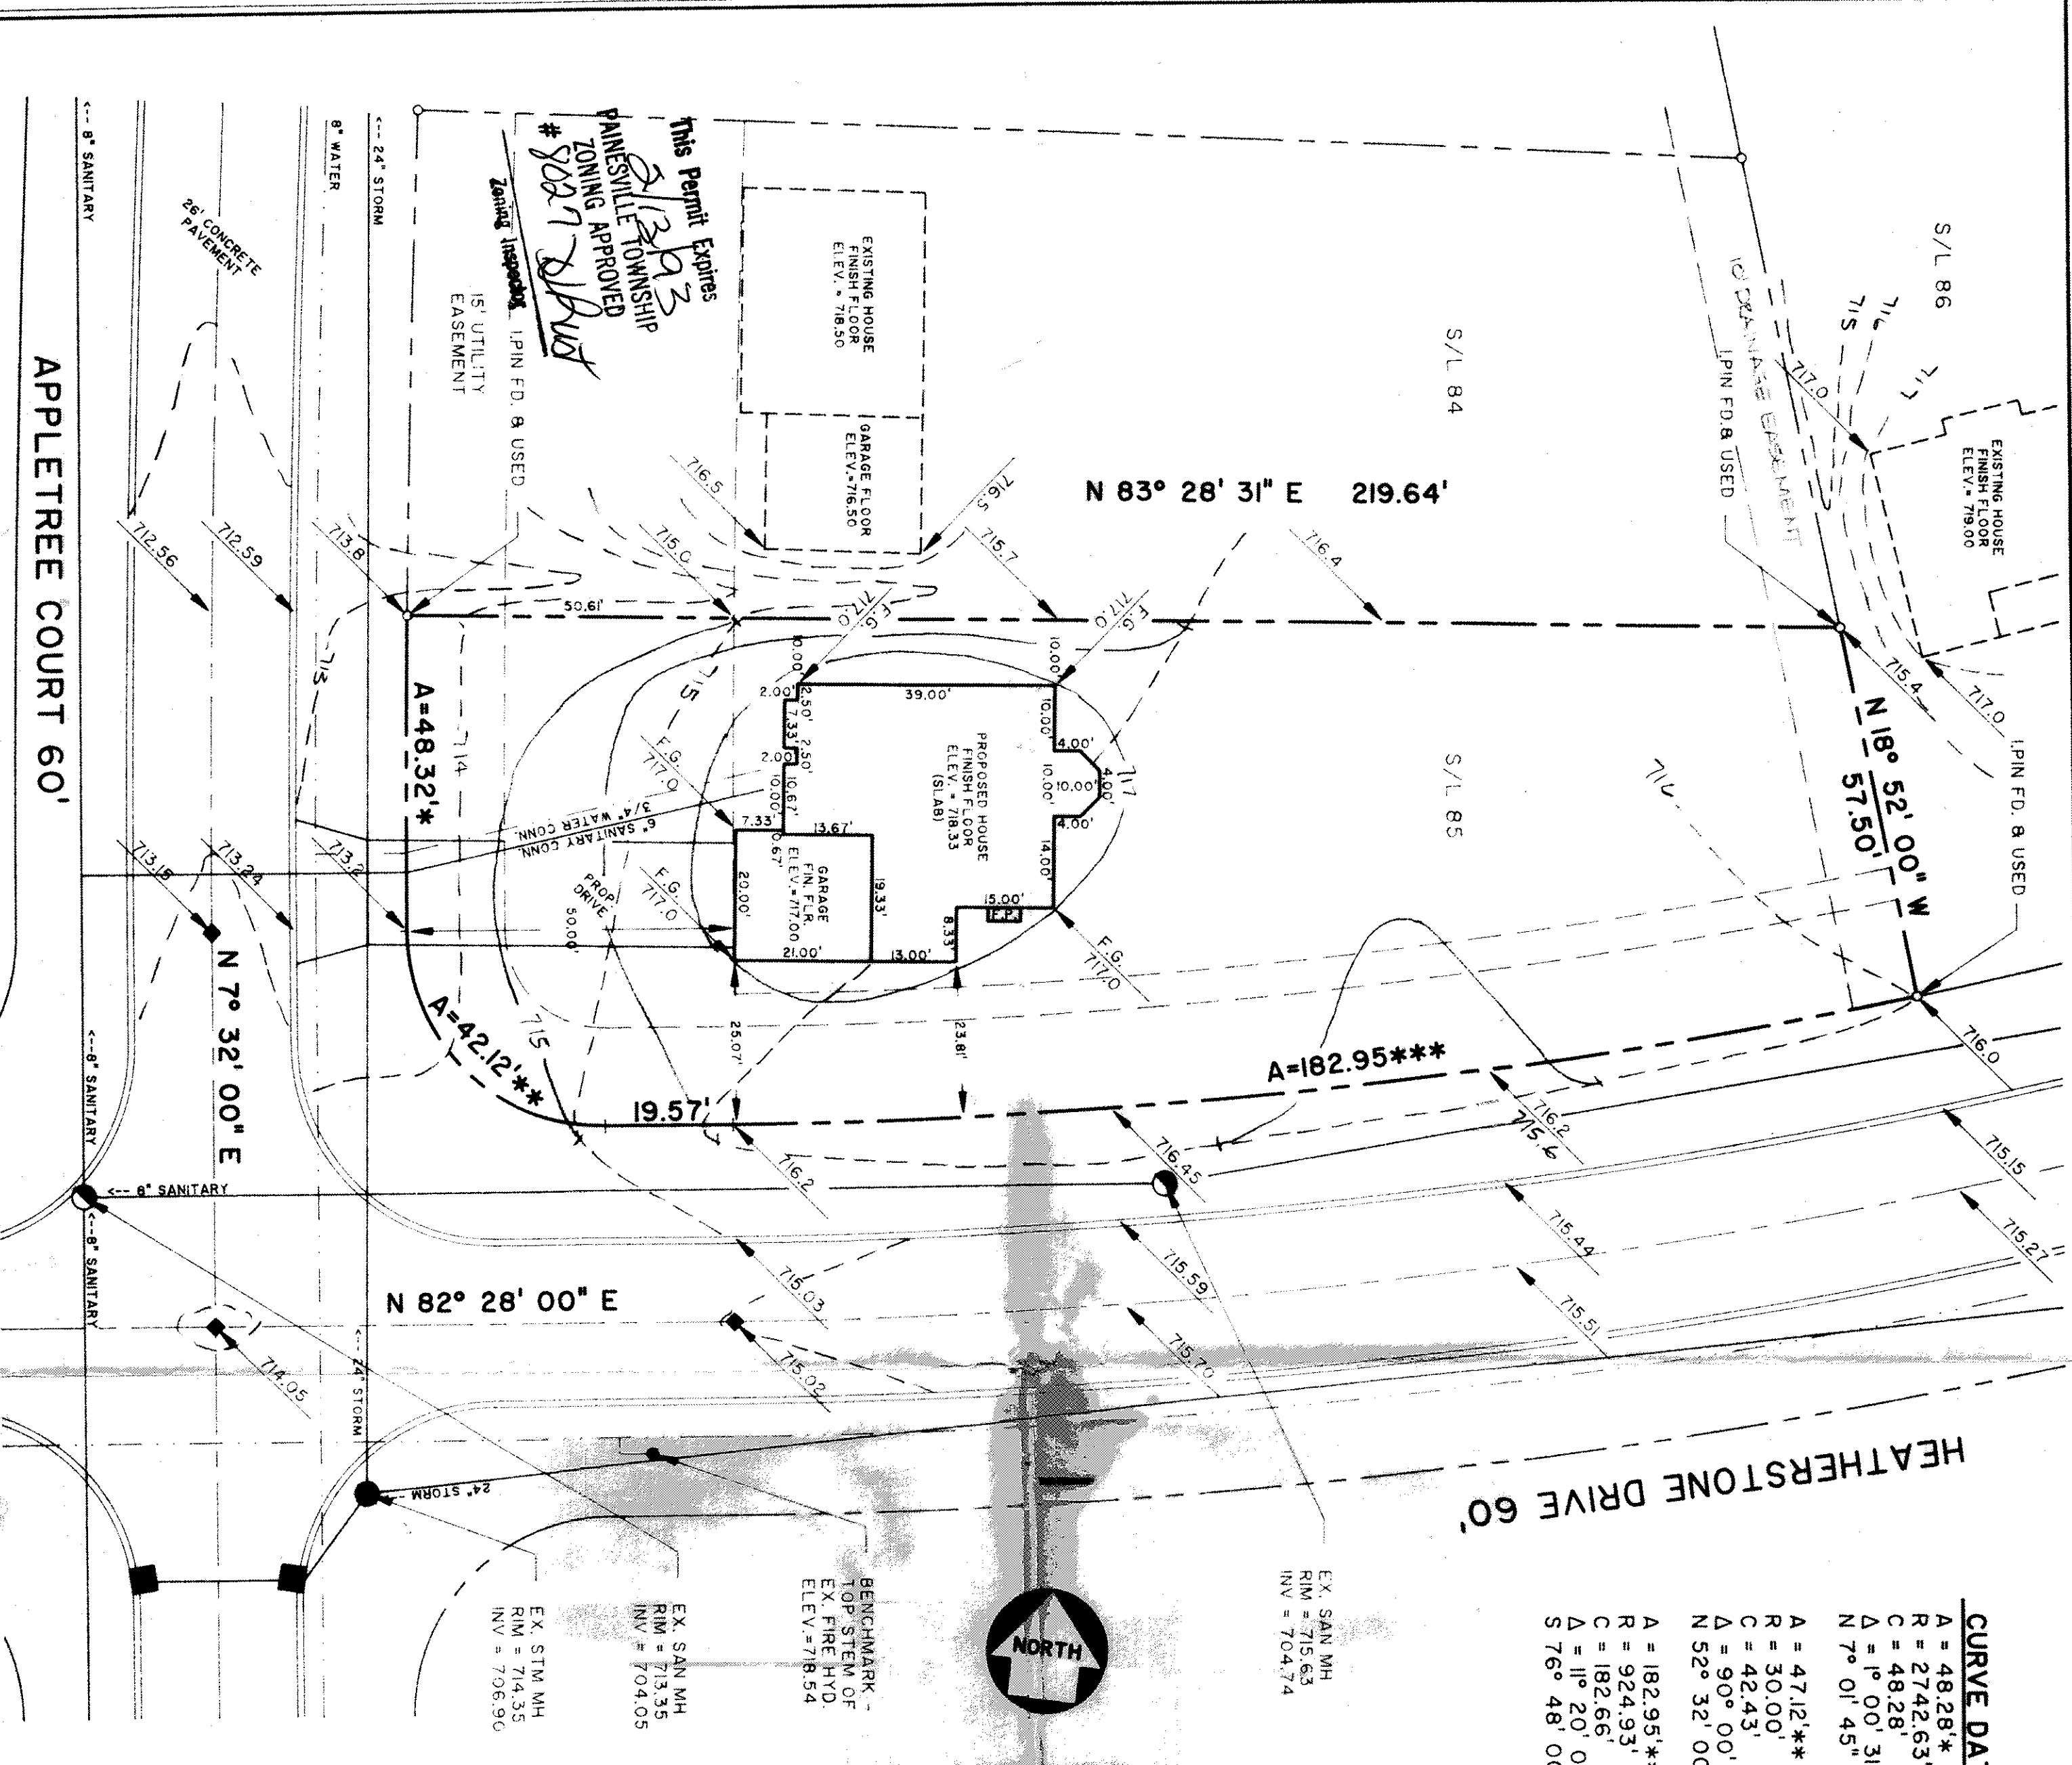

APPLETREE COURT 60'

91-010-085