

VILLAGE SURVEYING CO.
THOMAS M. COFFMAN, P.S.
202 THIRD STREET, FAIRPORT HARBOR, OHIO 44077
(216) 351-1359


BENCHMARK - 721.25
TOP BOLT HYDRANT

Grading Plan Approved
as shown and/or noted
THOMAS P. GILLES, P.E.
Lake County Engineer


By THP Date 2/16/87

SITE PLAN — FOR — R.C. REED CONSTRUCTION


BEING SUBLOT 115 OF THE HEATHERSTONE VILLAGE SUBD.
No. 1, SITUATED IN THE TOWNSHIP OF PAINESVILLE, COUNTY
OF LAKE, AND STATE OF OHIO.

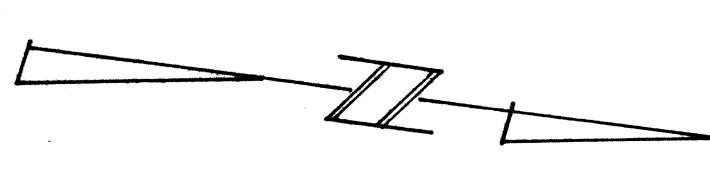

SCALE: 1" = 20'

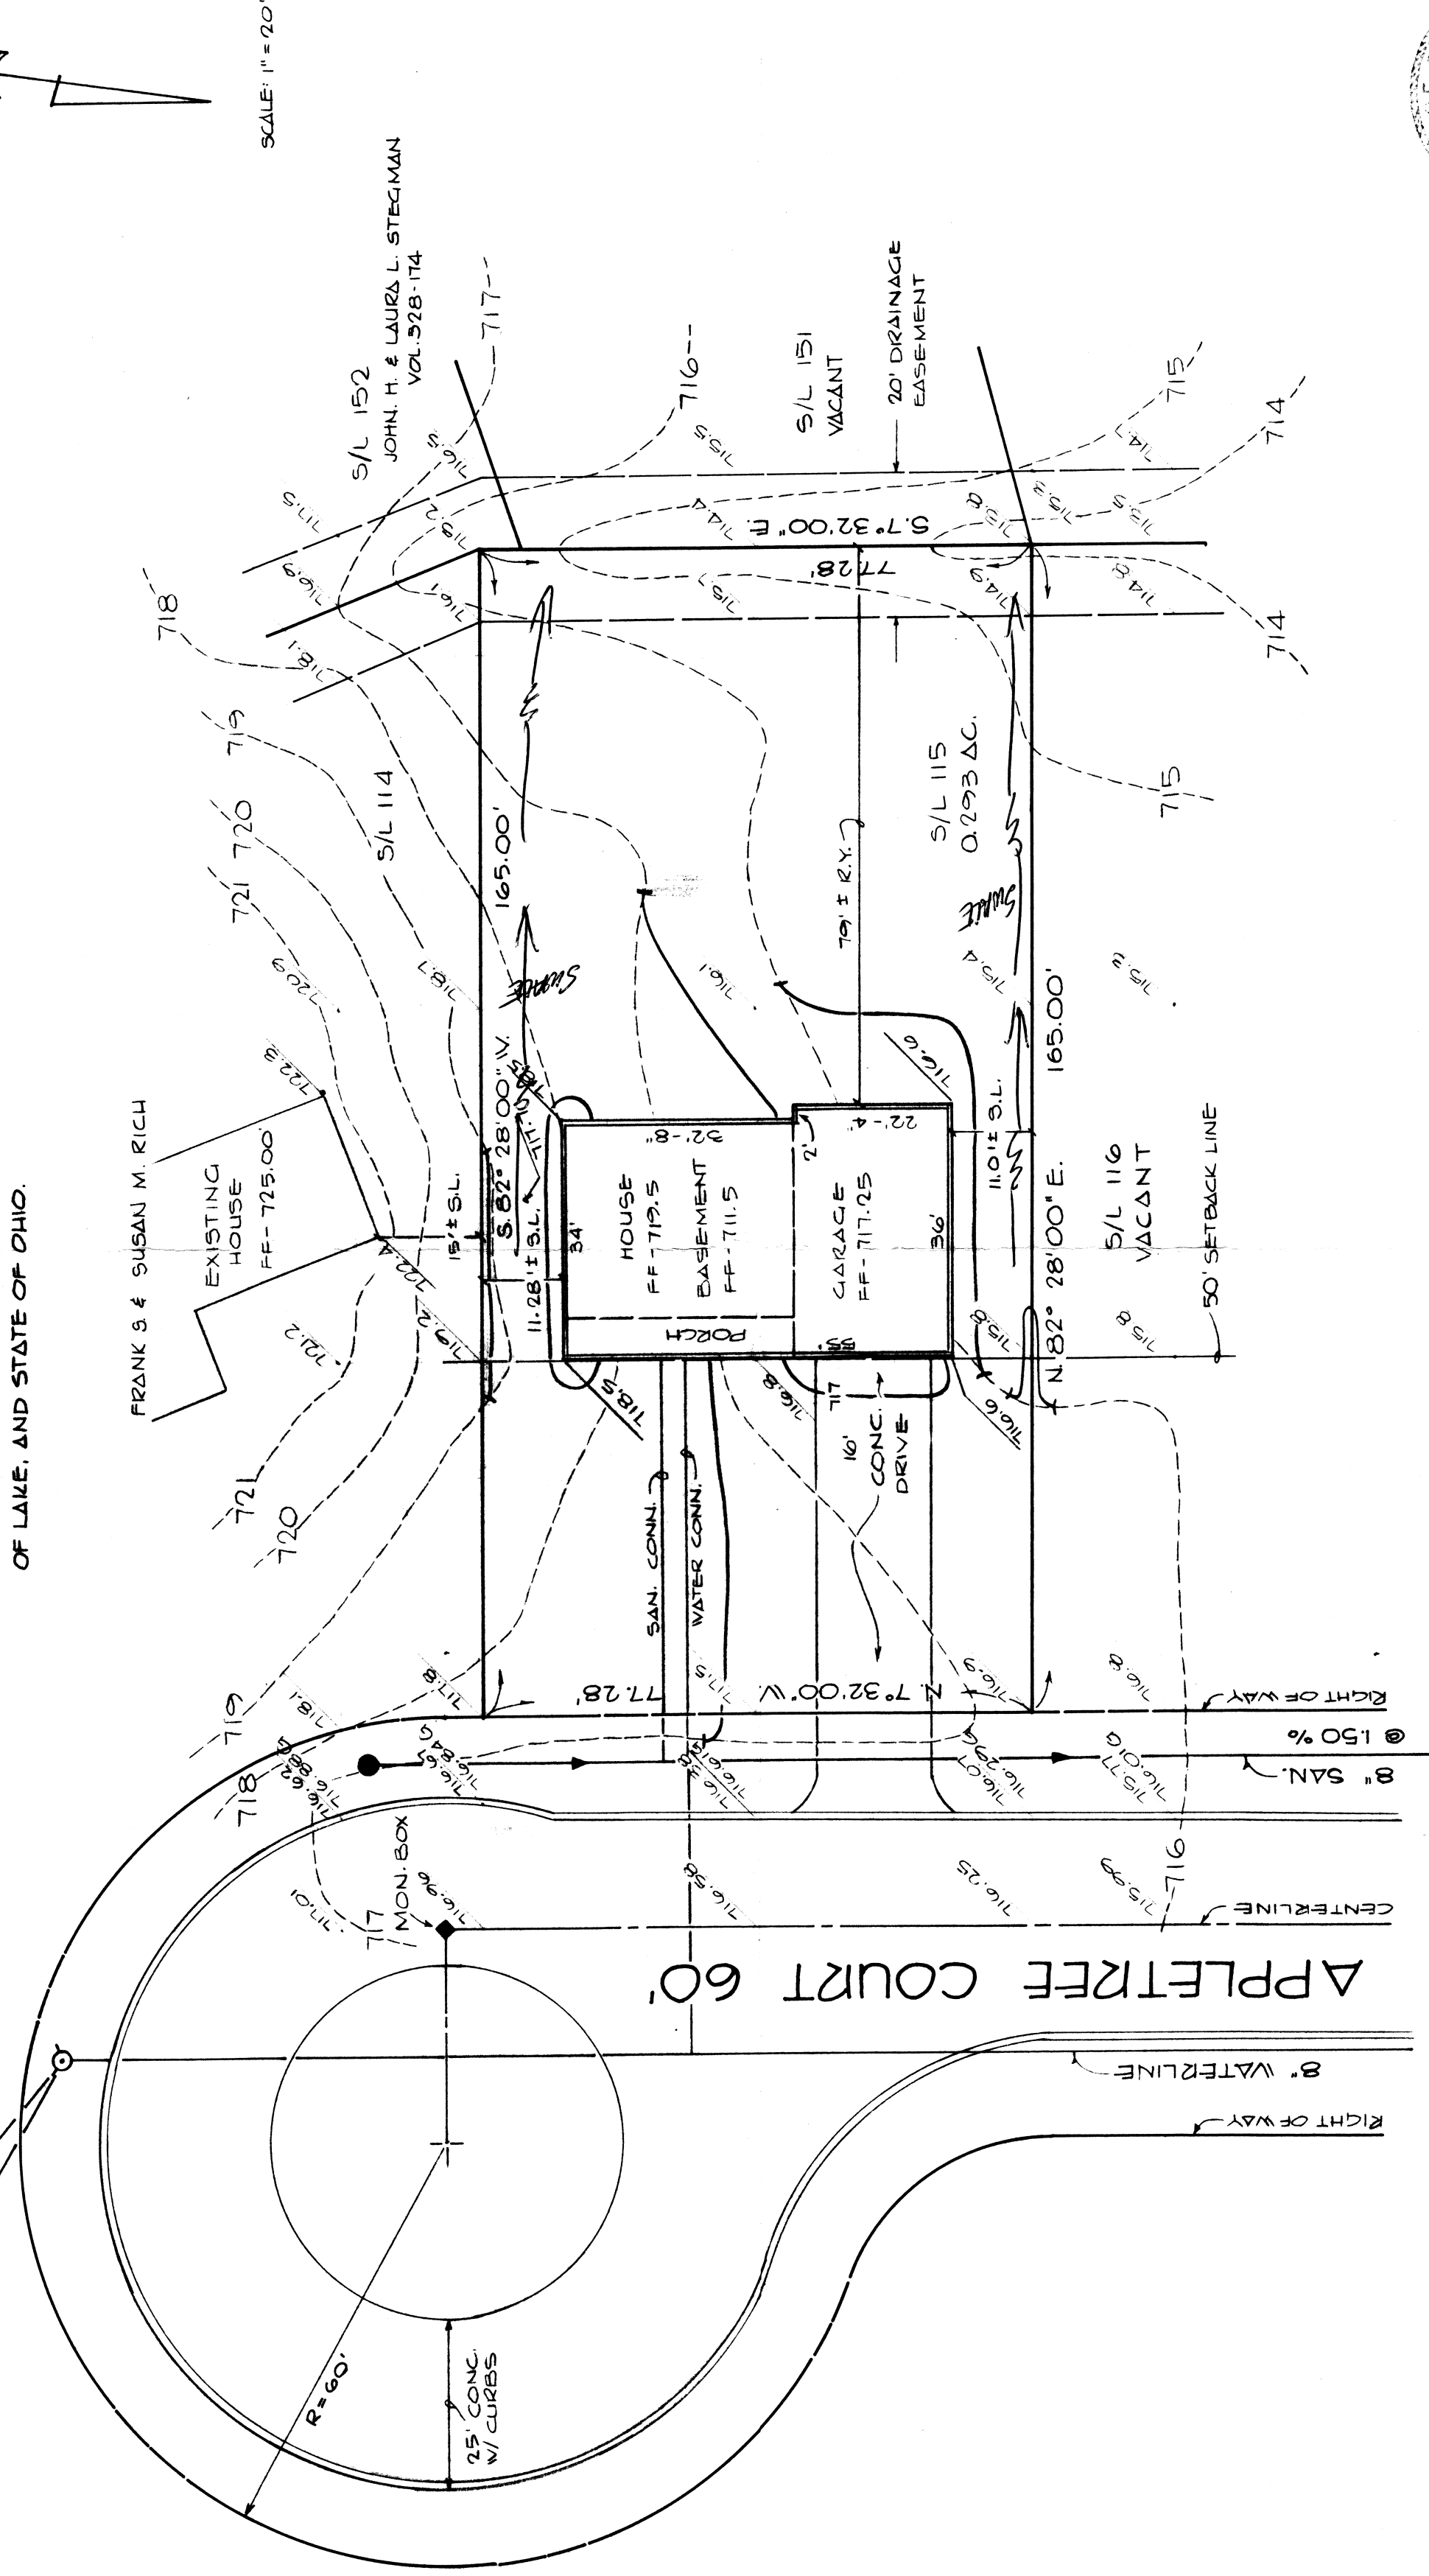

This Permit Expires
12-11-88
PAINESVILLE TOWNSHIP
ZONING APPROVED
6848
William E. McManus
Zoning Inspector 2/11/87

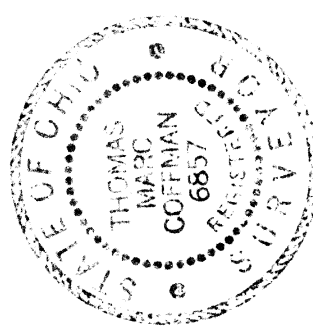

THIS PLAT WAS PREPARED BY ME AND IS
TRUE AND ACCURATE TO THE BEST OF MY
KNOWLEDGE AND BELIEF.

Thomas M. Coffman, P.S.
THOMAS M. COFFMAN NO. 6857