


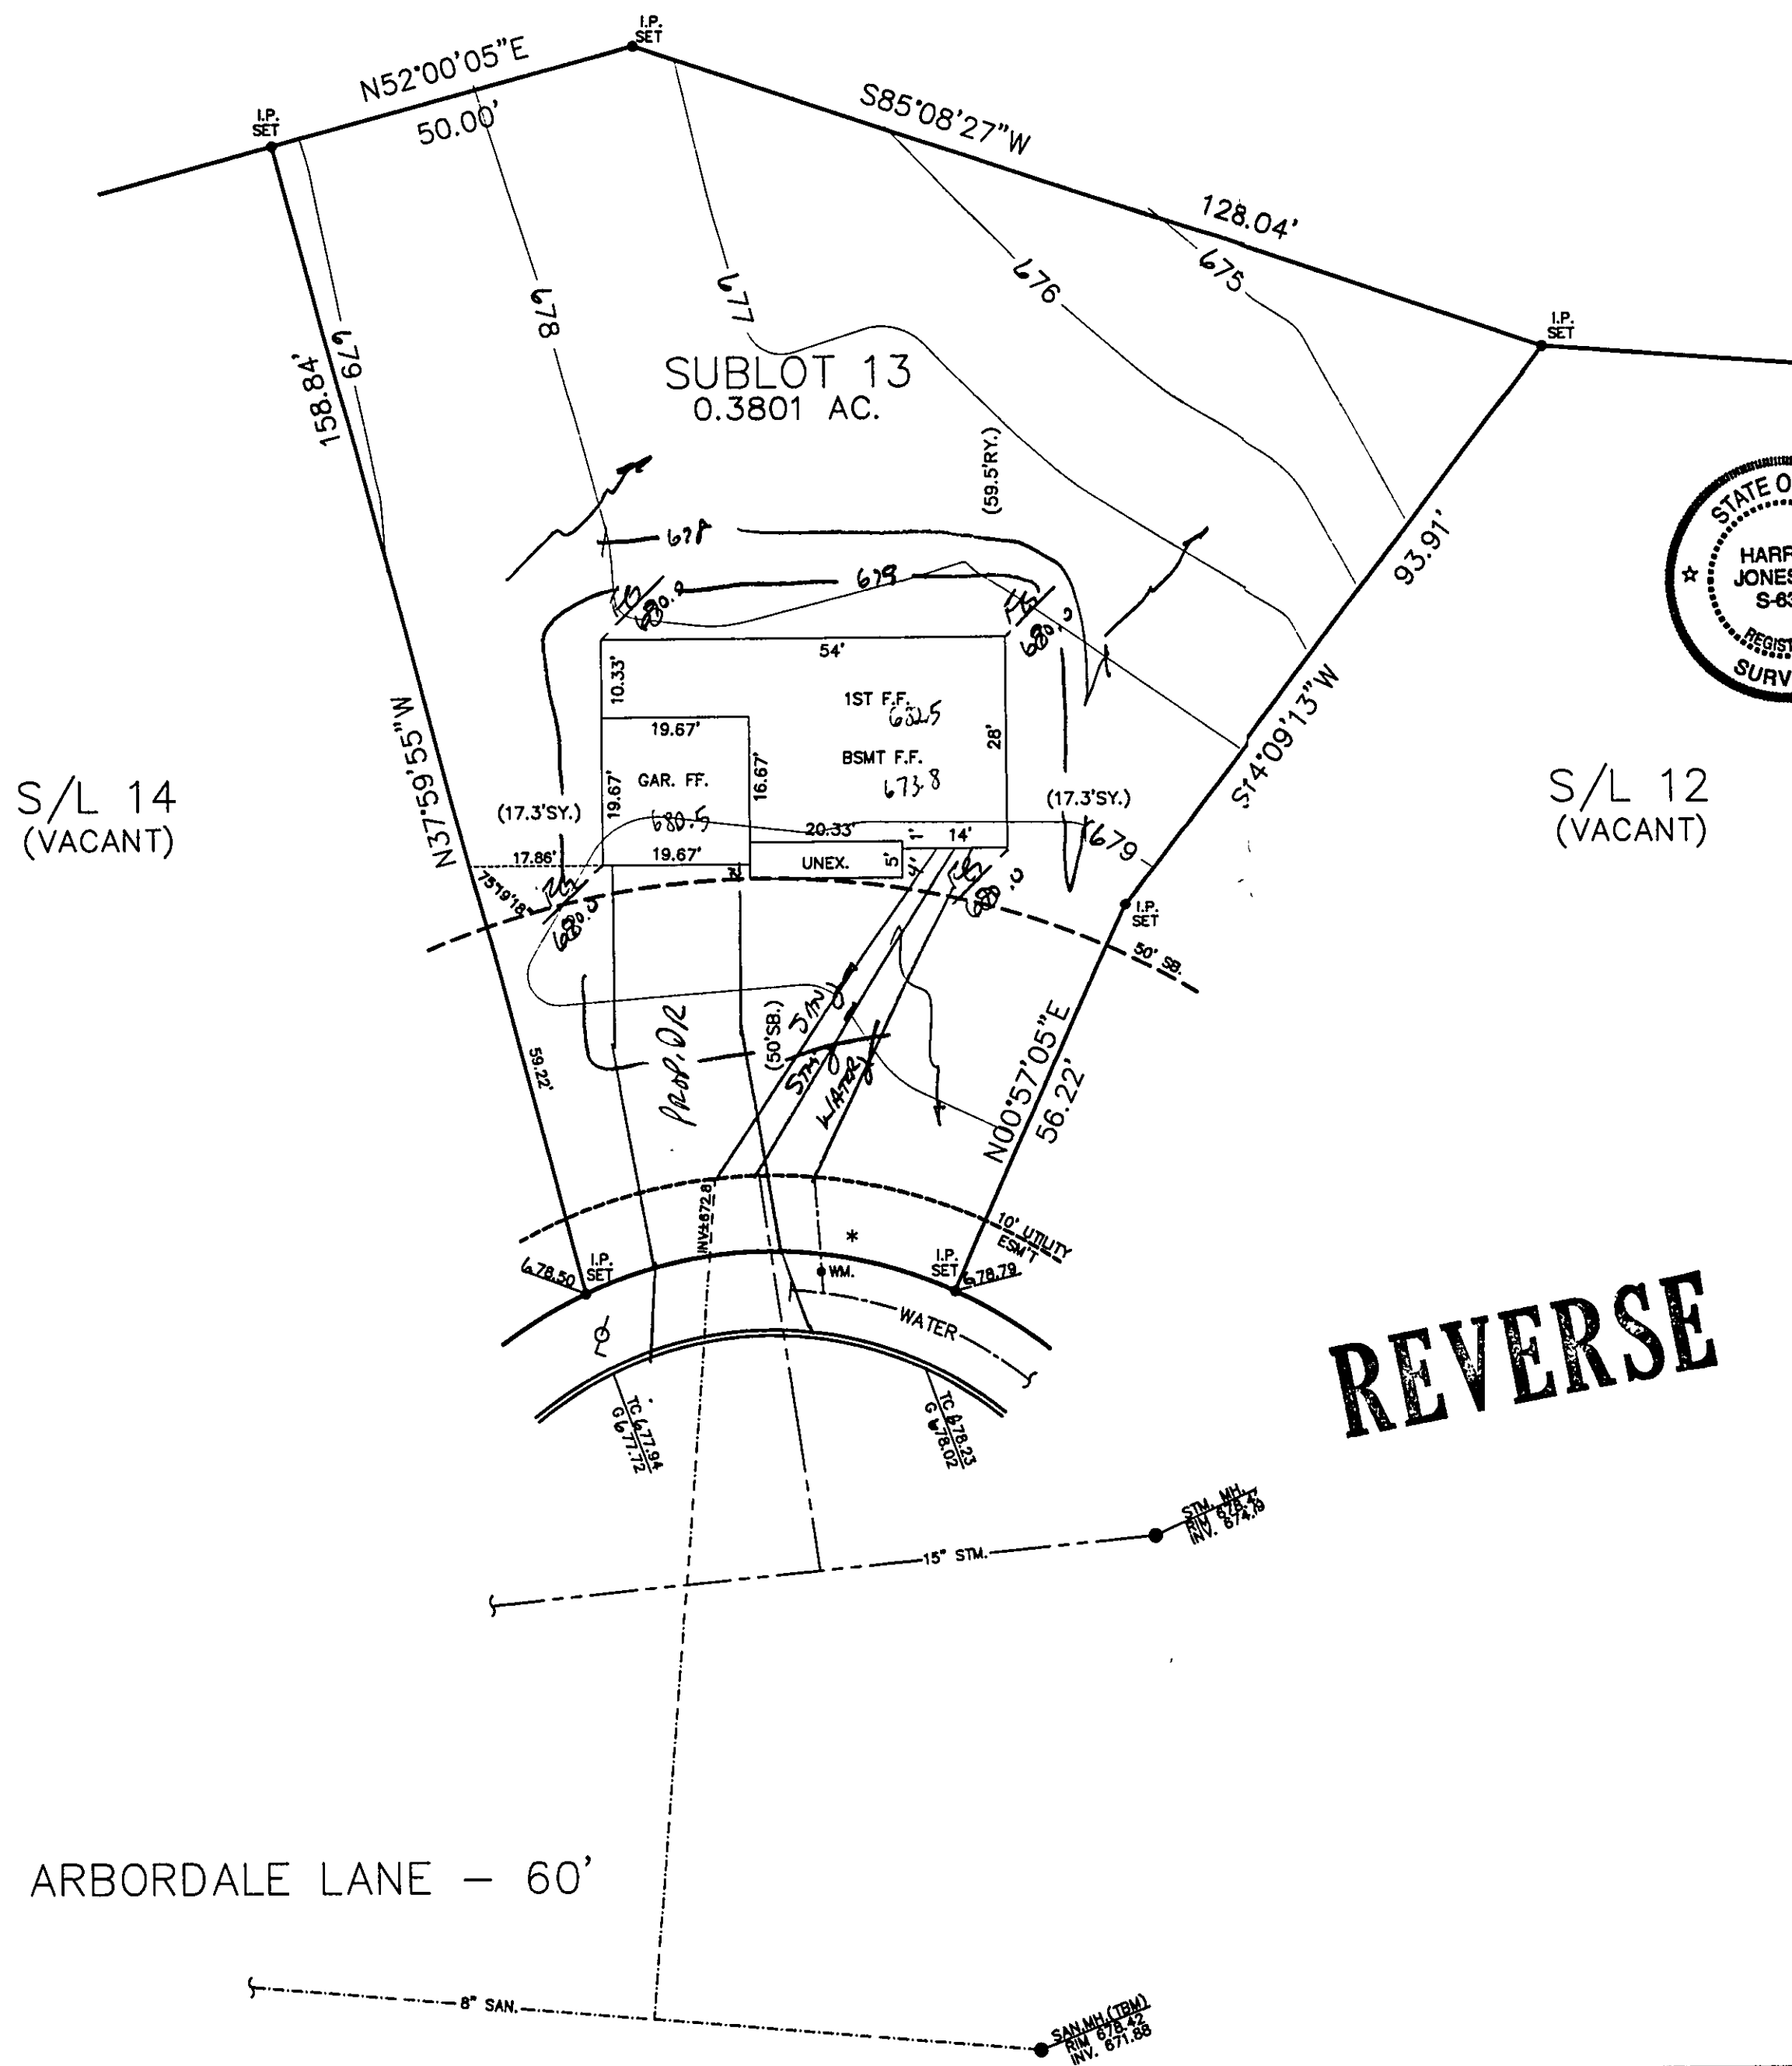

SITE PLAN

PAINESVILLE TWP, LAKE COUNTY, OHIO

for: KAY HOMES

CLIENT

OWNER

ADDRESS

STREET

CITY

ZIP

BRIARWOOD FARMS SUBDIVISION

SUBDIVISION

NAME

LOT

TRACT

13

29-22

ARBORDALE LANE

VOLUME

PAGE

SUBLOT NO.

STREET

PERM. PARCEL NO.

STREET

LEGEND

SANITARY MANHOLE

STORM MANHOLE

INLET OR CATCH BASIN

HYDRANT

EXISTING CONTOURS

PROPOSED CONTOURS

EXIST. ELEV. 100.0

100.0

PROP. ELEV.

AS BUILT ELEVATION

INDICATES DIRECTION OF SURFACE DRAINAGE

REMARKS

ALL BOUNDARY DATA SHOWN WAS OBTAINED FROM (DEEDS, RECORDED SUBDIVISION PLAT OR OTHER PUBLIC RECORDS)

LOCATIONS AS SHOWN OF ADJACENT WELLS AND SEPTIC TANKS OBTAINED FROM LAKE COUNTY HEALTH DEPARTMENT

DESIGN CERTIFICATION

THIS PLAT WAS PREPARED BY ME, AND IS CORRECT TO THE BEST OF MY KNOWLEDGE AND BELIEF.

NAME

SURVEYOR

REGISTRATION NO.

CHECK LIST

NO. OF BEDROOMS

DIMENSIONS

BEARINGS

TIE TO NEAREST STREET

SUBLOT NO. PARCEL NO.

SURROUNDING OWNERS

BLDG. DIMENSIONS FIN GR.

BLDG. TIES FL'R. GRADES

APRON TYPE WIDTH THICKNESS

SEWAGE TANK LOCATION & DUPLICATION AREA

WELL LOCATION

ISOLATION RADIUS FROM WELL

WATER MAIN SIZE, LOCATION

SAN. SEWER SIZE & GR. LOC.

SAN. MH. CAST. ELEV. INV. ELEV.

SAN. CONN. SIZE, LOC. DEPTH

STORM SEWER SIZE & GR. LOC.

STORM MH. CAST. ELEV. INV. ELEV.

PAVT TYPE GRADE CURBS

GAS LINE LOC. SIZE PRESSURE

SEPTIC TANK LOCATION & DUPLICATION AREA

WELL LOCATION

ISOLATION RADIUS FROM WELL

REVISIONS

NO.

DATE

BY

1

2

3

4

5

PLAN PREPARED BY:

BABCOCK JONES & ASSOCIATES, INC.

PAINESVILLE, OHIO

DRAWN BY

SCALE

PHONE NO.

MS&TR

1"=20'

216-357-1811

CHK'D.

DATE

DRAWING NO.

H.J.

3/18/98

97-070-13

CREW CHIEF

APP'D

H.J.

"AS BUILT" CERTIFICATION
I, HEREBY CERTIFY THAT THE CIRCLED GRADES ARE EXISTING
FINISH GRADES CHECKED IN THE FIELD ON _____, 19____
AND ARE CORRECT TO THE BEST OF MY KNOWLEDGE AND BELIEF.

REGISTERED SURVEYOR
REG. NO.
TBM-SAN MH. RIM
ELEV. = 678.42
Grading Plan Approved
shown and/or
T. AS P. GILLES, P.E.
Lake County Engineer
By 6/H Date 3-31-98
garage will be on
west side