

# SITE PLAN

PAINESVILLE TWP., LAKE COUNTY, OHIO  
for: NAUGHTON BUILDING CO.

ADDRESS STREET CITY ZIP  
SUBDIVISION 28-22 NAME TRACT  
7 VOL-PG. ARBORDALE LN. LOT STREET  
SUBLOT NO. STREET VOL-PG. PERM. PARCEL NO.

## LEGEND

SANITARY MANHOLE --- EXIST. ELEV.  $\pm 100.0$  PROP. ELEV.  $\pm 100.0$   
STORM MANHOLE ---   
INLET OR CATCH BASIN ---   
HYDRANT ---   
EXISTING CONTOURS --- INDICATES  
PROPOSED CONTOURS --- DIRECTION OF SURFACE DRAINAGE

## REMARKS

ALL BOUNDARY DATA SHOWN WAS OBTAINED FROM (DEEDS, RECORDED SUBDIVISION PLAT OR OTHER PUBLIC RECORDS)

LOCATIONS AS SHOWN OF ADJACENT WELLS AND SEPTIC TANKS OBTAINED FROM LAKE COUNTY HEALTH DEPARTMENT

## DESIGN CERTIFICATION

THIS PLAT WAS PREPARED BY ME, AND IS CORRECT TO THE BEST OF MY KNOWLEDGE AND BELIEF.

NAME SURVIVOR REGISTRATION NO.

## CHECK LIST

NO. OF BEDROOMS  
DIMENSIONS  
BEARINGS  
TIE TO NEAREST STREET  
SUBLOT NO. PARCEL NO.  
SURROUNDING OWNERS  
BLDG. DIMENSIONS FIN GR.  
BLDG. TIES FL'R. GRADES  
APRON TYPE WIDTH THICKNESS  
SIDEWALK TYPE WIDTH THICKNESS  
CULVERT TYPE DIA., LENGTH  
ROCK OUTCROPPINGS

WATER MAIN SIZE, LOCATION  
SAN. SEWER SIZE & GR. LOC.  
SAN. MH. CAST. ELEV. INV. ELEV.  
SAN. CONN. SIZE, LOC. DEPTH  
STORM SEWER SIZE & GR. LOC.  
STORM MH. CAST. ELEV. INV. ELEV.  
PAV'T TYPE GRADE CURBS  
GAS LINE LOC. SIZE PRESSURE  
SEPTIC TANK LOCATION & DUPLICATION AREA  
WELL LOCATION  
ISOLATION RADIUS FROM WELL

REVISIONS			PLAN PREPARED BY:		
NO.	DATE	BY	BABCOCK JONES & ASSOCIATES, INC.		
1			PAINESVILLE, OHIO		
2			DRAWN BY T.R.	SCALE 1"=20'	PHONE NO. 440-357-1811
3			CHK'D. H.J.	DATE 9/28/98	DRAWING NO. 97-070-07
4			CREW CHIEF K.J.	APP'D H.J.	
5					

"AS BUILT" CERTIFICATION  
I, HEREBY CERTIFY THAT THE CIRCLED GRADES ARE EXISTING FINISH GRADES CHECKED IN THE FIELD ON 19\_\_\_\_, AND ARE CORRECT TO THE BEST OF MY KNOWLEDGE AND BELIEF.


REGISTERED SURVEYOR

REG. NO.

TBM-SANITARY MH.  
RIM=678.42

Grading Plan App.  
as shown and/or  
THOMAS P. GILLE  
Lake County Engineer




By GH Date 10-14-98

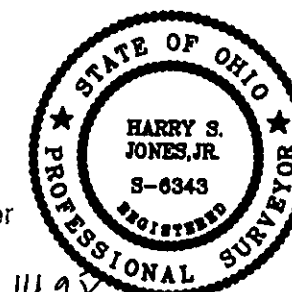

APPROVED  
PAINESVILLE TOWNSHIP  
ZONING DEPARTMENT  
19980296  
DPR

C7A: R=130.00'  
L=71.50'  
T=36.68'  
C=70.60'  
N78°21'21"E  
D=31°30'47"

C7B: R=30.00'  
L=3.50'  
T=1.75'  
C=3.50'  
N65°56'28"E  
D=06°41'00"

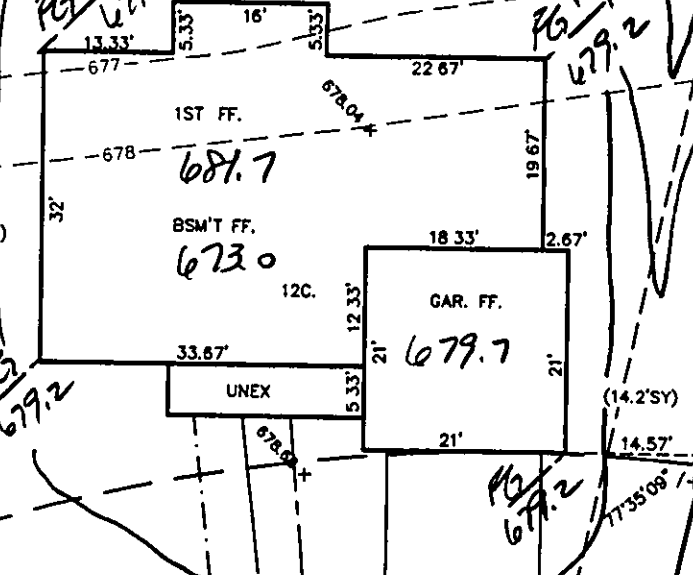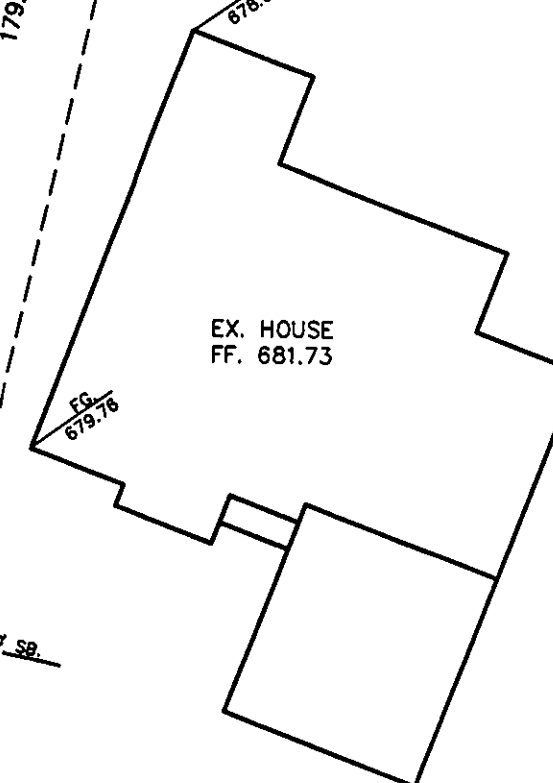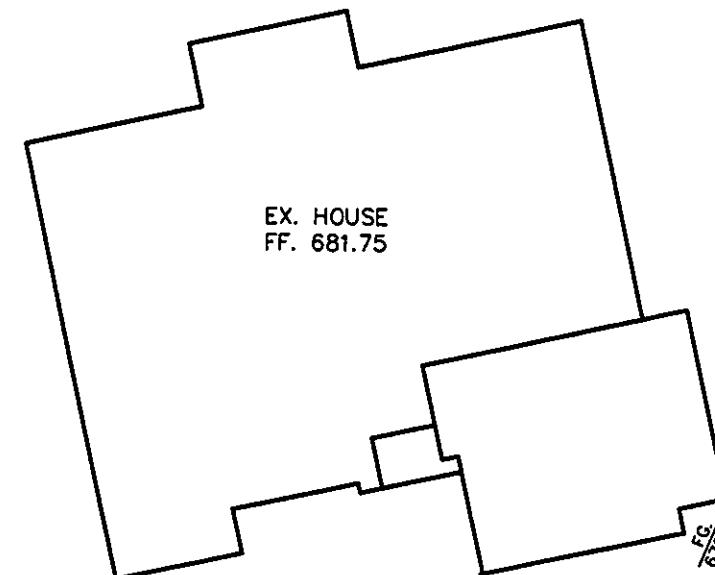

SAN. MH. (TBM)  
RIM 678.42  
INV. 671.88

STM. MH.  
RIM 678.70  
INV. 674.09

ARBORDALE LANE - 60'