

SITE PLAN

LAKE COUNTY, OHIO

for: **John J. Lampinen**
OWNER
159 Paradise Rd., Painesville, OH 44060
ADDRESS CITY ZIP

Project: **Lampinen Sewer Plant**
SUBDIVISION: **2-50**
SHEET NO.: **1**
VOLUME: **1**
NAME: **John J. Lampinen**
STREET: **Paradise Rd.**

LEGEND

SANITARY MANHOLE ---
STORM MANHOLE ---
INLET OR CATCH BASIN ---
HYDRANT ---
EXISTING CONTOURS ---
PROPOSED CONTOURS ---
EXIST. ELEV. ---
PROP. ELEV. ---

REMARKS

ALL BOUNDARY DATA SHOWN WAS OBTAINED FROM (DEEDS, RECORDED SUBDIVISION PLAT OR OTHER PUBLIC RECORDS)
LOCATIONS AS SHOWN OF ADJACENT WELLS AND SEPTIC TANKS OBTAINED FROM LAKE COUNTY HEALTH DEPARTMENT

DESIGN CERTIFICATION

THIS PLAT WAS PREPARED BY ME, AND IS CORRECT TO THE BEST OF MY KNOWLEDGE AND BELIEF.
NAME: **William C. Babcock**
SURVEYOR REGISTRATION NO.: **6521**

CHECK LIST

NO. OF BEDROOMS
DIMENSIONS
SEWERS
TIE TO NEAREST STREET
SUBDIVISION PLAT NO.
ALSO, TIES TO GRADES
ARROW TYPE WITH THICKNESS
SEPTIC TANK LOCATION & DUCTILE IRON AREA
ISOLATION RADIUS FROM WELL

PLAN PREPARED BY:


BABCOCK & JONES & ASSOCIATES, INC.
270 MAIN ST. SUITE #20 PAINESVILLE, OHIO 44060

NO.	DATE	BY
1	3/1/82	W.C.
2		
3		
4		
5		

"AS BUILT" CERTIFICATION
I, HEREBY CERTIFY THAT THE CIRCLED GRADES ARE EXISTING FINISH GRADES CHECKED IN THE FIELD ON 1982 AND ARE CORRECT TO THE BEST OF MY KNOWLEDGE AND BELIEF.

REGISTERED SURVEYOR REG. NO. 6357

THIS PERMIT EXPIRES
MAR 31 1987
PAINESVILLE TOWNSHIP
ZONING APPROVED
6357
Zoning Inspector 4/1/86

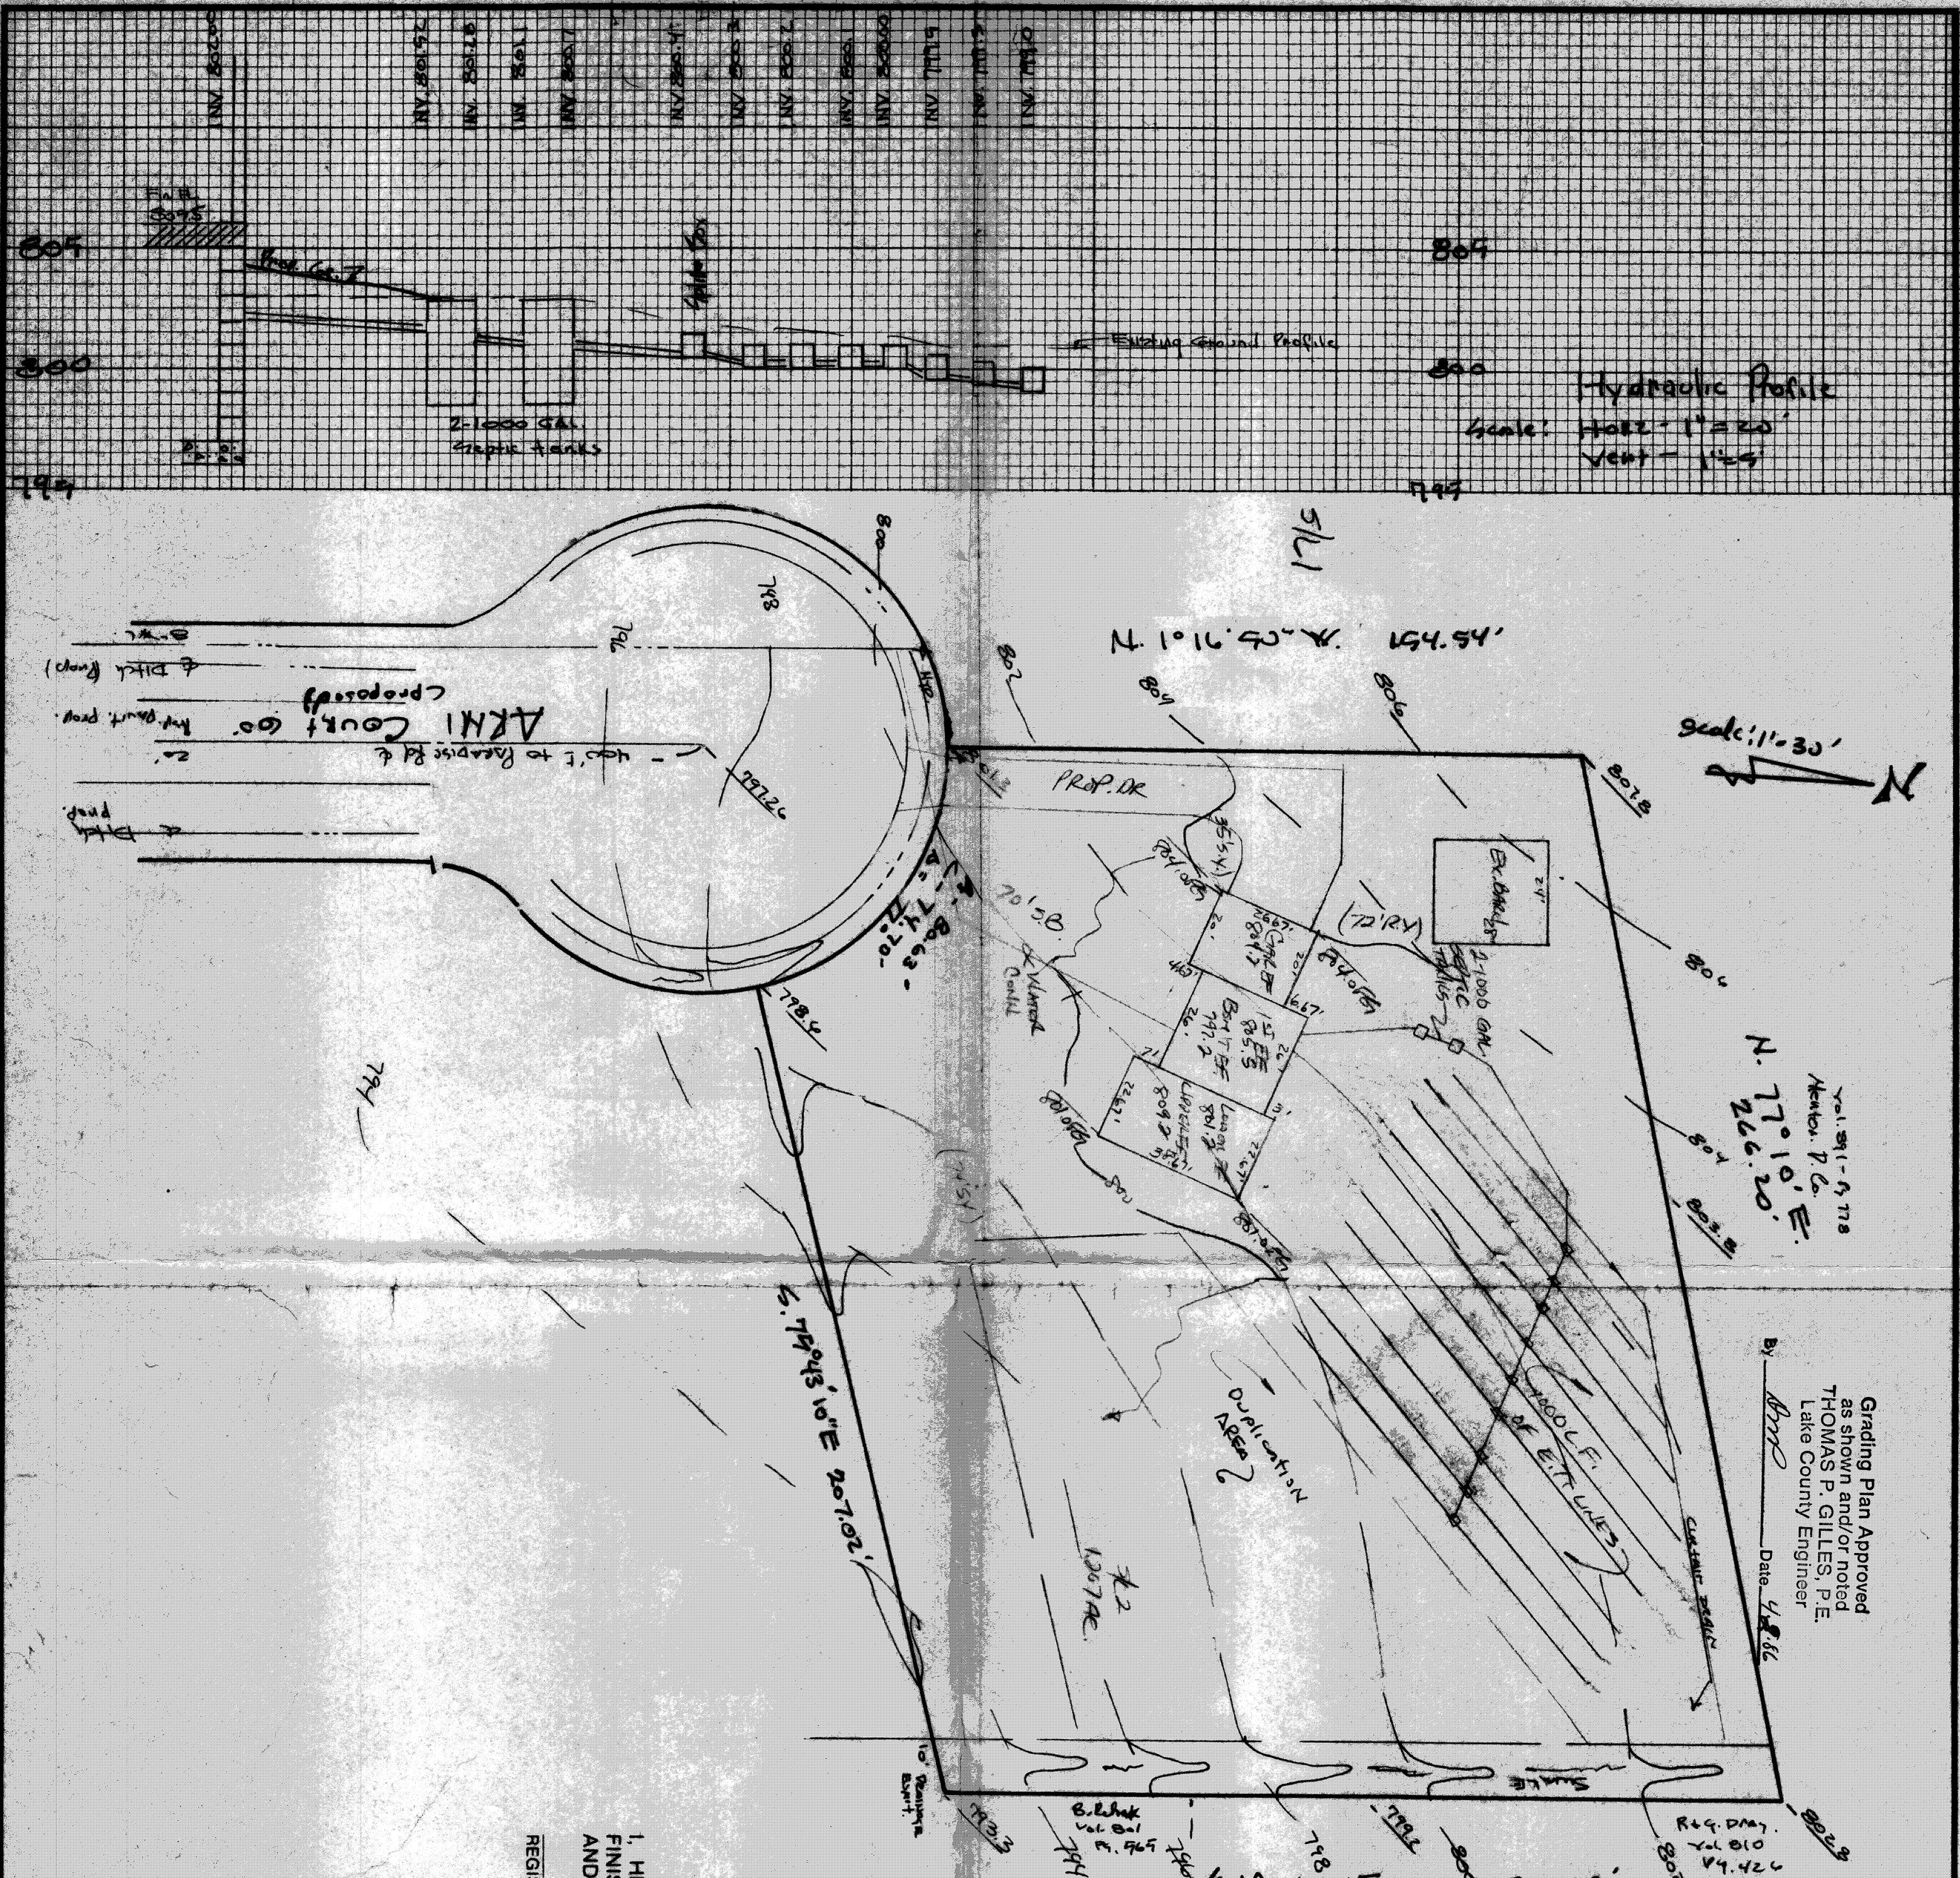

80.82-018-162