

BENCH MARK: P.K. NAIL IN UTILITY
POLE #592119 ELEV. 643.73

S/L 3

This Permit Expires

MAY 1 1980

PAINESVILLE TOWNSHIP


ZONING APPROVED

#4760

R.M. Haul

Zoning Inspector

1/2/79

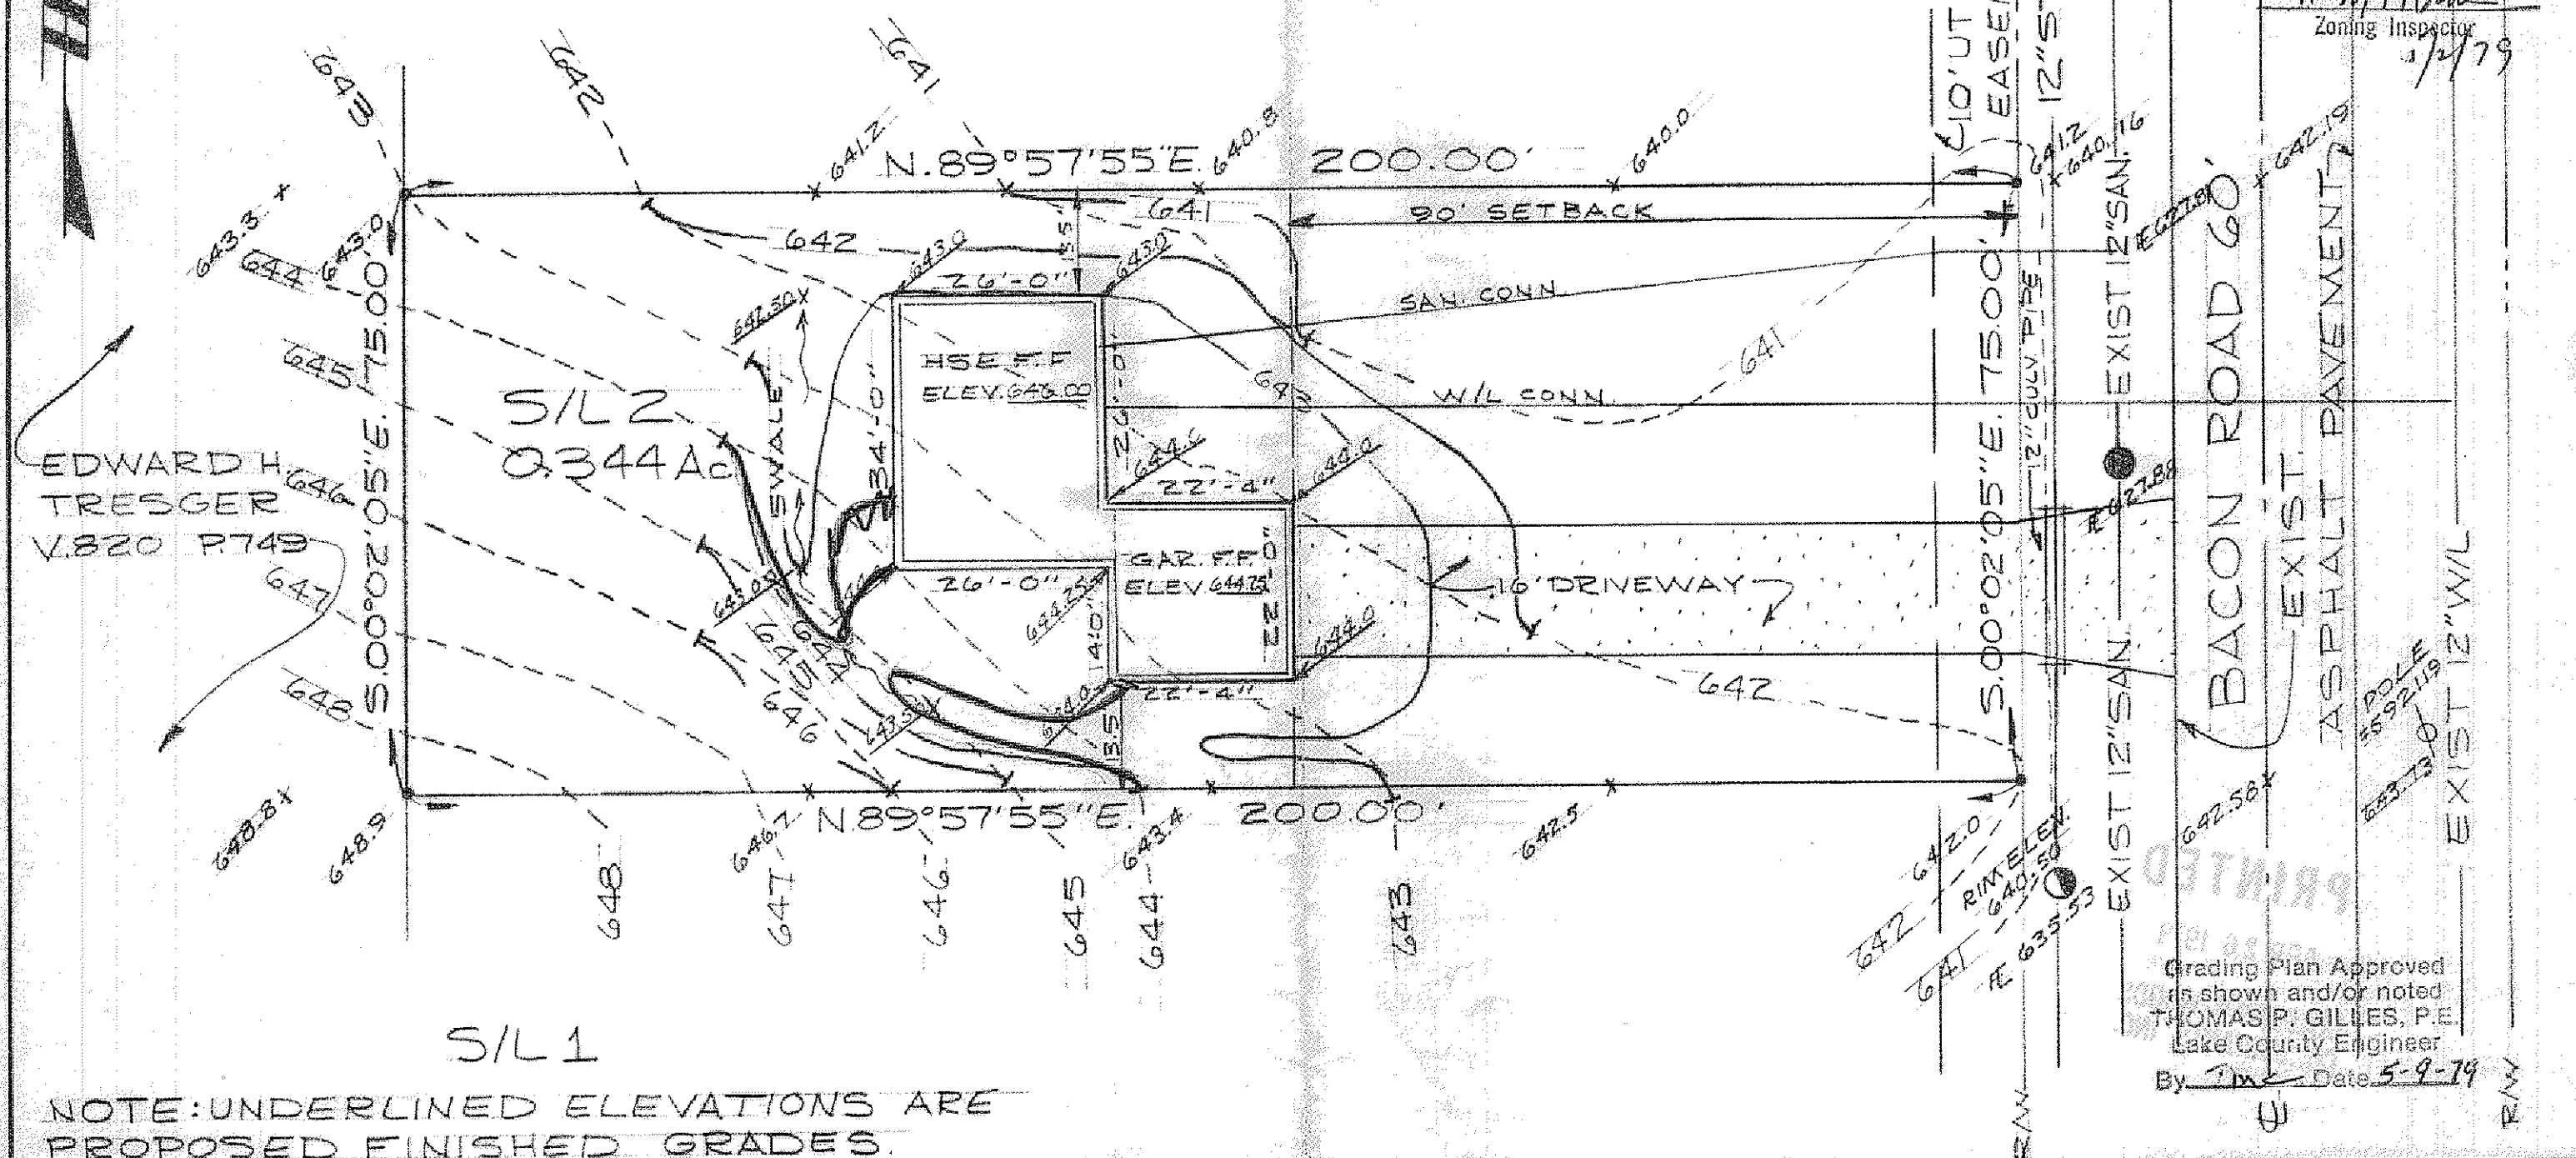

DESIGN CERTIFICATION

THIS PLAT WAS PREPARED BY ME,
AND IS CORRECT TO THE BEST OF
MY KNOWLEDGE AND BELIEF.

Eli J. Jelinek
4785

REG. SURVEYOR NO.

AS BUILT CERTIFICATION

I HEREBY CERTIFY THAT THE CIRCLED GRADES
ARE EXISTING FINISH GRADES CHECKED IN THE
FIELD ON _____ AND THAT
SURVEY IS CORRECT TO THE BEST OF MY
KNOWLEDGE AND BELIEF.

REG. SURVEYOR NO.



COLPETZER WOODS
CONSULTANTS, INC.

180 SOUTH STATE STREET • PAINESVILLE, OHIO 44077 • (216) 357-7569

DATE 4/23/79

SCALE 1"=20'

DRWN BY J.E.

CHKD BY _____

JOB NO. 78-156

FB _____ PG _____

SITE PLAN FOR
EDWARD H. TRESGER INC.
8100 DEEPWOOD BLVD. MENTOR
OHIO. S/L NO. 2 IN THE PINES
SUBD NO. 1 PAINESVILLE, OHIO