


BENCH MARK: P.K.
NAIL IN POLE N.E. COR.
BOWHALL & MADISON
AVE. ELEV. 695.27

S/L 21

S/L 25

10' UTILITY
EASEMENT

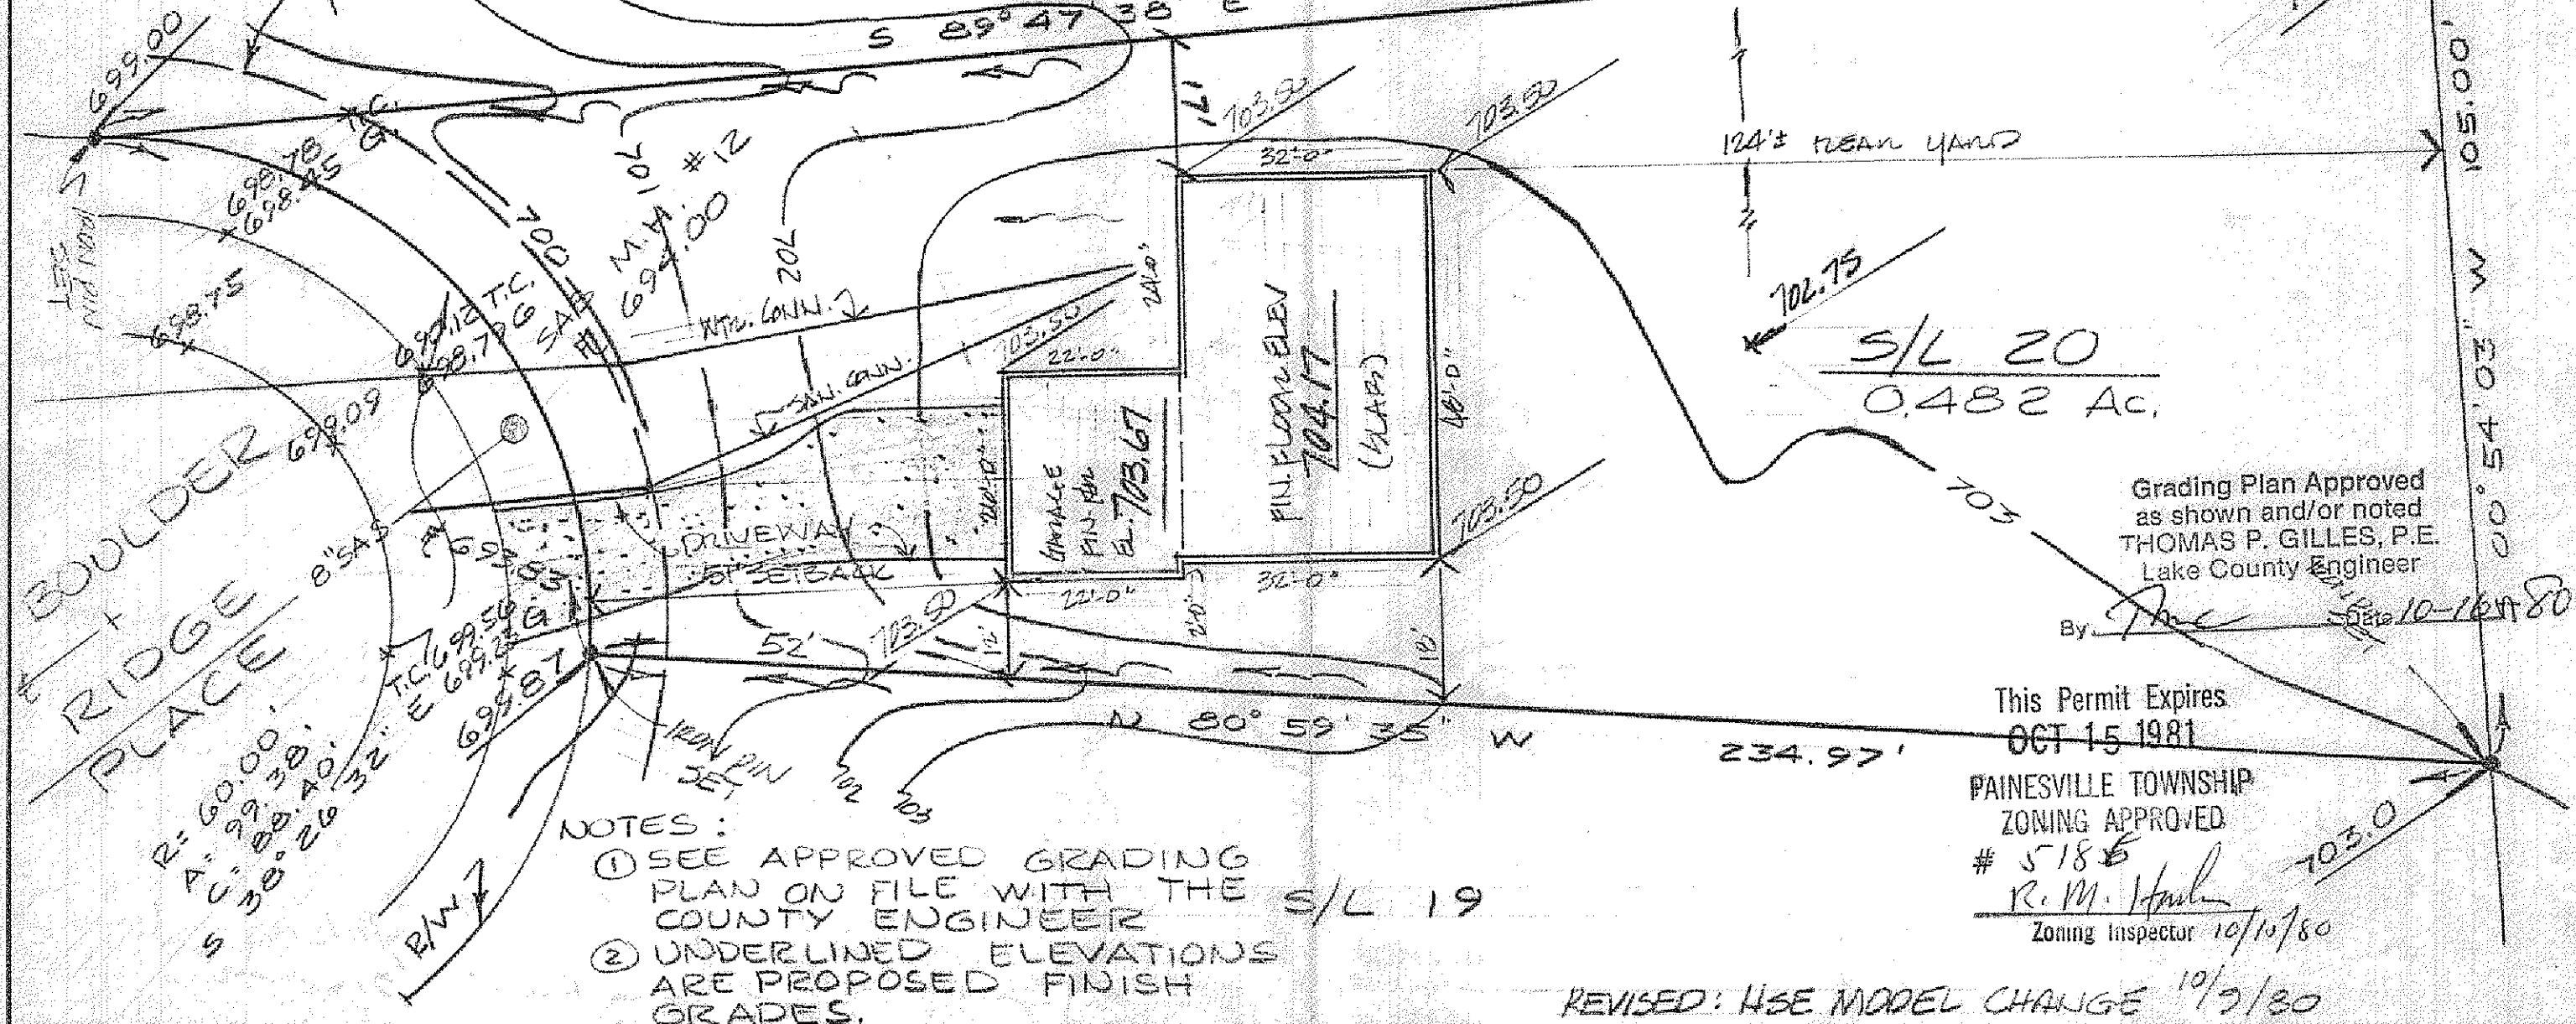

Grading Plan Approved
as shown and/or noted
THOMAS P. GILLES, P.E.
Lake County Engineer

By *Thomas P. Gilles* Date *10-16-80*

This Permit Expires
OCT 15 1981

PAINESVILLE TOWNSHIP
ZONING APPROVED
5186

R. M. Hurl
Zoning Inspector 10/10/80

REVISED: USE MODEL CHANGE 10/9/80

DESIGN CERTIFICATION

THIS PLAT WAS PREPARED BY ME,
AND IS CORRECT TO THE BEST OF
MY KNOWLEDGE AND BELIEF.

Glenn P. Hurl

REG. SURVEYOR NO. 4285

AS BUILT CERTIFICATION

I HEREBY CERTIFY THAT THE CIRCLED GRADES
ARE EXISTING FINISH GRADES CHECKED IN THE
FIELD ON _____ AND THAT
SURVEY IS CORRECT TO THE BEST OF MY
KNOWLEDGE AND BELIEF.

REG. SURVEYOR NO. _____



COLPETZER WOODS
CONSULTANTS, INC.

180 SOUTH STATE STREET • PAINESVILLE, OHIO 44077 • (216) 357-7569

DATE JAN. 79

SCALE 1"=20'

DRWN BY *EC*

CHKD BY *E*

JOB NO. 78-282

FB 321 PG 22

SITE PLAN FOR:

CASEMENT HOMES

1251 MADISON AVE. PAINESVILLE, OHIO
SUBLOT 20 BOULDER RIDGE SUBD.
PAINESVILLE TWP., LA. CO., OHIO