

Grading Plan Approved
shown and/or not
THOMAS P. GILLES,
Lake County Engineer

By THM Date 3/24/99
swale as shown
Lower F.G.

**ROOF DRAINS
SHALL DISCHARGE
TO SPLASH BLOCKS.**

GENERAL NOTES:

1. DRIVEWAY APRON TO BE 6" THICK
2. BENCHMARK - TOP STEM OF FIRE HYDRANT LOCATED IN FRONT OF SUBLOT No. 2, ELEV. = 694.73

LEGEND

- EXISTING CONTOUR
--- PROPOSED CONTOUR
- 100.00
100.00
--- EXISTING ELEVATION
--- PROPOSED ELEVATION



CERTIFICATION

"I THE UNDERSIGNED HEREBY CERTIFY THAT THIS TOPOGRAPHY INDICATED BY 'I' CONTOURS AND ELEVATIONS SHOWN HEREON REPRESENTS AN ACTUAL SURVEY MADE BY ME ON THE 17th DAY OF MARCH, 1999 AND THE ELEVATIONS WERE TAKEN AT APPROPRIATE INTERVALS AND AS OF THAT DAY THEY EXISTED AS INDICATED HEREON.

"I HEREBY CERTIFY THAT THIS PLAN WAS PREPARED BY ME AND IS CORRECT TO THE BEST OF MY KNOWLEDGE"


David W. Novak
DAVID W. NOVAK, P.S. No. 7507

GRAPHIC SCALE

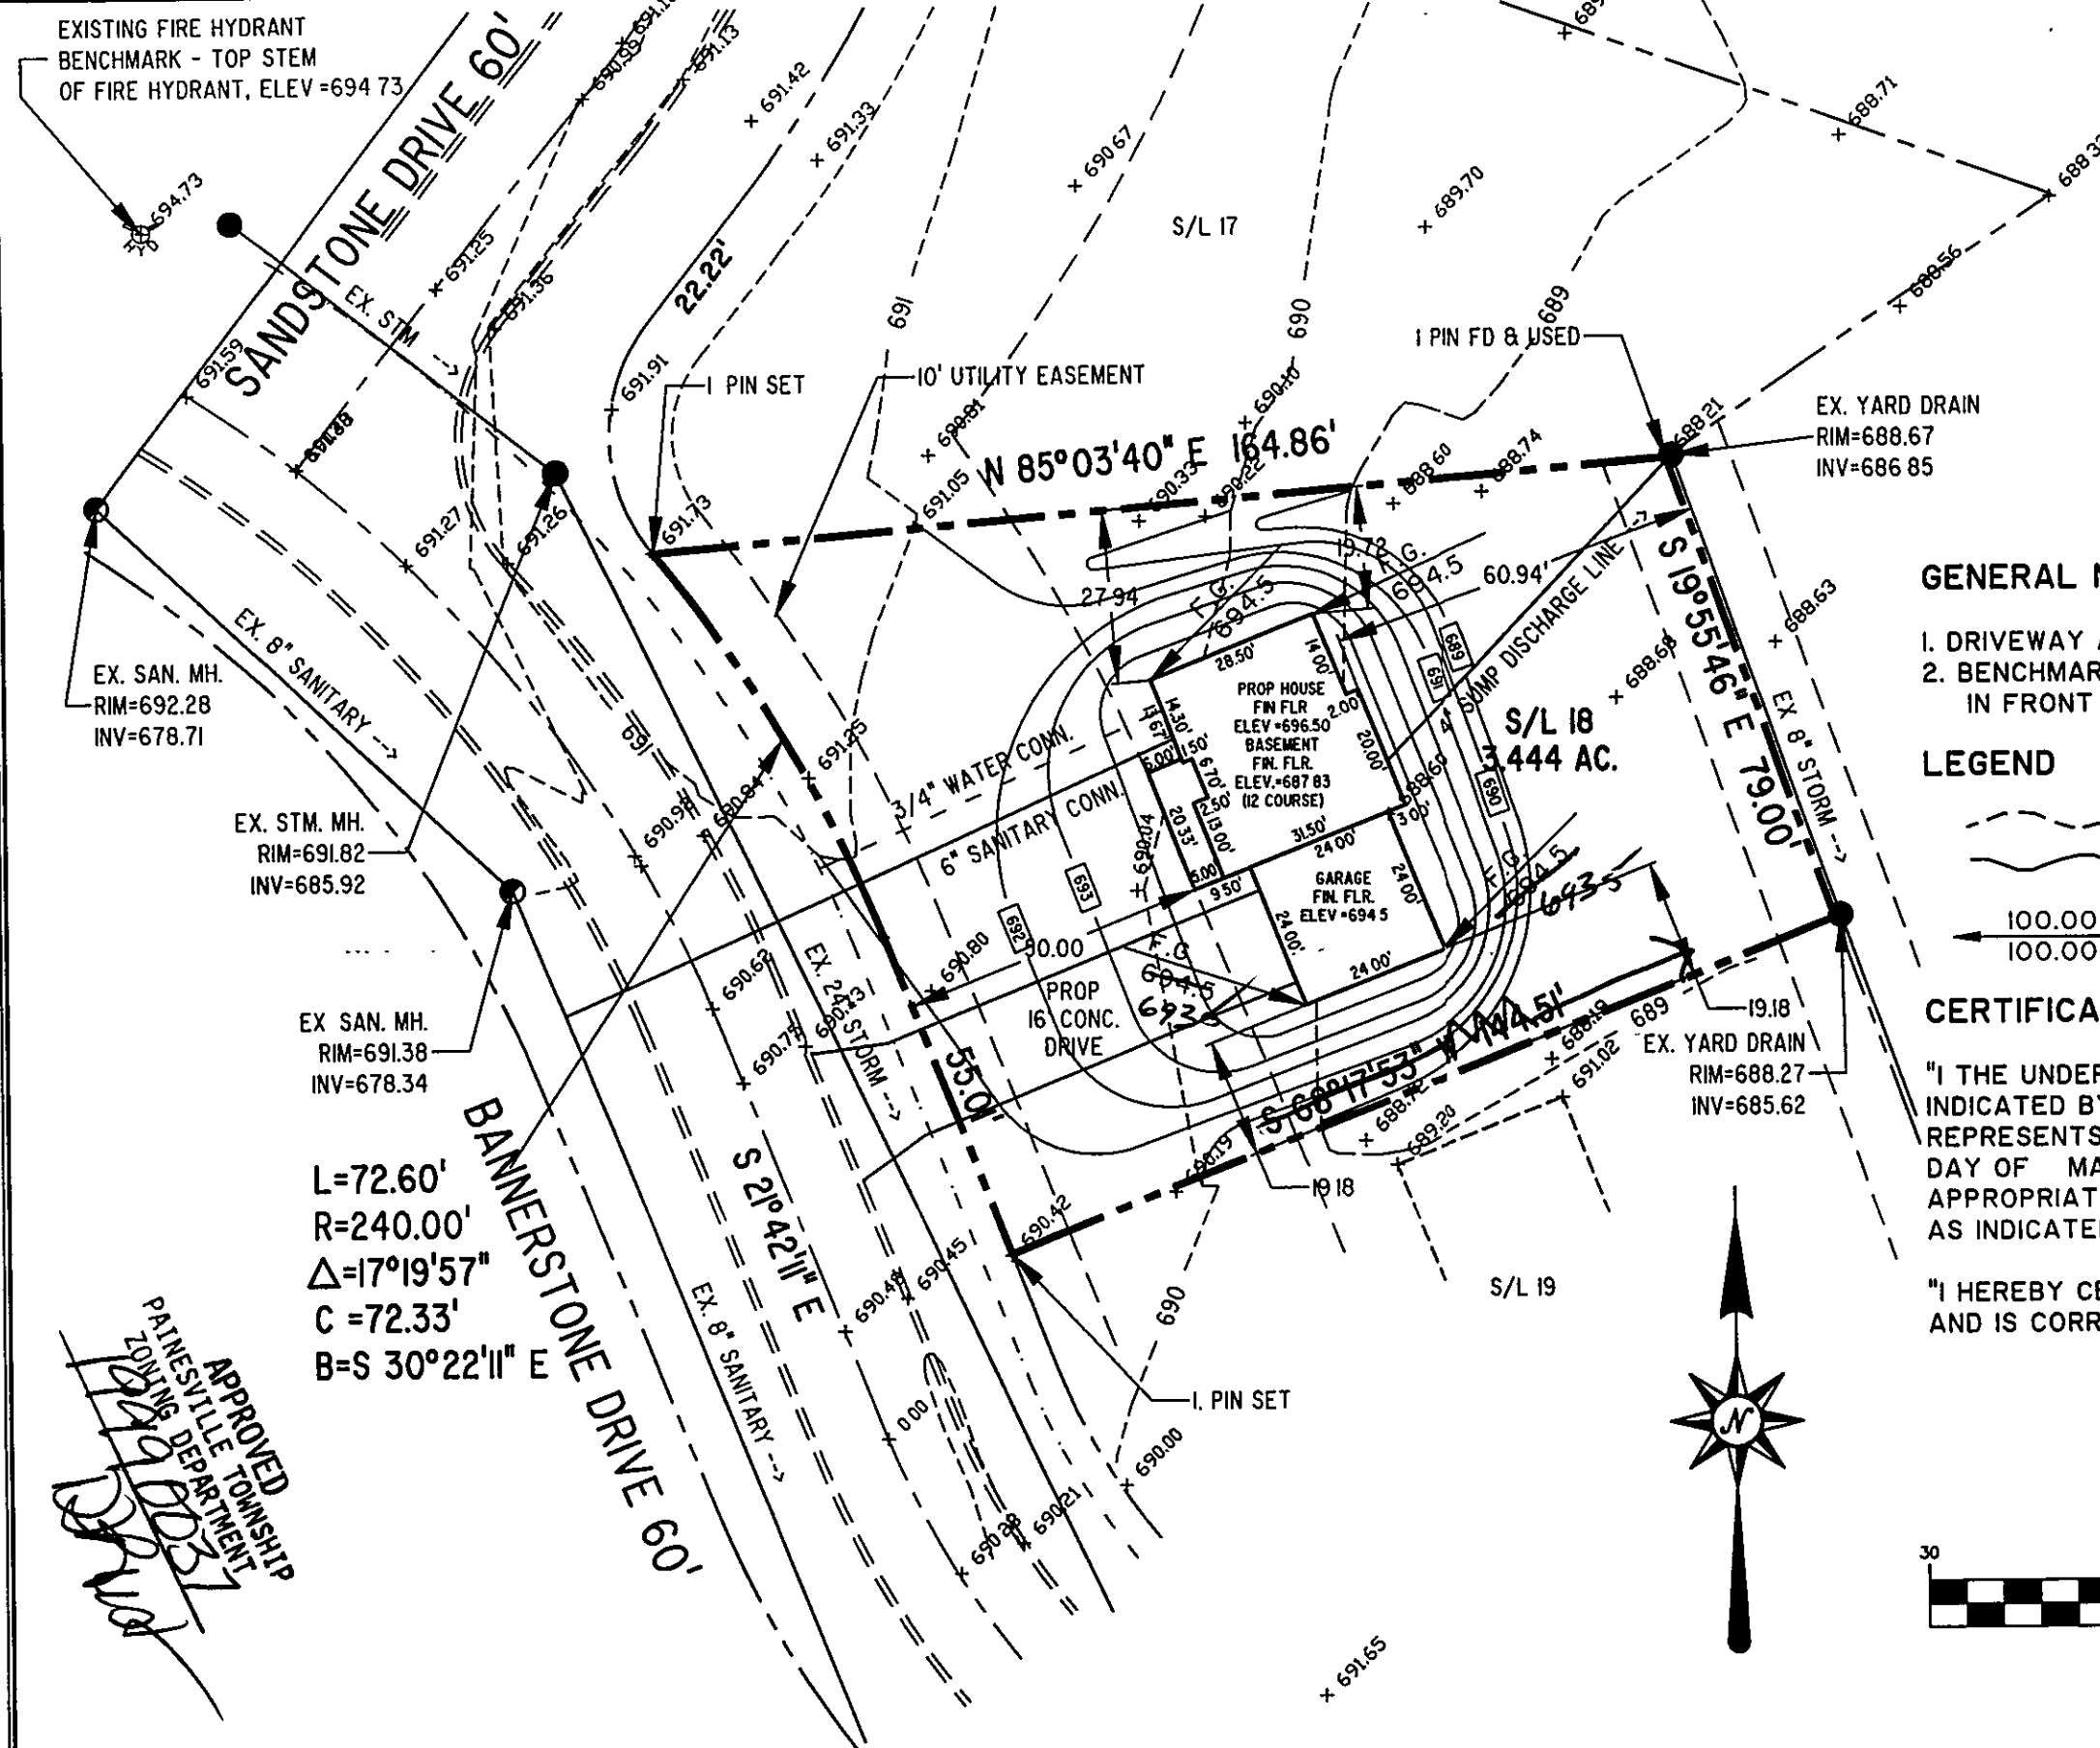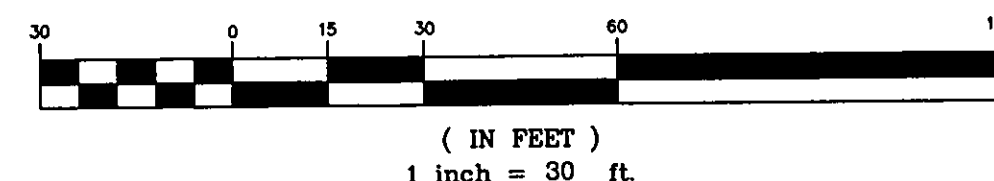

APPROVED
PAINESVILLE TOWNSHIP
ZONING DEPARTMENT
[Signature]

REV.	DESCRIPTION	DATE	BY	CHK'D.

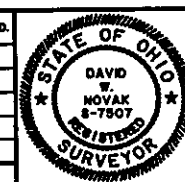

Himebaugh and Novak
Surveyors and Site Consultants
38342 Western Parkway, Unit 10
Willoughby, Ohio 44094
(440) 946-1761, (440) 918-0486 Fax.

LITTLE MOUNTAIN HOMES, INC.
1447 NORTH RIDGE ROAD, PAINESVILLE, OH 44077

DATE:	MAR. 18, 1999
DRAWN BY:	DW NOVAK
CHECKED BY:	DWN
APPROVED BY:	
P.L. No.	

SITE PLAN
SUBLOT 18, BANNERSTONE DR., EASTERN WOODLANDS, PHASE I, VOL. 34-17

SCALES:	
HORIZ. 1" = 30'	
VERT. 1" = 10'	
CONTRACT No.	
99022-18	
SHEET No.	OF