


Grading Plan Approved
shown and/or noted
T. MAS P. GILLES, P.E.
Lake County Engineer

By TAM Date 5/7/99
Swale as shown

ROOF DRAINS
SHALL DISCHARGE
TO SPLASH BLOCKS.



APPROVED
PAINESVILLE TOWNSHIP
ZONING DEPARTMENT
19990103
D. Novak

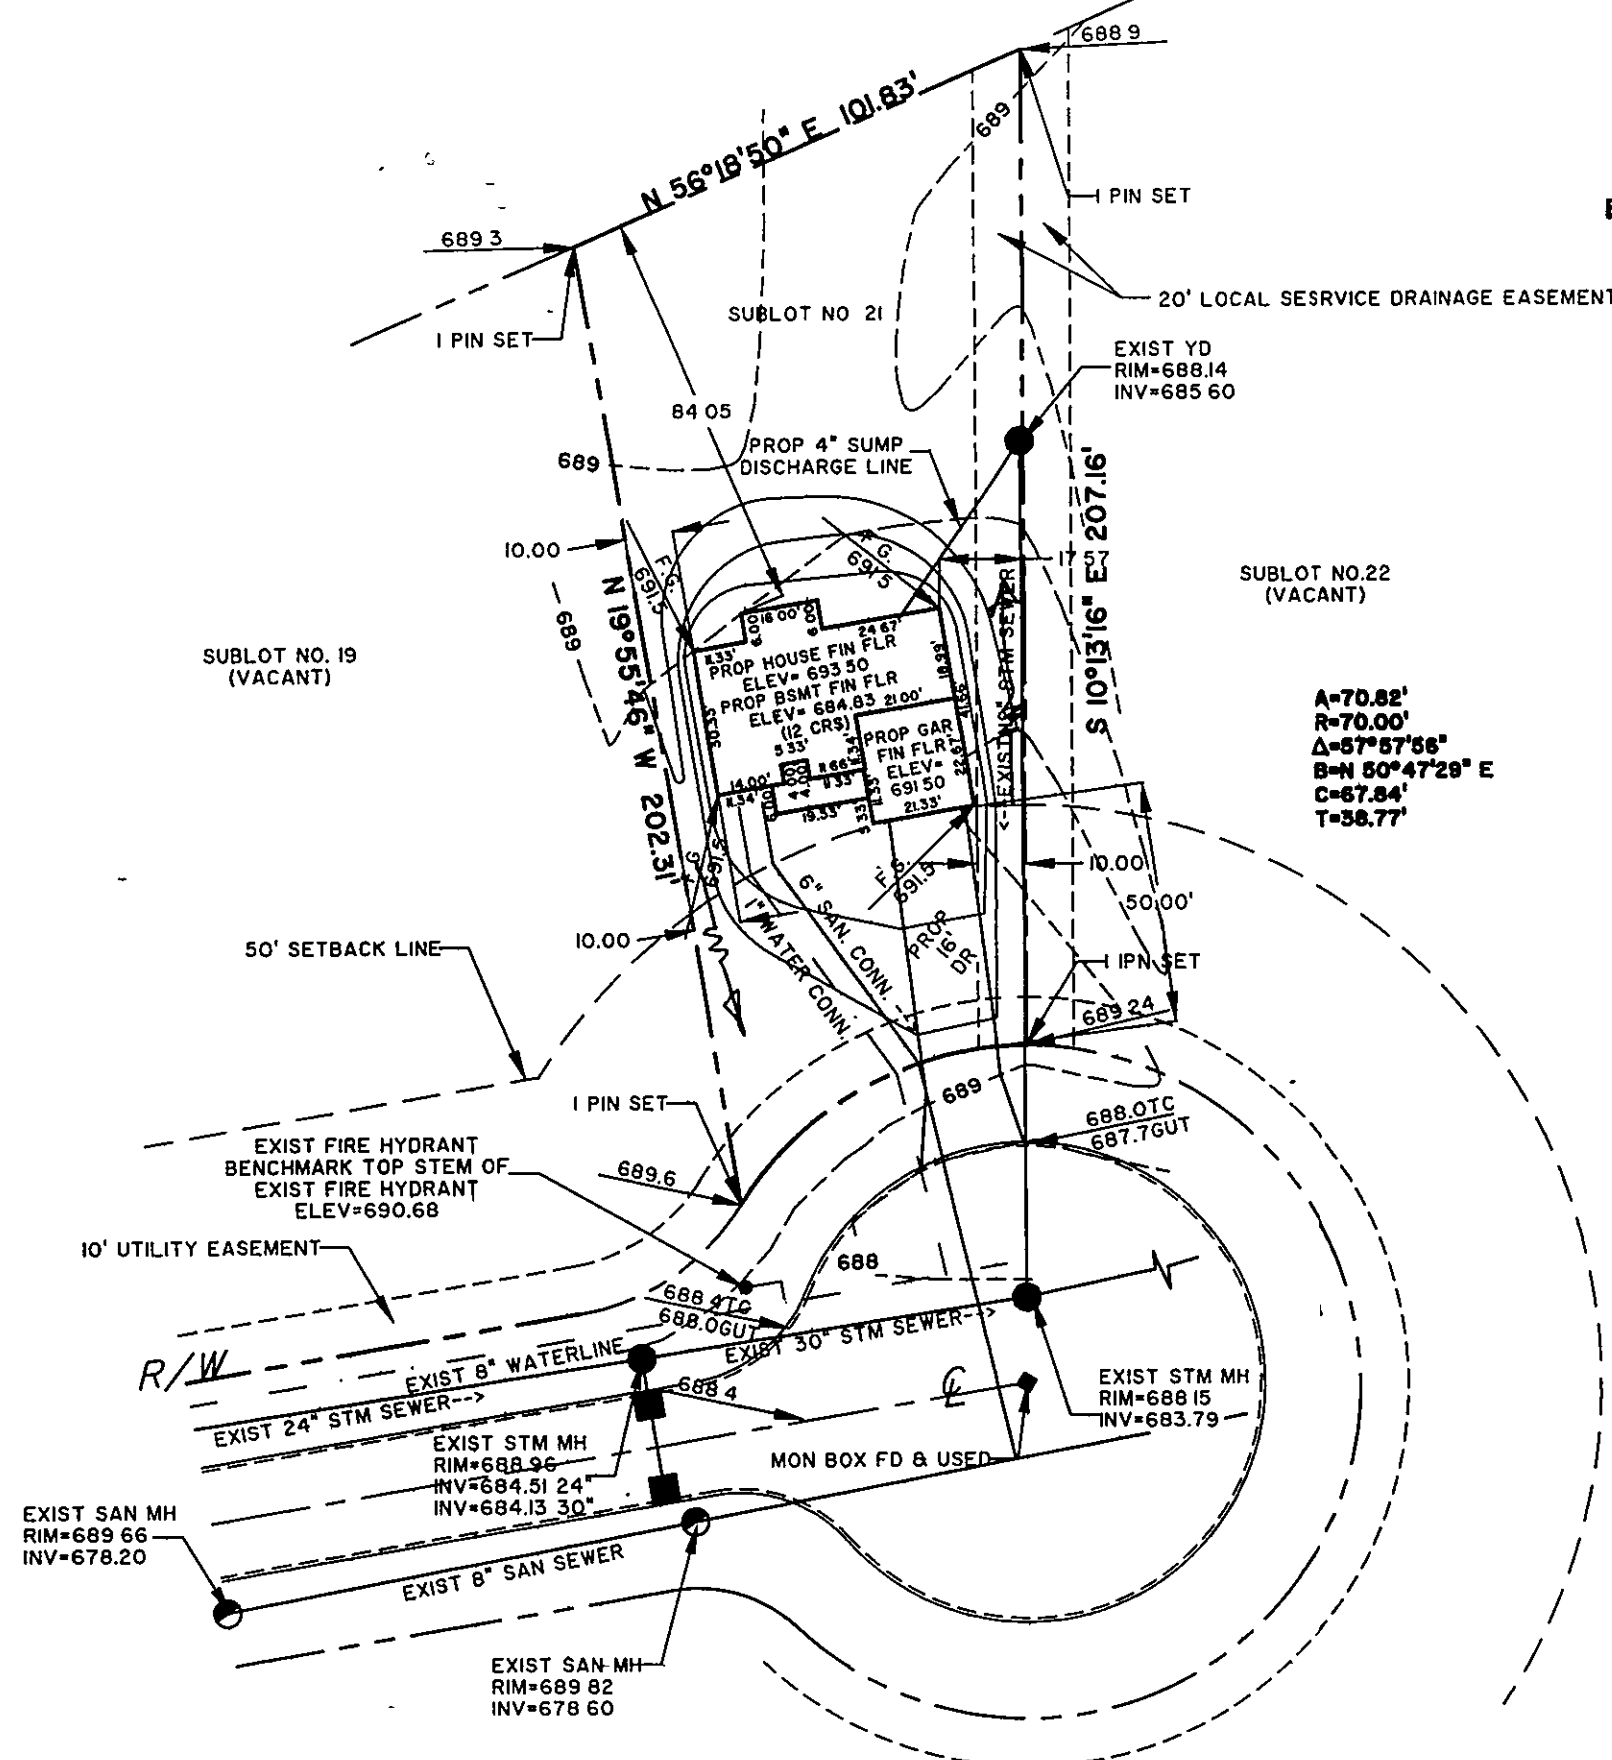

GENERAL NOTES:

1. DRIVEWAY APRON TO BE 6" THICK
2. BENCHMARK - TOP STEM OF FIRE HYDRANT LOCATED IN FRONT OF SUBLOT No.21, ELEV. = 690.68

LEGEND

- EXISTING CONTOUR
- PROPOSED CONTOUR
- EXISTING ELEVATION
- PROPOSED ELEVATION


CERTIFICATION

"I THE UNDERSIGNED HEREBY CERTIFY THAT THIS TOPOGRAPHY INDICATED BY 'I' CONTOURS AND ELEVATIONS SHOWN HEREON REPRESENTS AN ACTUAL SURVEY MADE BY ME ON THE 21ST DAY OF APRIL, 1999 AND THE ELEVATIONS WERE TAKEN AT APPROPRIATE INTERVALS AND AS OF THAT DAY THEY EXISTED AS INDICATED HEREON.


"I HEREBY CERTIFY THAT THIS PLAN WAS PREPARED BY ME AND IS CORRECT TO THE BEST OF MY KNOWLEDGE"

David W. Novak
DAVID W. NOVAK, P. S. No. 7507

GRAPHIC SCALE

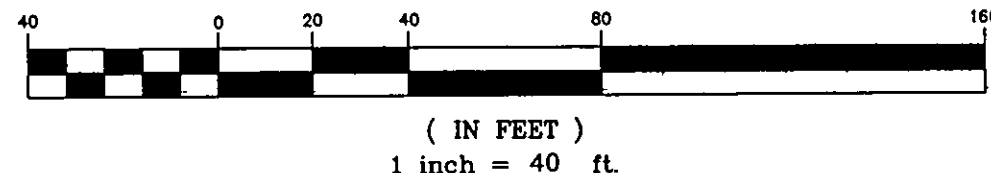

REV	DESCRIPTION	DATE	BY	CHK'D

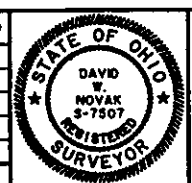

Himebaugh and Novak
Surveyors and Site Consultants
38342 Western Parkway, Unit 10
Willoughby, Ohio 44094
(440) 946-1761, (440) 918-0486 Fax.

GENTRY HOMES
CONCORD OH, 44077

DATE: APRIL 22, 1999
DRAWN BY: C.R. KRAFT
CHECKED BY: DWN
APPROVED BY:
P.E. No. PE

SITEPLAN
BANNERSTONE DRIVE PAINESVILLE, OH. 44077
SUBLOT NO. 21 EASTERN WOODLANDS SUBDIVISION PHASE NO. 1

SCALES:
HORIZ. 1" = 40'
VERT. NONE
CONTRACT No.
99043-21
SHEET No. OF
1 1