


NORTH

BARWICK

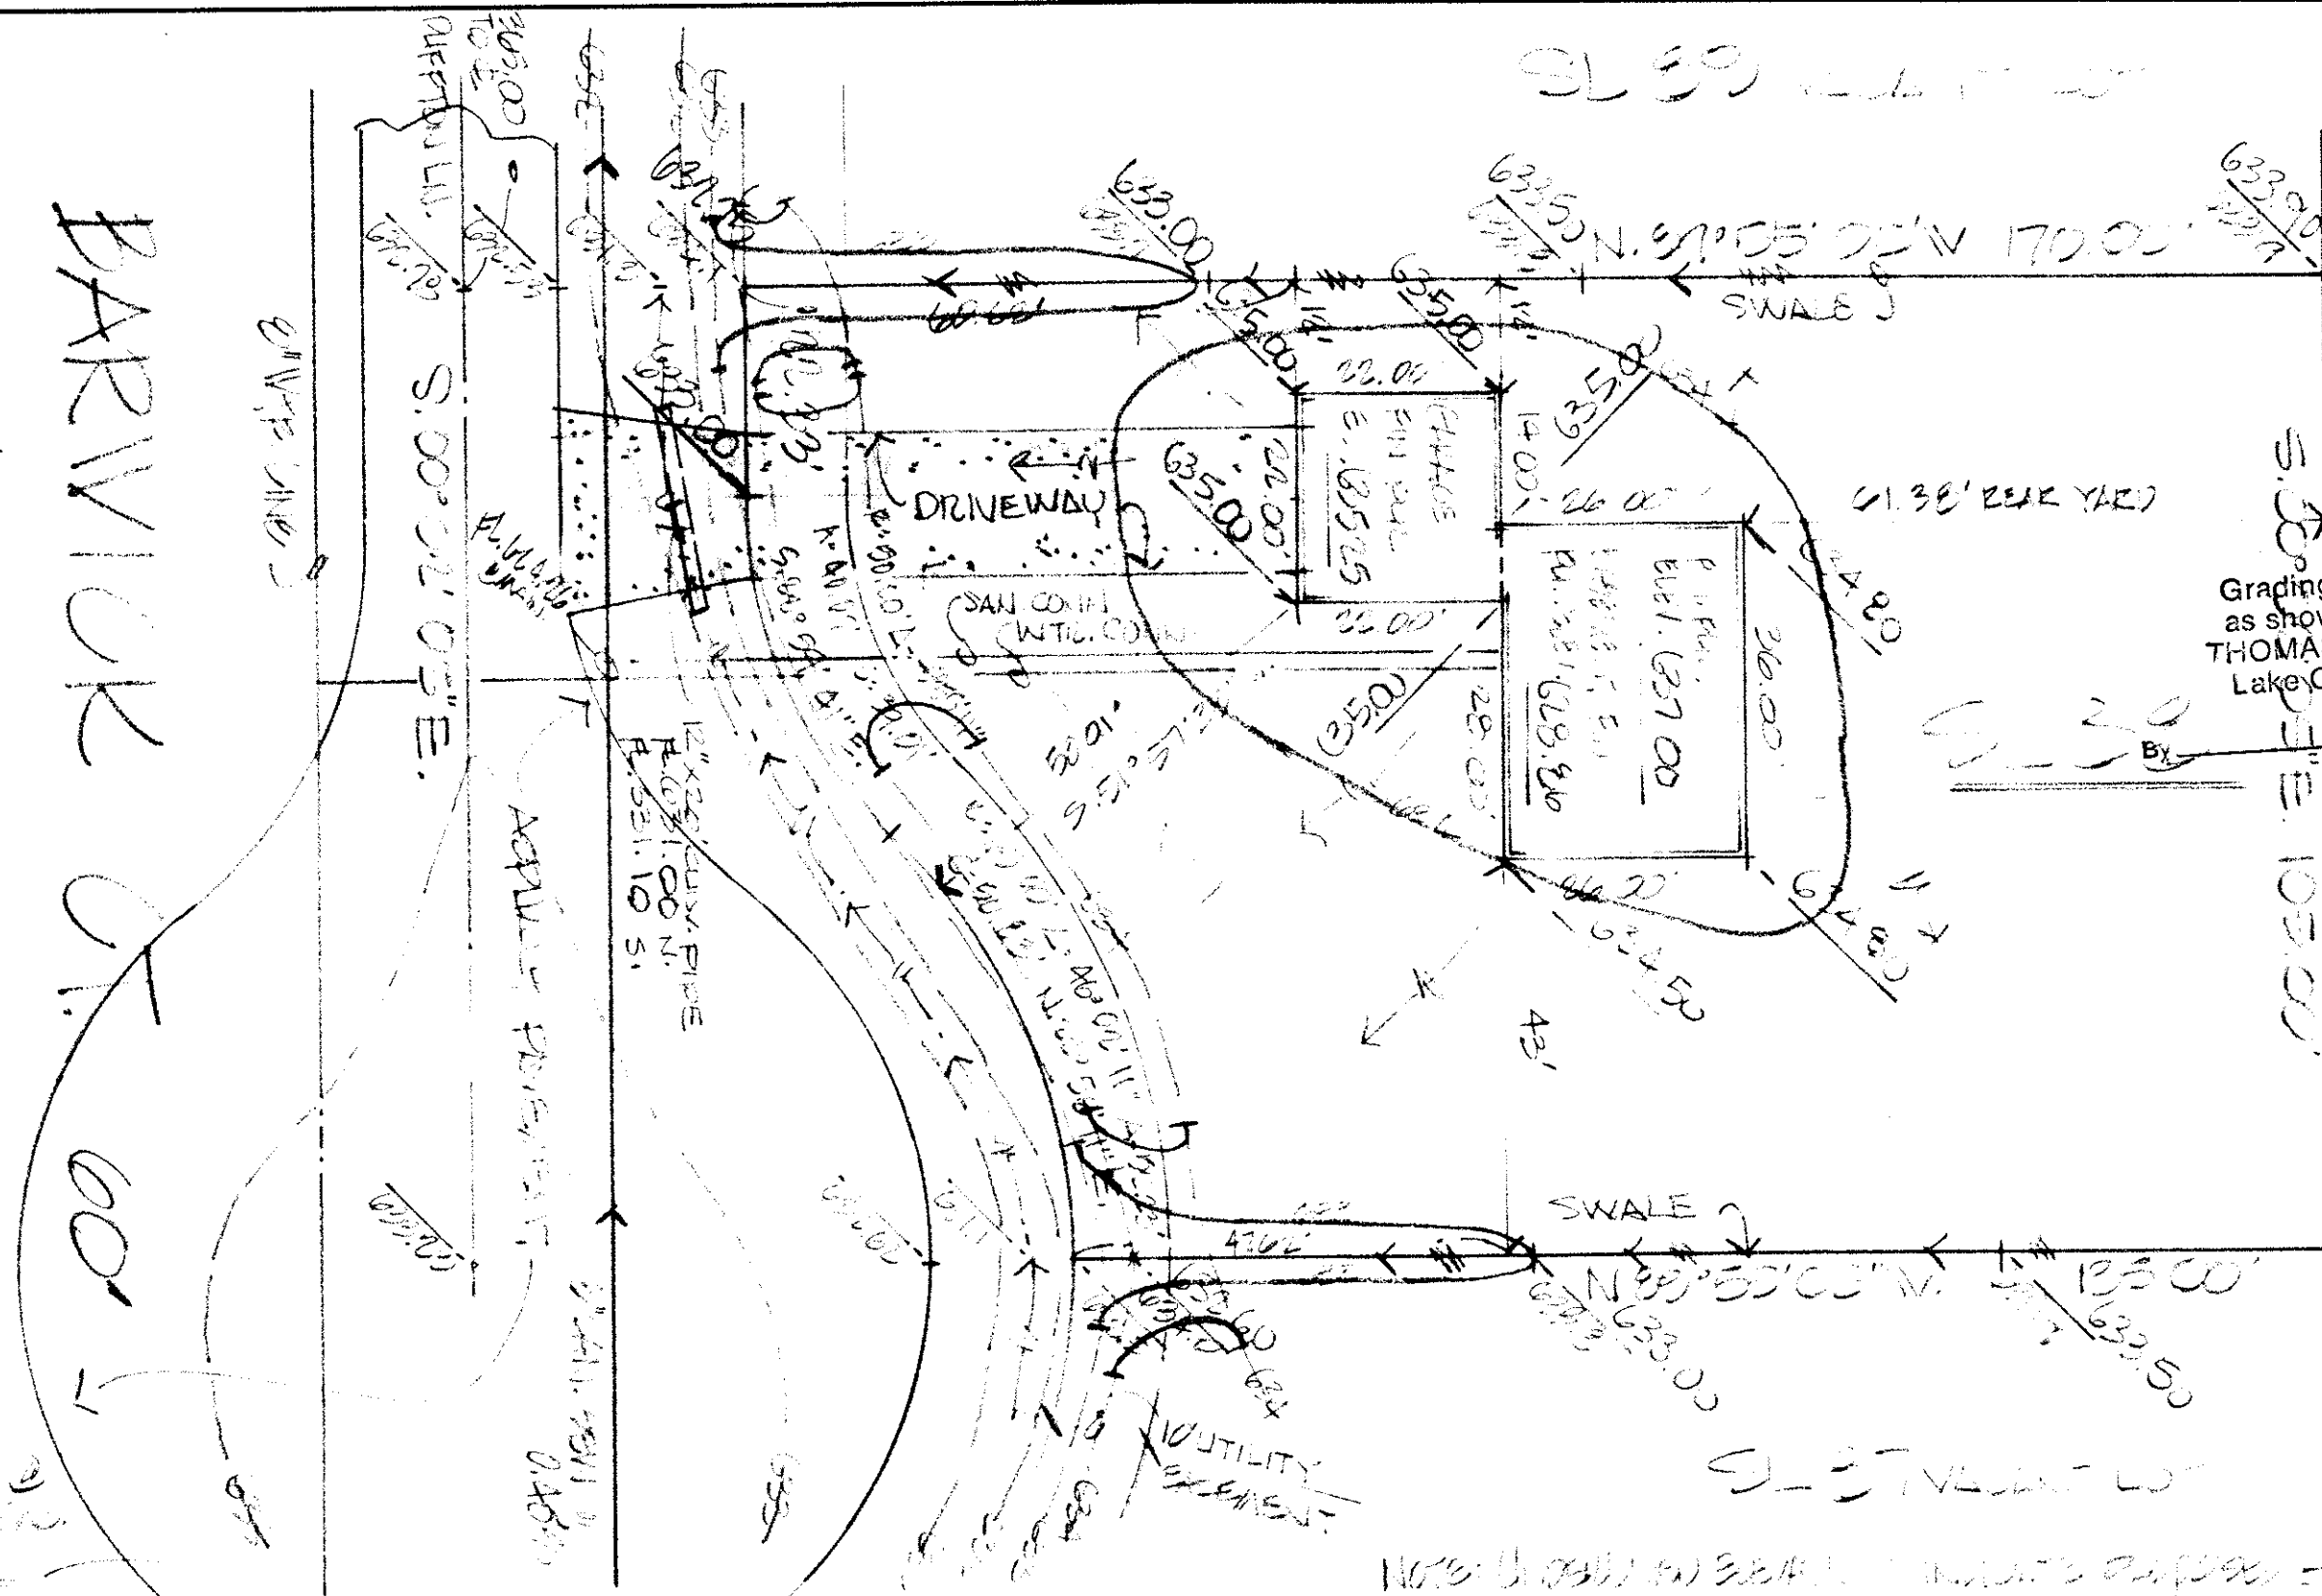

Grading Plan Approved
as shown and/or noted
THOMAS P. GILLES, P.E.
Lake County Engineer

By [Signature] Date 2 Sep 83

This Permit Expires
SEP 1 1984
PAINESVILLE TOWNSHIP
ZONING APPROVED
5824
R. M. Haul
Zoning Inspector
8/31/83

PERMANENT MARK:
TOP OF PILE AND @
END OF CURVE
581.634.47

NOTE: (1) (2) (3) (100)

DESIGN CERTIFICATION THIS PLAT WAS PREPARED BY ME AND IS CORRECT TO THE BEST OF MY KNOWLEDGE AND BELIEF. <u>[Signature]</u> REG. SURVEYOR NO. <u>2488</u>	AS BUILT CERTIFICATION I HEREBY CERTIFY THAT THE CIRCLED GRADES ARE EXISTING FINISH GRADES CHECKED IN THE FIELD ON _____ AND THAT SURVEY IS CORRECT TO THE BEST OF MY KNOWLEDGE AND BELIEF. REG. SURVEYOR NO. _____	COLPETZER · WOODS CONSULTANTS, INC. 9470 MENTOR AVENUE • MENTOR, OHIO 44066 • (216) 357-7569	DATE <u>Aug. 12, 1983</u> SCALE <u>1" = 20'</u> DRWN BY <u>[Signature]</u> CHKD BY <u>[Signature]</u> JOB NO. <u>19.15.133</u> FB _____ PG _____	SITE PLAN FOR: EDWARD H. TRESGER 8100 DEERVOOD BLVD., MENTOR, OHIO. BEING SUBLOT NO. 80 IN THE PINES SUBDIVISION NO. 2 IN PAINESVILLE TWP., OHIO. REG. IN VOL. "Y" PG. 27
--	---	---	---	--