

SITE PLAN


FOR

R.C. REED CONST.

BEING SUBLOT NO. 7, IN THE
HEATHERSTONE VILL. SUBD. AOK.
PAINESVILLE TWP. LAKE COUNTY, OHIO

I, the undersigned hereby certify that
this topography, indicated by 1" contours,
and elevations shown hereon represent
actual field survey made by me on APRIL 14, 1980
and that the elevations were taken at
appropriate intervals and that as of that
date they existed as indicated hereon.

J.M. Coffman
No. 6857

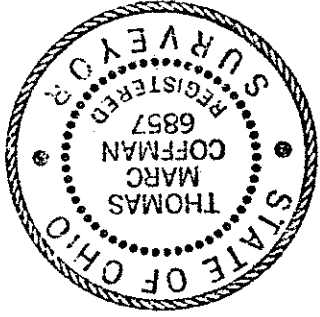

CURVE DATA


I	II	III
Arc	47.26	43.60
Rad	259.11	30.00
Ch	47.19	39.36
B	NS6-05-30W	N13-51W
		N26-12-54E

This Permit Expires

PAINESVILLE TOWNSHIP
ZONING APPROVED

7495
Zoning Inspector

R.C. & S. REED
<House 55' FROM LINE>

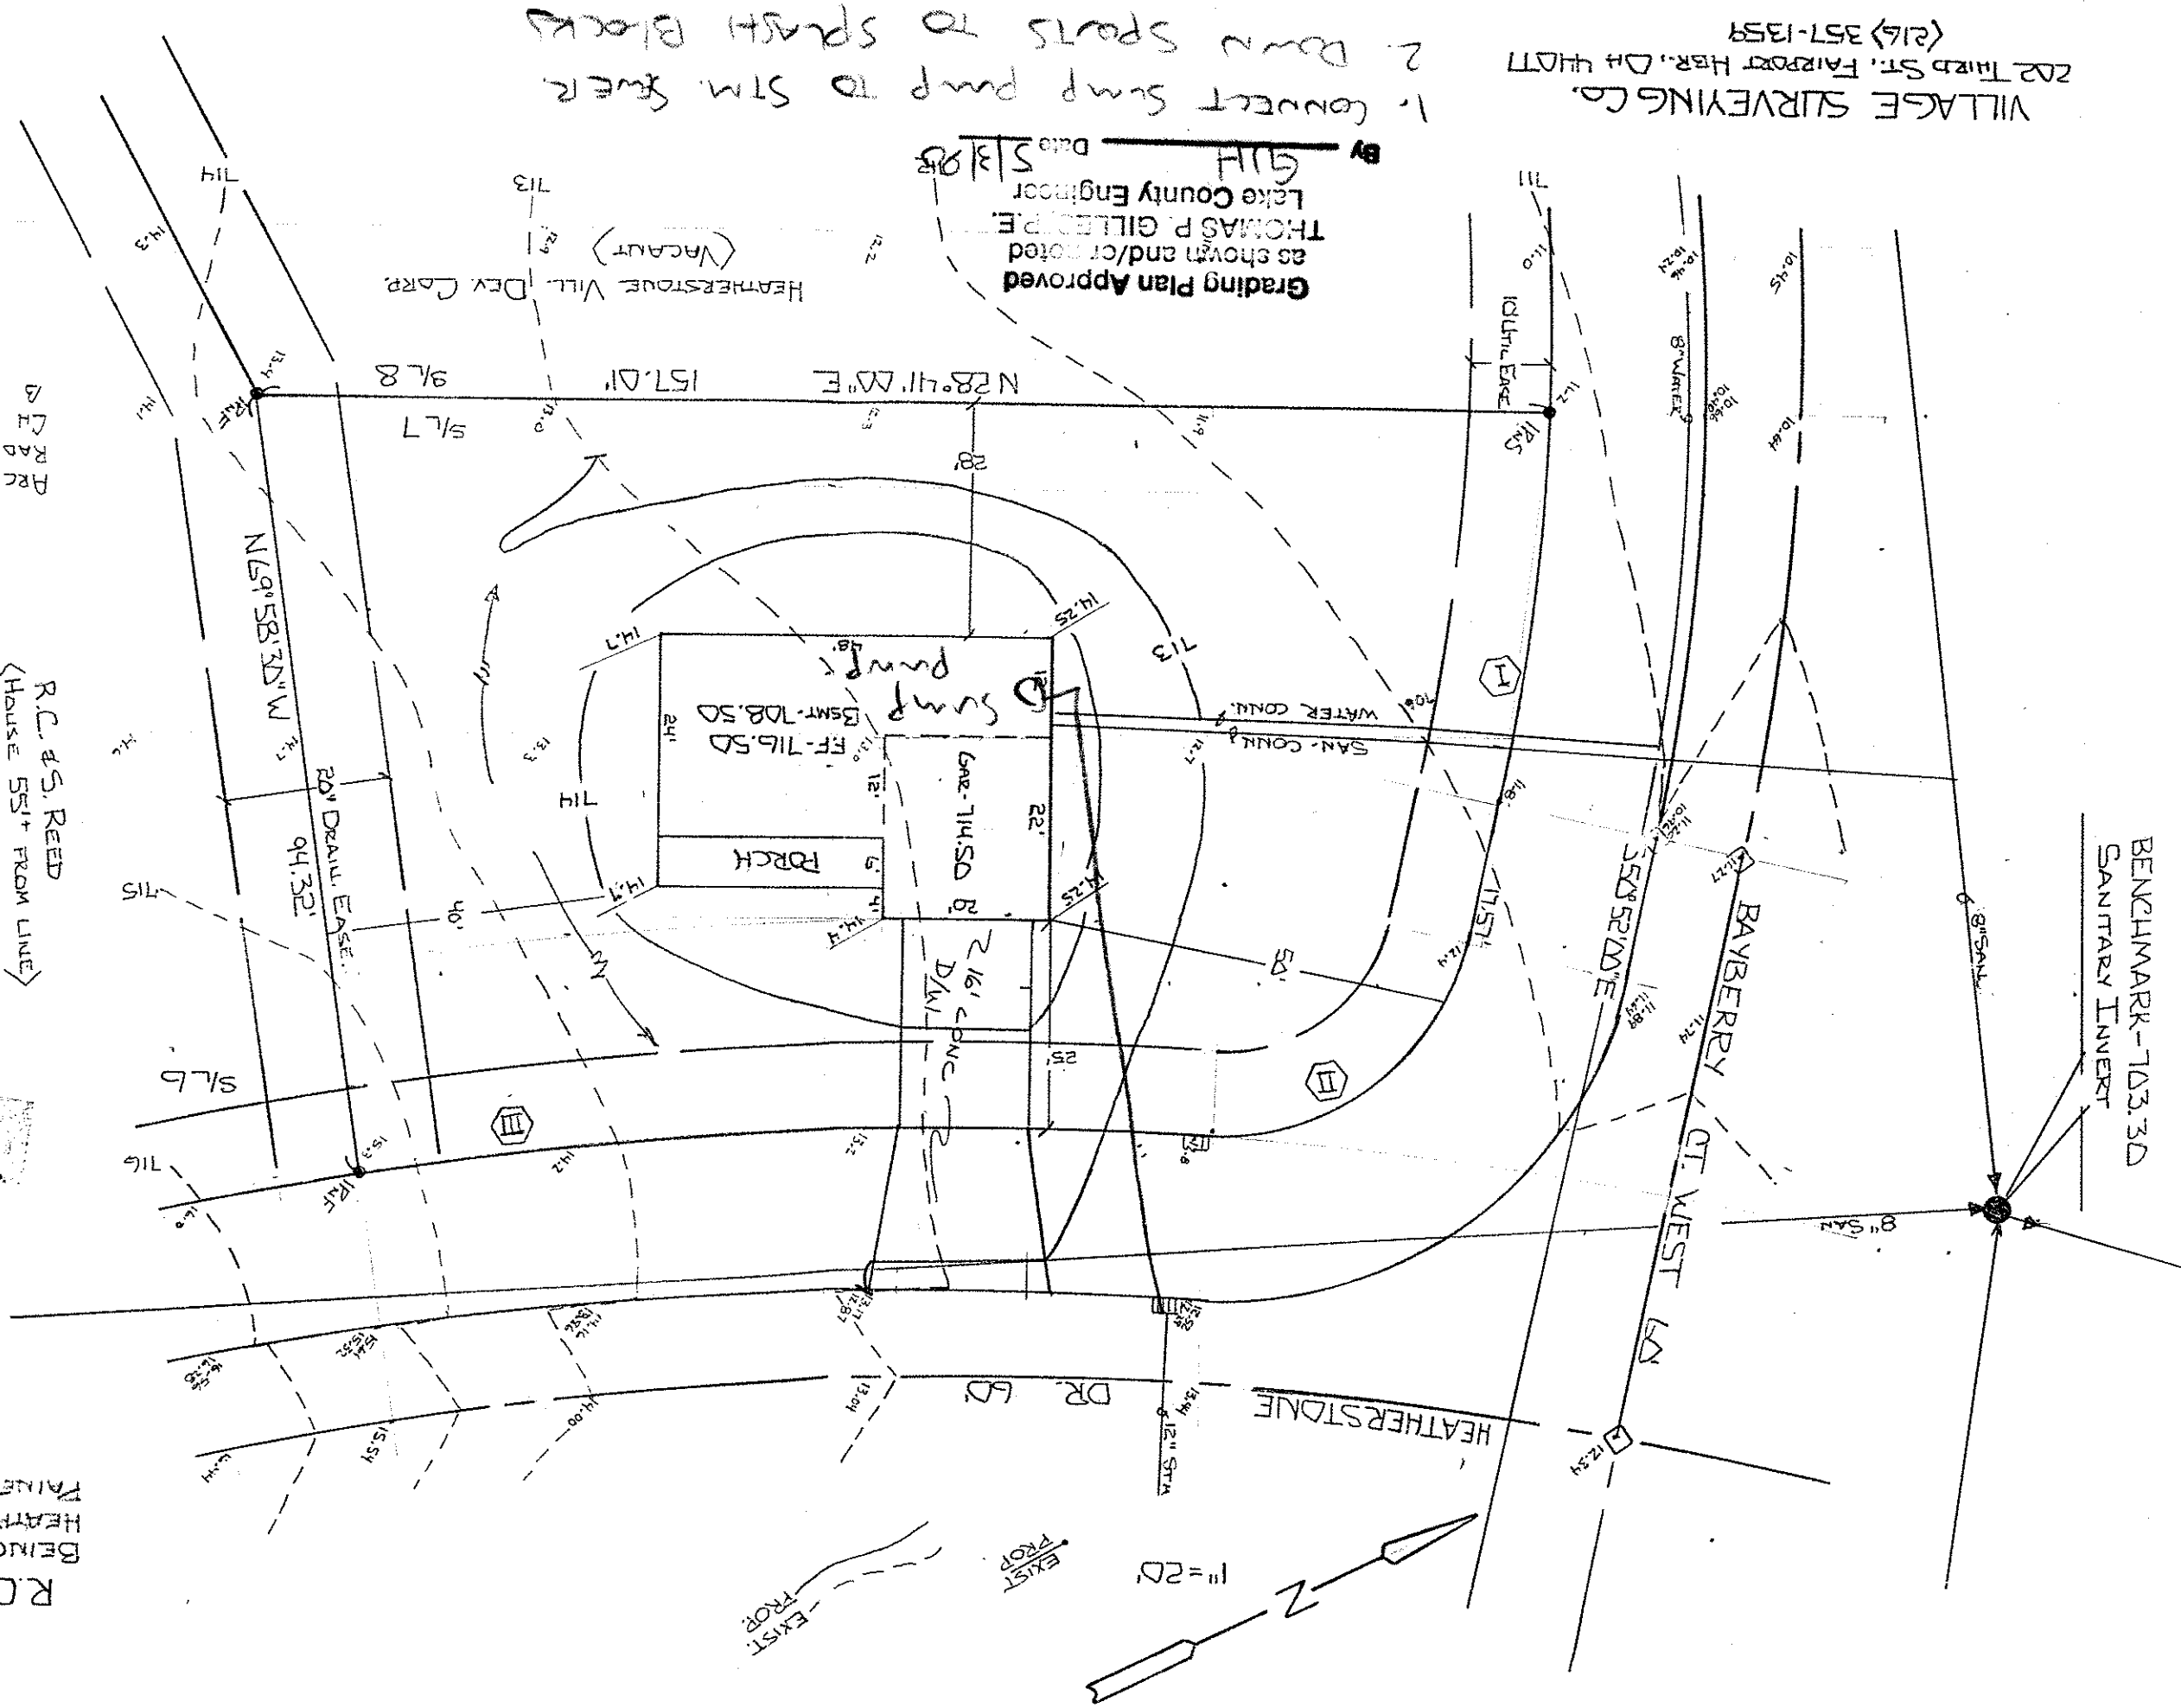

Grading Plan Approved
as shown and/or noted
THOMAS P. GILLESPIE
Lake County Engineer
By G.H. 5/13/88
Date

1. Connect Sump Pump to STM. Sewer
2. Down Spouts to Splash Blocks

VILLAGE SURVEYING CO.
202 THIRD ST., FAIRPORT HBR., OH 44027
(216) 357-1359

BENCHMARK - 103.30
SANITARY INVERT

BAYBERRY CT. WEST LN

HEATHERSTONE

DR. 60

EXIST. PROP.
EXIST. PROP.

