



BENCHMARK - 713.07
NIRM SAN MH INTERSECTION
HEATHERSTONE & BAYBERRY CT
This Permit Expires
7/29/92
PAINESVILLE TOWNSHIP
ZONING APPROVED
7891
D. Duot
Zoning Inspector

SITE PLAN
FOR
R.C. REED CONST.
BEING S/L 9 IN THE HEATHERSTONE
VILLAGE SUB'D NO. 1 IN THE
TOWNSHIP OF PAINESVILLE,
LAKE COUNTY, OHIO.

Grading Plan Approved
as shown and/or noted
THOMAS P. GILLESPIE
Lake County Engineer
By G.H. Date 8/12/91
LOWER FINISH GRADES ONE FOOT.

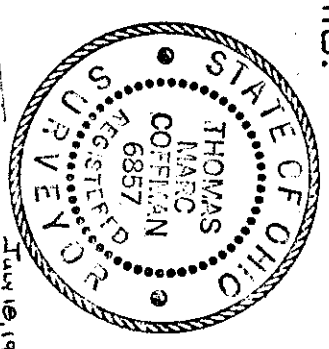

CURVE DATA ①
R = 60.00
A = 40.00
C = 39.27
N 71° 26' 00" W

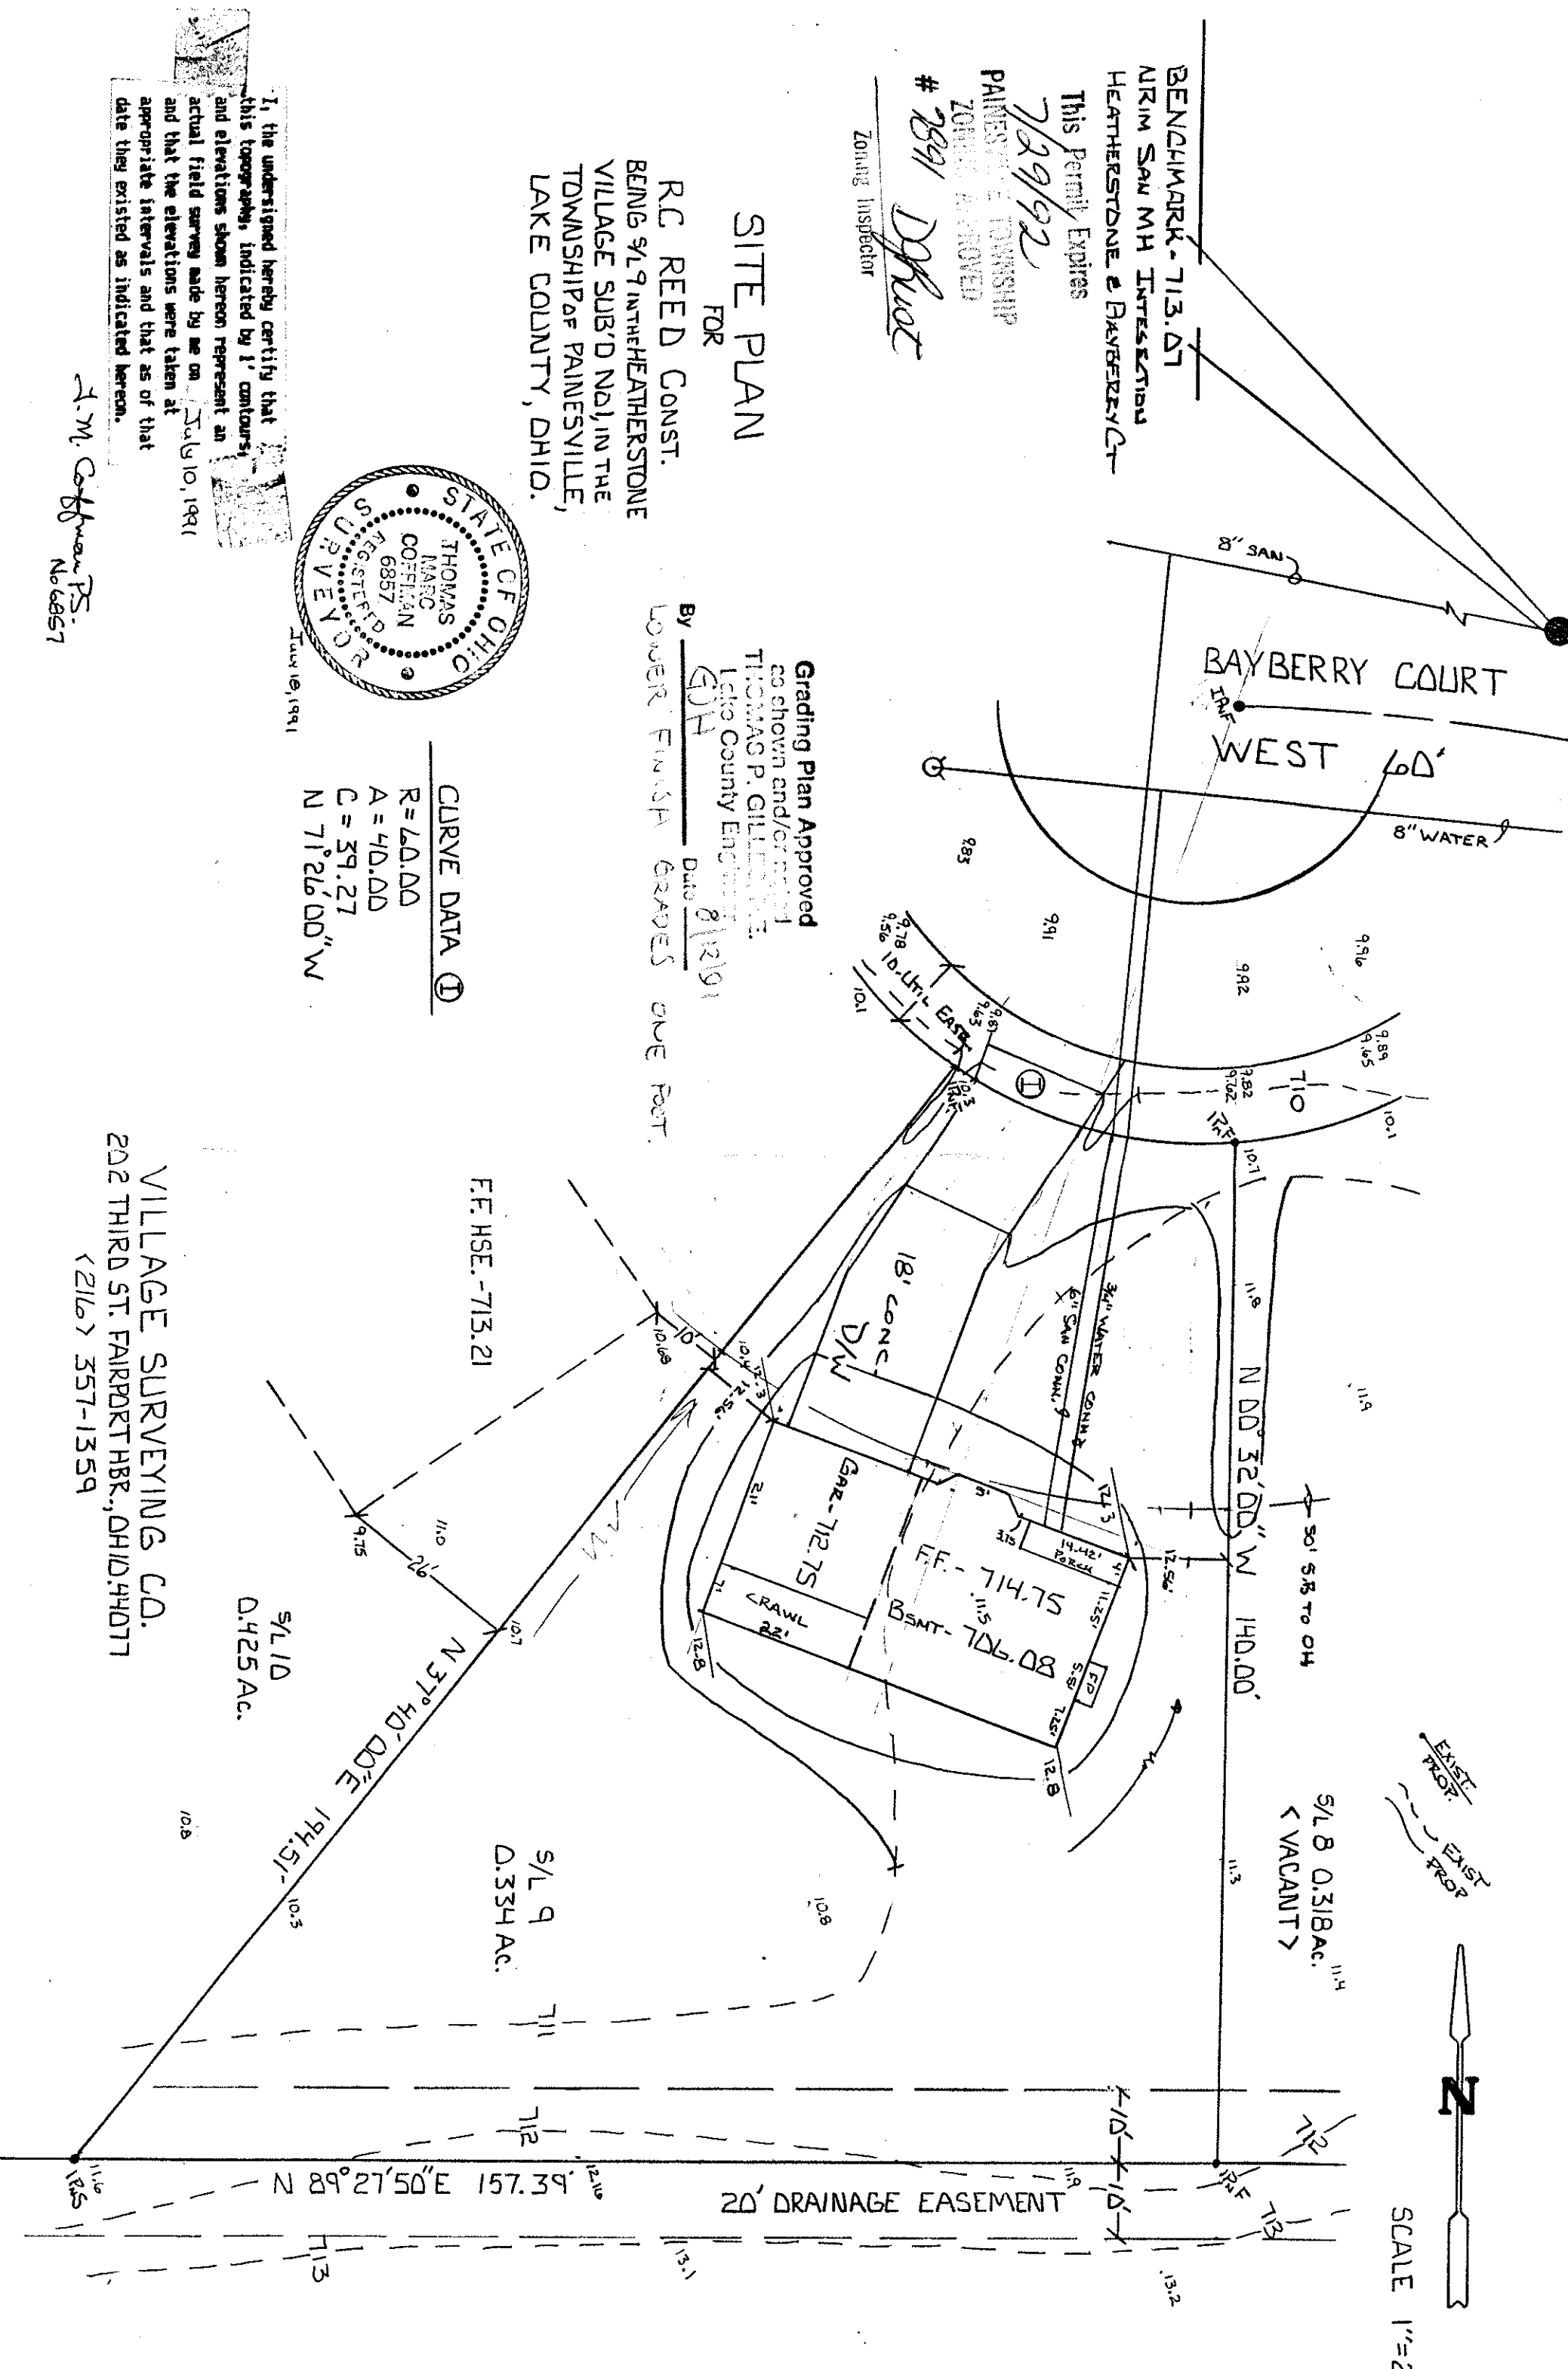

I, the undersigned hereby certify that this topography, indicated by 1' contours, and elevations shown hereon represent an actual field survey made by me on July 10, 1991 and that the elevations were taken at appropriate intervals and that as of that date they existed as indicated hereon.

J.M. Coffman P.E.
No. 6857

VILLAGE SURVEYING CO.
202 THIRD ST. FAIRPORT HBR., OHIO 44077
(216) 357-1359