

SITE PLAN

PAINESSVILLE TOWNSHIP
LAKE COUNTY, OHIO

FOR

M.M. BOGART

DEVELOPMENT CORP.

Recording Plan Approved
as shown and/or noted
THOMAS P. GILLES, P.E.
Lake County Engineer


Date 11/18/87



HEATHERSTONE SUBD.
VOL. 2-35 Pg. 2

LEGEND

- SANITARY MANHOLE
- STORM MANHOLE
- INLET OR CATCH BASIN
- HYDRANT
- EXISTING CONTOUR
- - - PROPOSED CONTOUR
- EXIST. ELEV. 100.0
- AS BUILT ELEVATION
- DIRECTION OF DRAINAGE

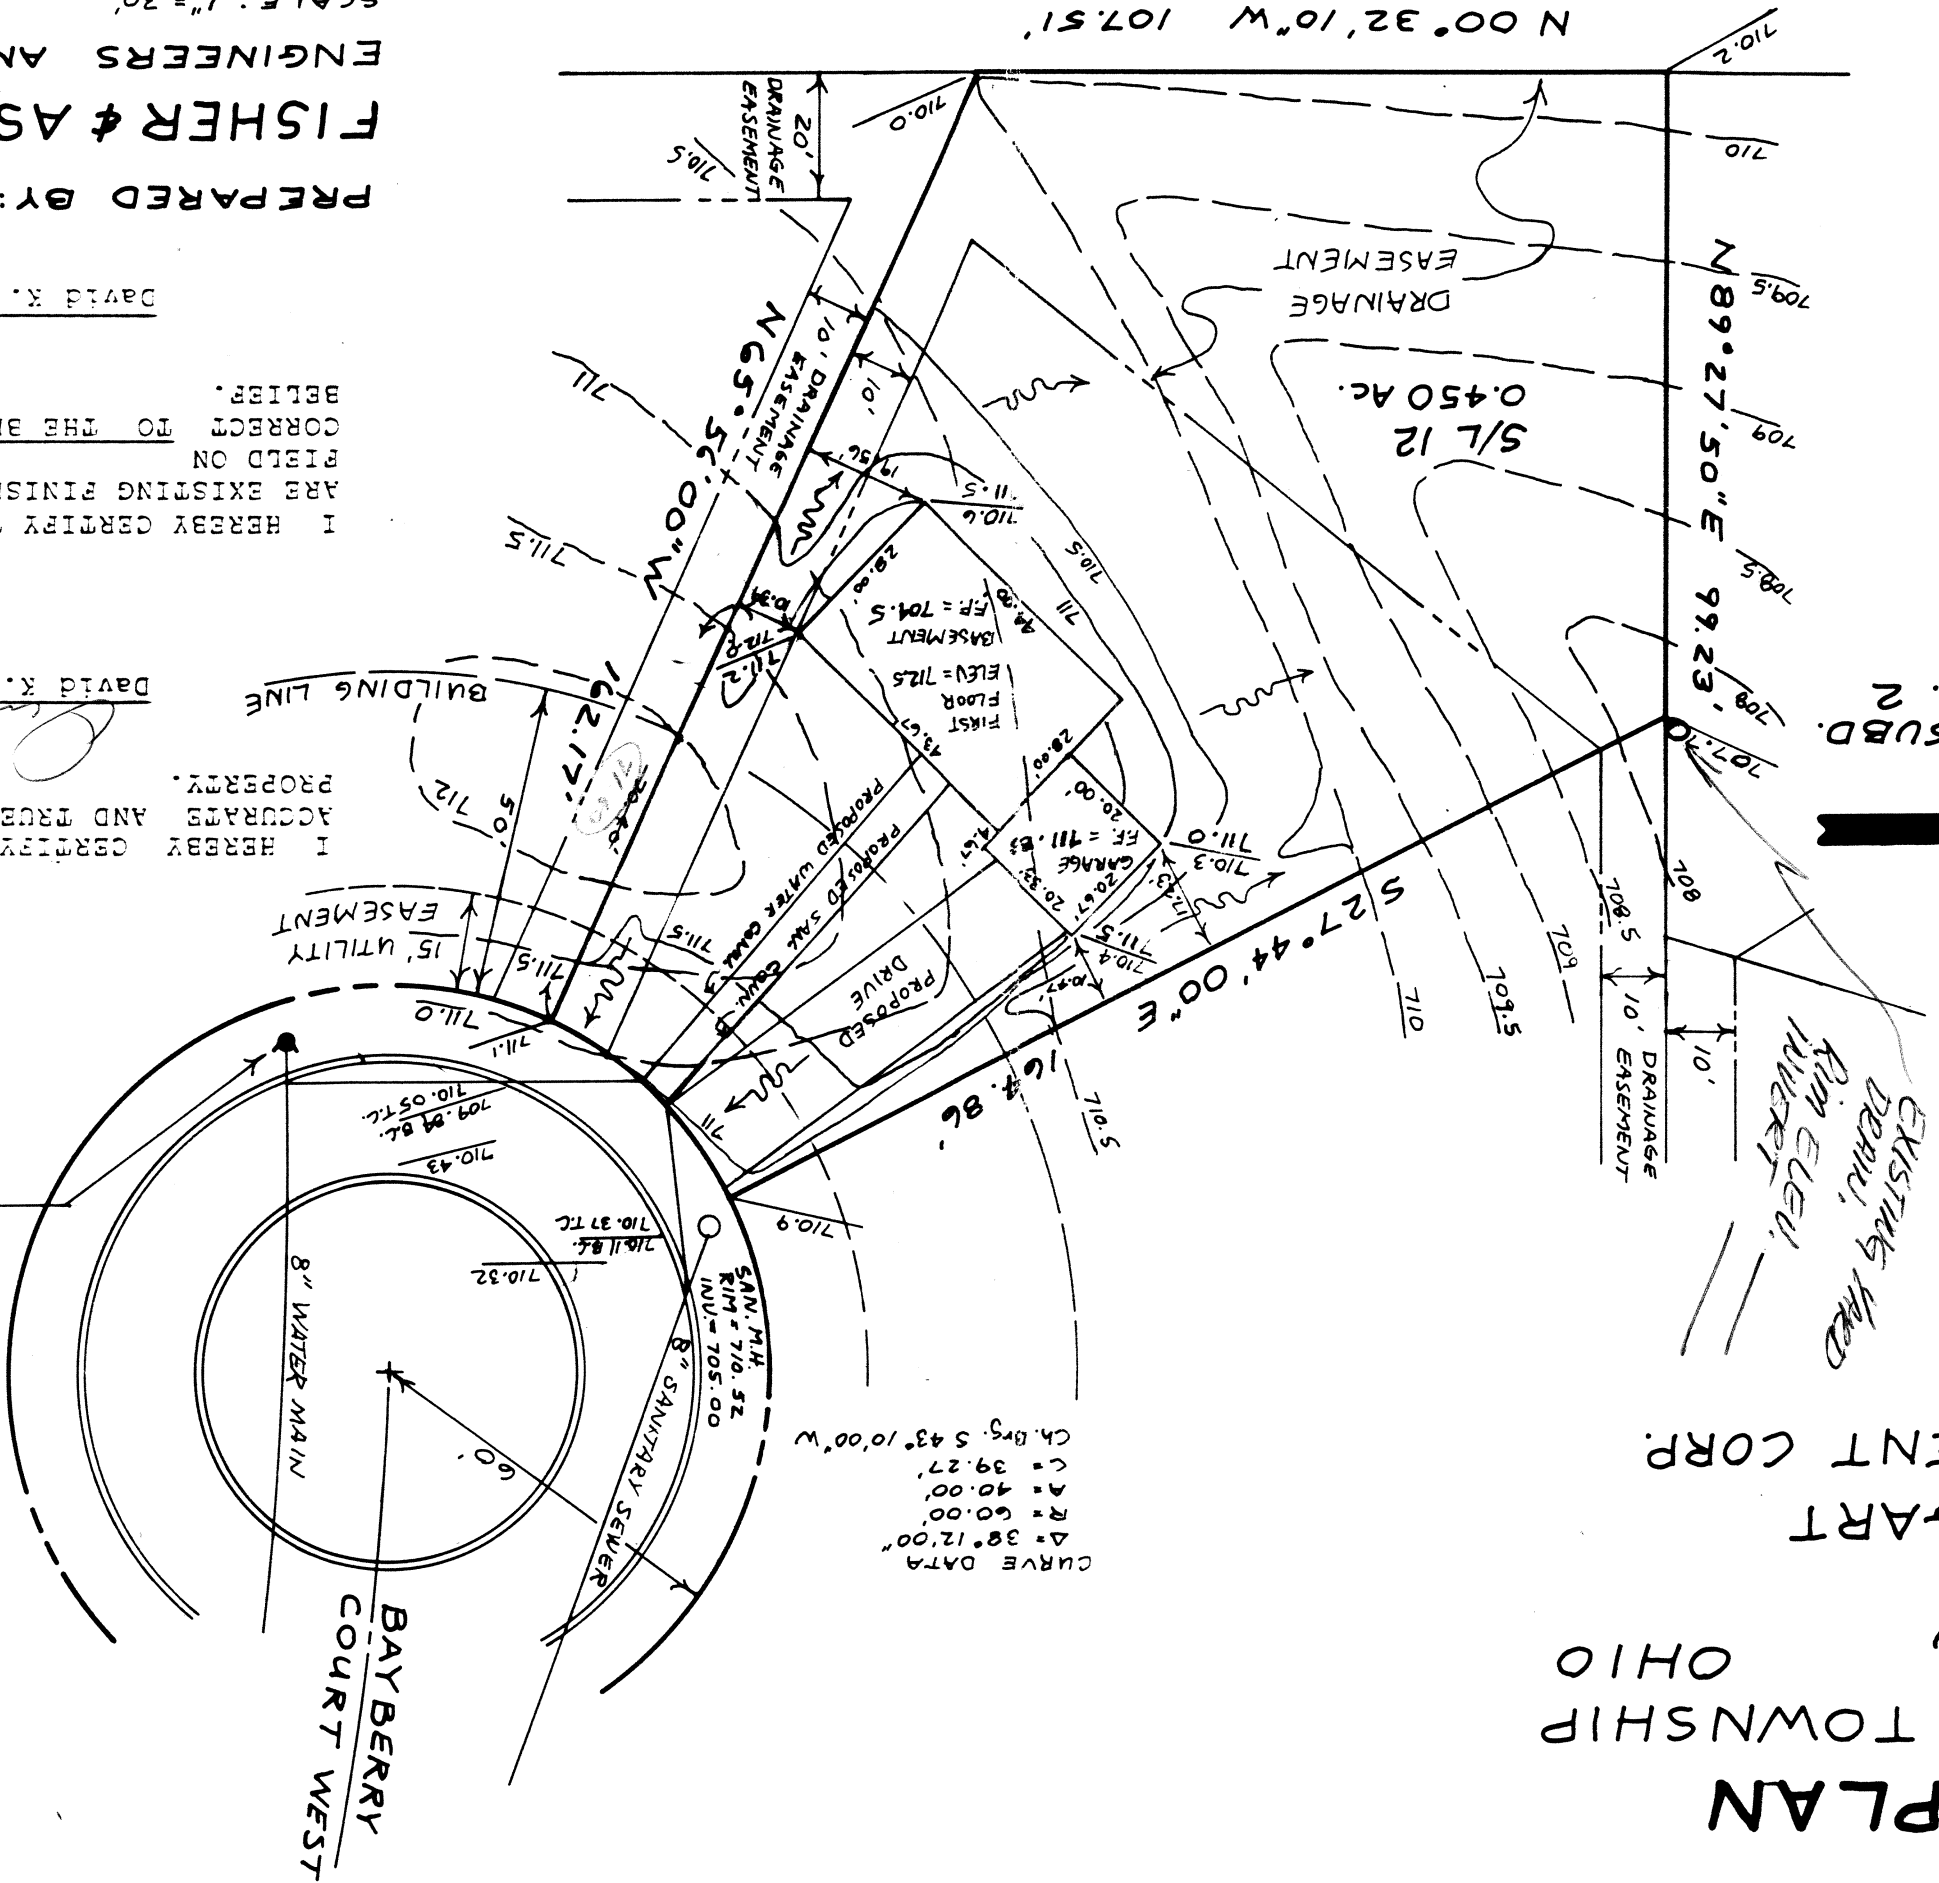

CURVE DATA
Δ = 38° 12' 00"
R = 60.00'
A = 40.00'
C = 39.27'
Ch. Brg. 543° 10' 00" W

SAN. M.H.
RIM = 710.52
INV. = 705.00
8" SANITARY SEWER

BAYBERRY
COURT WEST

8" WATER MAIN

I HEREBY CERTIFY THAT THE CIRCLED GRADES
ARE EXISTING FINISH GRADES CHECKED IN THE
FIELD ON 19 AND ARE
CORRECT TO THE BEST OF MY KNOWLEDGE AND
BELIEF.

I HEREBY CERTIFY THAT THIS PLAN IS AN
ACCURATE AND TRUE REPRESENTATION OF SAID
PROPERTY.


David K. Mostoller
R.S. #6949

David K. Mostoller
R.S. #6949

PREPARED BY:

FISHER & ASSOCIATES INC.
ENGINEERS AND CONSULTANTS

SCALE: 1" = 30'
DATE: NOVEMBER, 1987

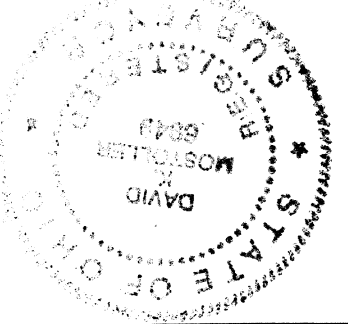

This Permit Expires
11-10-88
PAINESSVILLE TOWNSHIP
ZONING APPROVED
6831
Zoning Inspector 11/10/87